

APPLICATION

A 19561

P _____

SEWAGE DISPOSAL TESTING

STATE OF MARYLAND - DEPARTMENT OF HEALTH AND MENTAL HYGIENE

HOWARD COUNTY HEALTH DEPARTMENT
ENVIRONMENTAL HEALTH SERVICES
P. O. BOX 476, ELLICOTT CITY, MARYLAND 21043
TELEPHONE: 465-5000, EXT. 358

DISTRICT 5

DATE 2/13/74

TO: THE COUNTY HEALTH OFFICER
ELLICOTT CITY, MARYLAND

I, HEREBY, APPLY FOR THE NECESSARY TEST IN ORDER TO CONSTRUCT (OR RECONSTRUCT) A SEWAGE DISPOSAL SYSTEM.

PROPERTY OWNER Maurice Jager - Owner
Gilbert S. Blevins and wife (Contract Purchaser)
ADDRESS 13300 Briarwood Drive, Laurel, Md. PHONE 776-8652

PROPERTY LOCATION:

SUBDIVISION _____ LOT NO. _____

ROAD AND DESCRIPTION Hall Shop - approx. 2,000 ft. off Rt. 32 - going South West Rd.

SIZE OF LOT 24 acres TYPE BLDG. 4

IF NOT SINGLE RESIDENCE DESCRIBE _____
NUMBER OF BEDROOMS
(Single Fmly. Dwlg.)

THE SYSTEM INSTALLED UNDER THIS APPLICATION IS ACCEPTABLE ONLY UNTIL PUBLIC FACILITIES BECOME AVAILABLE.

SIGNATURE OF APPLICANT Gilbert S. Blevins

APPROVED BY _____ FOR _____ DATE _____
(KIND OF SYSTEM)


REJECTED BY _____ FOR _____ DATE _____
(KIND OF SYSTEM)

HOLD PENDING FURTHER TESTS _____ DATE _____

REASONS FOR REJECTION OR HOLDING _____

THIS IS NOT A PERMIT

APPLICATION

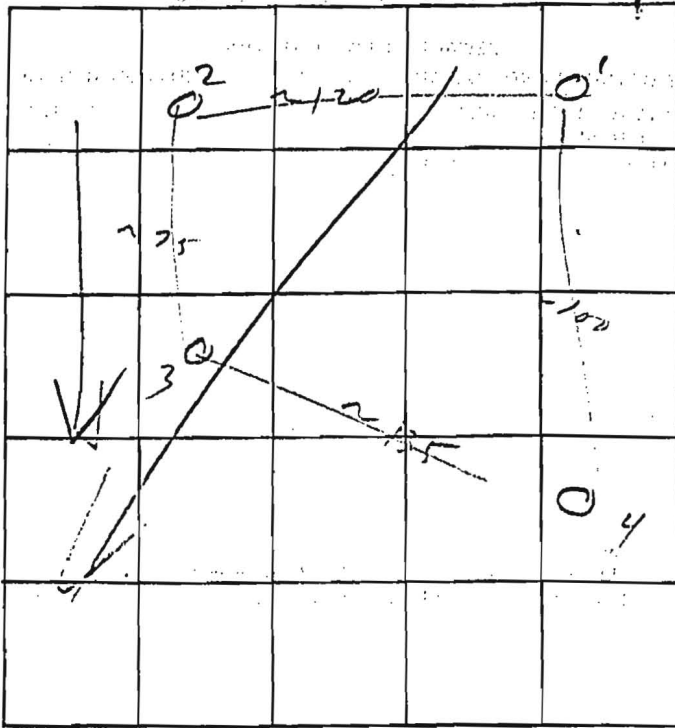

INDICATE NORTH - NAME ADJOINING ROADWAY AS BASE LINE

Hall Street

DATE	TEST NO.	DEPTH	PRE-WET		TEST - 1" DROP		TIME
			START	STOP	START	STOP	
2/15	1	5	10 ⁰⁵	10 ¹¹	10 ⁰⁰	10 ⁰⁷	16
	1A	11 ^{1/2}	10 ¹³	10 ³³	11 ³⁷	11 ⁵⁴	21
	2	11 ^{1/2}	12 ⁰⁴	12 ¹⁵	12 ¹⁵	12 ³⁰	
	3	4	10 ³⁵	11 ⁴²	11 ⁴²	12 ⁰⁶	24
	3A	11	11 ⁵⁰	11 ⁵³	11 ⁵³	11 ¹⁵	22
	4	10	V.S.	clay/loam			

see notes on 02

ready to

REMARKS _____

TYPE OF SOIL loam & clay mix

TESTED BY R. Moffatt

ALSO PRESENT: _____