

10/14/74

209-10-16-74  
170  
RWV

# PERMIT

SEWAGE DISPOSAL SYSTEM

MARYLAND STATE DEPARTMENT OF HEALTH

HOWARD COUNTY

## INDEXED

ELLCOTT CITY

DISTRICT 4th

DATE 6/25/74

20217

17768

William Hopkins

IS PERMITTED TO INSTALL  ALTER

ADDRESS Jennings Chapel Road, Woodbine, Md.

PHONE 489-4711

A SEWAGE DISPOSAL SYSTEM LOCATED AT

SUBDIVISION Lisbon Meadows

ROAD Bellis Drive

LOT 4, Blk. B, Sec. 2

PROPERTY OWNER Fred B. & Ann L. Abeles

ADDRESS Route 1, Woodbine, Md.

SPECIFICATIONS 3 bedrooms

DRAIN FIELD \_\_\_\_\_ DEPTH \_\_\_\_\_ FEET. BOTTOM AREA \_\_\_\_\_ SQ. FT.

SEEPAGE PITS \_\_\_\_\_ ABSORBENT SIDE-WALL AREA \_\_\_\_\_ SQ. FT.

SEPTIC TANK CAPACITY 1000 GALLONS

FOR GARBAGE GRINDER, INCREASE DISPOSAL AREA 22% & TANK CAPACITY 50%.

OTHER DRY WELL - 300 sq. ft. sidewall area below inlet. Dry well inlet to be no deeper than 5 ft. and bottom of dry well to be no deeper than 12 ft. Place the dry well 125 ft. from the front lot line and 106 ft. from the left side of the lot as seen when facing the lot from Bellis Drive. Dry well inlet may be less than 5 ft. deep but absorbent area of dry well must be counted between 5 and 12 ft.

NOTE: ALL PIPE FROM HOUSE TO DRY WELL MUST BE CAST IRON.

PERMIT VOID AFTER THREE YEARS.

NOTE: X INSTALL STAND PIPE ON SEPTIC TANK AND DRY WELL.

PLANS APPROVED BY Raymond Hodges


DATE 9/7/73

FILL SEPTIC TANK AND DISTRIBUTION BOX WITH WATER BEFORE CALLING FOR AN INSPECTION. COVER NO. WORK; UNTIL INSPECTED AND APPROVED.

NEITHER THE HOWARD COUNTY COMMISSIONERS NOR THE HEALTH DEPARTMENT IS RESPONSIBLE FOR THE SUCCESSFUL OPERATION OF ANY SYSTEM.

*[Handwritten signatures and notes in the bottom section of the permit form, including names like 'Raymond Hodges' and dates.]*

17768

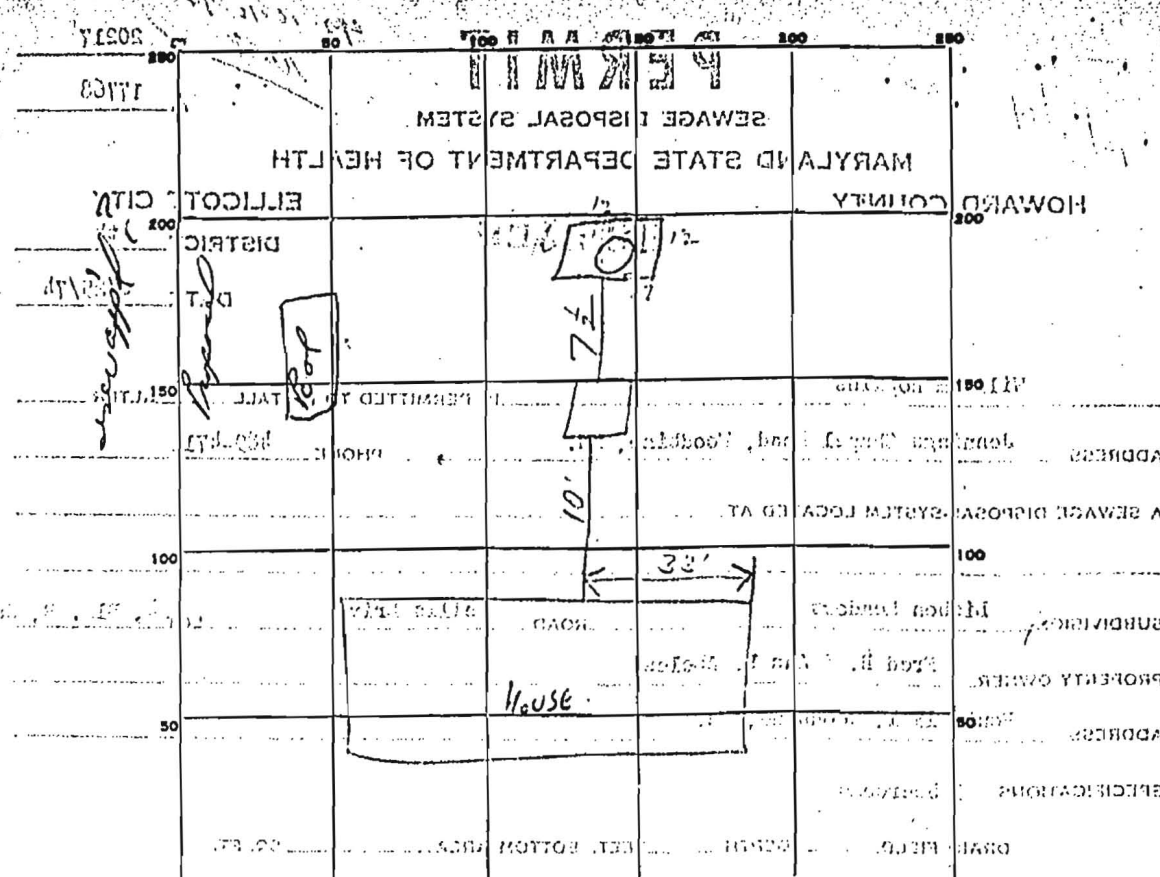

INDICATE NORTH - NAME ADJOINING ROADWAY AS BASE LINE.

PERMIT CARD Permit

SEPTIC TANK, LEVEL yes CLEANOUTS Basement St. Cleanout Cap

DISTRIBUTION BOX, LEVEL N/A

TILE FIELD, DEPTH 0 FT. TRENCH WIDTH 24 FT.

GRAVEL-DEPTH 0 IN. TOTAL LENGTH 20 FT.

NUMBER OF TRENCHES 1 TOTAL BOTTOM AREA 1343 SQ. FT.

SEEPAGE PITS, INSIDE-DIAMETER 4 1/2 FT. DEPTH BELOW INLET 7 FT.

ABSORBENT-AREA 1343 SQ. FT.

REMARKS Basement St. Cleanout Cap  
stop all work, py well in wrong location.  
60' off property line instead of 10' off left property line  
(4' short) HV - ovm 10/14/74  
10/14/74 placement septic tank cleanout cap HV

DATE SYSTEM APPROVED 10/14/74 INSPECTOR DW Murray