

# APPLICATION

A 28372

P \_\_\_\_\_

## SEWAGE DISPOSAL TESTING

STATE OF MARYLAND - DEPARTMENT OF HEALTH AND MENTAL HYGIENE

HOWARD COUNTY HEALTH DEPARTMENT  
ENVIRONMENTAL HEALTH SERVICES  
P. O. BOX 476, ELLICOTT CITY, MARYLAND 21043  
TELEPHONE: 465-5000, EXT. 356

DISTRICT 4th

DATE 6/29/78

TO THE COUNTY HEALTH OFFICER  
ELLICOTT CITY, MARYLAND

I, HEREBY, APPLY FOR THE NECESSARY TEST IN ORDER TO CONSTRUCT (OR RECONSTRUCT) A SEWAGE DISPOSAL SYSTEM.

PROPERTY OWNER Fairway Industries, Inc. / Harold Baumgartner

ADDRESS P.O. Box 364, Mt. Airy, Md. PHONE \_\_\_\_\_

PROPERTY LOCATION:

SUBDIVISION Farmington LOT NO. 10, Sec. 1

ROAD AND DESCRIPTION East side of Penn Shop Road

*Handwritten notes:*  
Now #1  
10/2/79  
Not part of submission on final  
11/13/80

SIZE OF LOT 3.25 acres TYPE BLDG. 3 or 4

NUMBER OF BEDROOMS \_\_\_\_\_

IF NOT SINGLE RESIDENCE DESCRIBE \_\_\_\_\_

THE SYSTEM INSTALLED UNDER THIS APPLICATION IS ACCEPTABLE ONLY UNTIL PUBLIC FACILITIES BECOME AVAILABLE.

SIGNATURE OF APPLICANT /s/ Harold Baumgartner

APPROVED BY \_\_\_\_\_ FOR \_\_\_\_\_ DATE \_\_\_\_\_  
(KIND OF SYSTEM)

REJECTED BY \_\_\_\_\_ FOR \_\_\_\_\_ DATE \_\_\_\_\_  
(KIND OF SYSTEM)

HOLD PENDING FURTHER TESTS \_\_\_\_\_ DATE \_\_\_\_\_

REASONS FOR REJECTION OR HOLDING \_\_\_\_\_


# THIS IS NOT A PERMIT

Lot #10

Elevation

④⑩ → ③④ = 6'

Bennett Rd

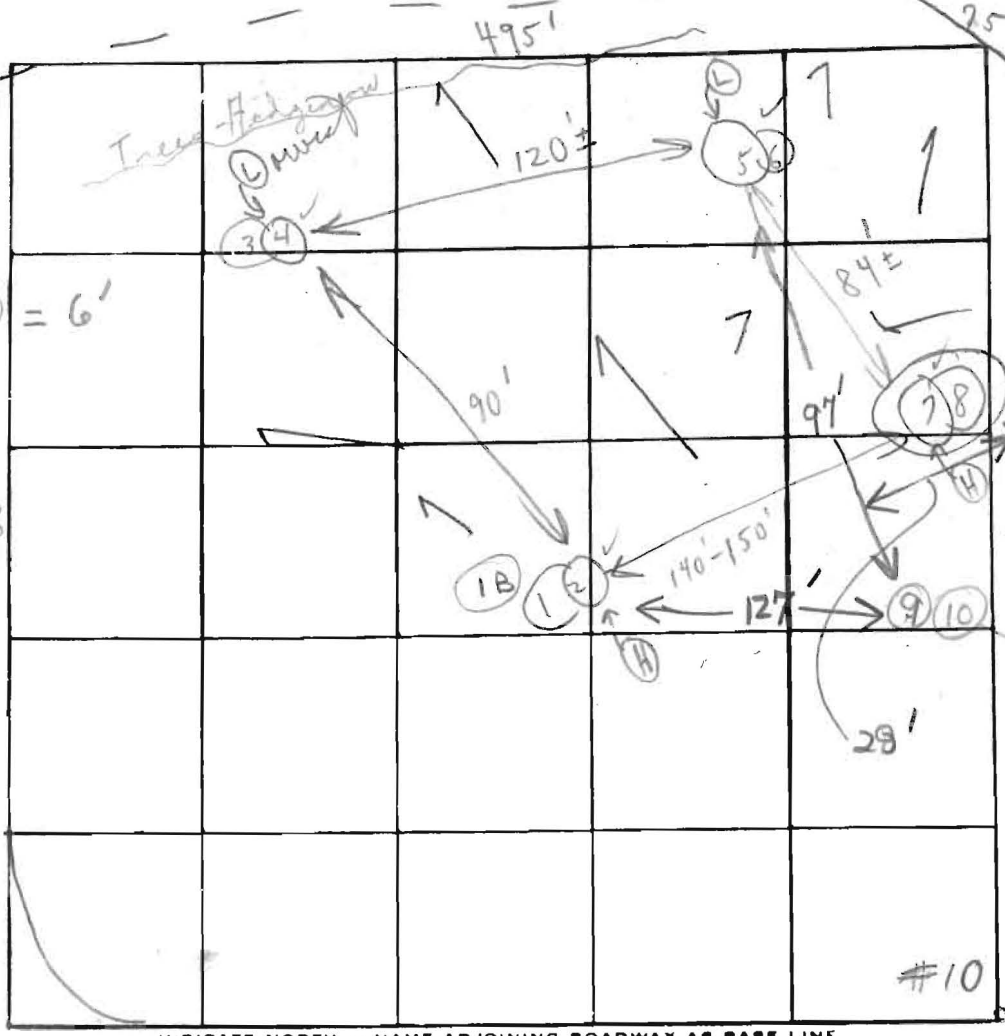

11/6/79 Eliminate  
AM show (9-11)  
D.W.M.  
Field sheet

HARD  
BOTTOM  
HIGH  
HOLE  
6 min core to  
min depth 4'

INDICATE NORTH - NAME ADJOINING ROADWAY AS BASE LINE

Penn Shop Rd

Soil Profile

DATE	TEST NO.	DEPTH	PRE-WET		TEST - 1" DROP		TIME
			START	STOP	START	STOP	
8/17/78	1	5 ft	3:12	3:15	3:15	3:19	4m
	(H) 2	11 1/2'	3:13	3:15	3:15	3:18	3m
	3	4 1/2'	3:21	3:24	3:24	3:30	6m
	4	11'	3:21	3:23	3:23	3:28	5m
	More from 5	3 1/2'	3:02	3:04	3:04	3:10	6m
	L ✓	12 1/2' pt	3:02	3:04	3:04	3:09	5m
	(7) M	4'	2:54	2:56	2:56	2:58	2m
	(8)	12'	2:56	2:59	2:57	2:59	2m
9/8/78	(GLK) 9	3 1/2'	159	204	204	219	15
	10	10 1/2'	155	60 sec	156	201	5
	1B	3 1/2'	211	216	216	226	10

Below  
clay  
weathered  
shale

Perce  
test  
by  
stat

Mud  
Dry at 2:59  
Muddy at 3:00  
Repair  
Mud 3:0  
by

REMARKS

Tests in open field

Hold 4 check with (778)

TYPE OF SOIL

other holes fair  
good test  
times

TESTED BY

C. B. O. + (GLK)

ALSO PRESENT:

Mr. Turner  
Ken Schuler