

MD1207.0296
LOCATION DRAWING
LOT 33
BIG BRANCH OVERLOOK
HOWARD COUNTY, MARYLAND
07-12-2012 SCALE 1"=80'

APPROVED


WALK-THRU BUILDING PERMIT

BP# _____ A# _____


APP. SAN AG DATE: 4/21/14

DESC. OF WORK: 21' x 41'

ingress concrete

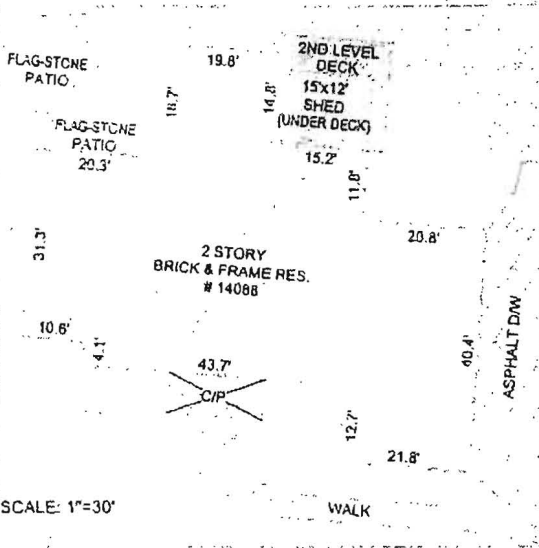


SCALE: 1"=30'

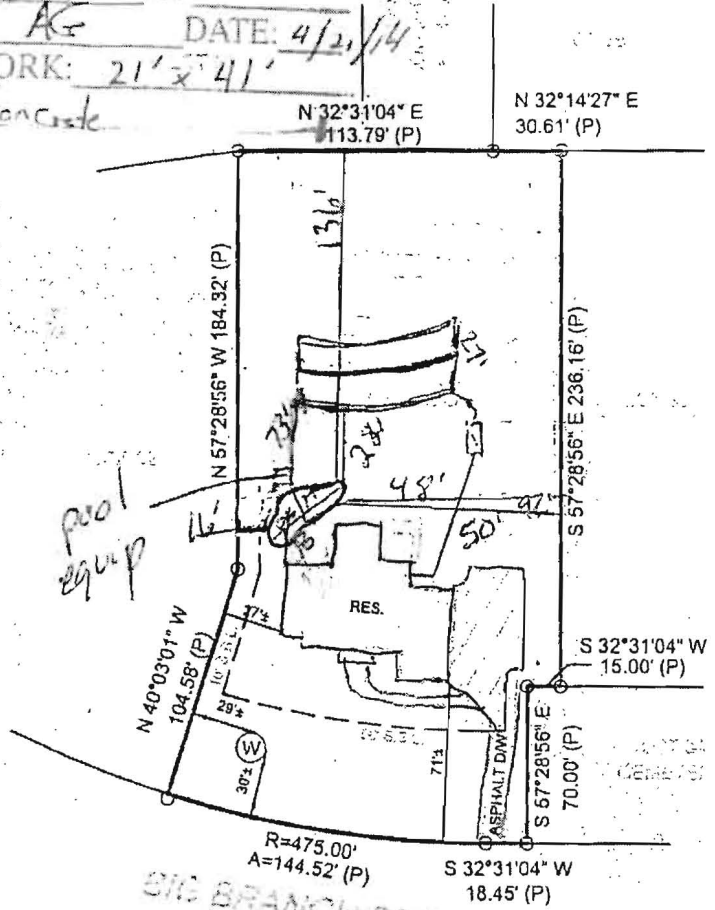

EXPIRES 12-22-2013

BIG BRANCH DRIVE

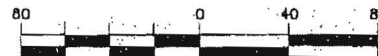

GRAPHIC SCALE (In Feet)

1 inch = 80' ft.

ACCURACY=3±

POINTS OF INTEREST:
NON-MOVABLE

CLIENT NUMBER: 12-22156

DATE: 7/12/2012

BUYER: JEFFREY HENSEL and SUSAN HENSEL

SELLER: BRIAN D. CLARK and CLABETH R. CLARK

CERTIFIED TO:
JEFFREY HENSEL AND SUSAN HENSEL; LAKEVIEW TITLE COMPANY



Charlotte Savoy
REALTOR®

443-858-2723

charlotte@charlottesavoy.com

www.charlottesavoyandassociates.com

KELLER
WILLIAMS