

APPLICATION

A 16705

P _____

SEWAGE DISPOSAL TESTING

MARYLAND STATE DEPARTMENT OF HEALTH

HOWARD COUNTY

ELLICOTT CITY

DISTRICT 3

DATE 8/11/69

TO: THE COUNTY HEALTH OFFICER
ELLICOTT CITY, MARYLAND

I, HEREBY, APPLY FOR THE NECESSARY TESTS IN ORDER TO CONSTRUCT (OR RECONSTRUCT) A SEWAGE DISPOSAL SYSTEM.

PROPERTY OWNER Mark A. Wakefield, Jr.

ADDRESS 231 Chatham Rd., Ellicott City, Md. PHONE HO 5-1345

PROPERTY LOCATION:

SUBDIVISION Woodmark, Inc. LOT NO. 25, Blk. A, Sec. 6

ROAD AND DESCRIPTION London Branch Road

OCCUPANT _____ PHONE _____

PERSON TO CONSTRUCT SYSTEM _____

ADDRESS _____ PHONE _____

SIZE OF LOT 150' x 300' TYPE BLDG. 3 of 4
NUMBER OF BEDROOMS

IF NOT SINGLE RESIDENCE DESCRIBE _____

SIGNATURE OF APPLICANT /s/ Mark A. Wakefield, Jr.

APPROVED BY _____ FOR _____ DATE _____
(KIND OF SYSTEM)


REJECTED BY _____ FOR _____ DATE _____
(KIND OF SYSTEM)

HOLD PENDING FURTHER TESTS _____ DATE _____

REASONS FOR REJECTION OR HOLDING _____

THIS IS NOT A PERMIT

Review of
prelim plat
2/10/69
Retest Not
Needed
No change
in test cones
R11

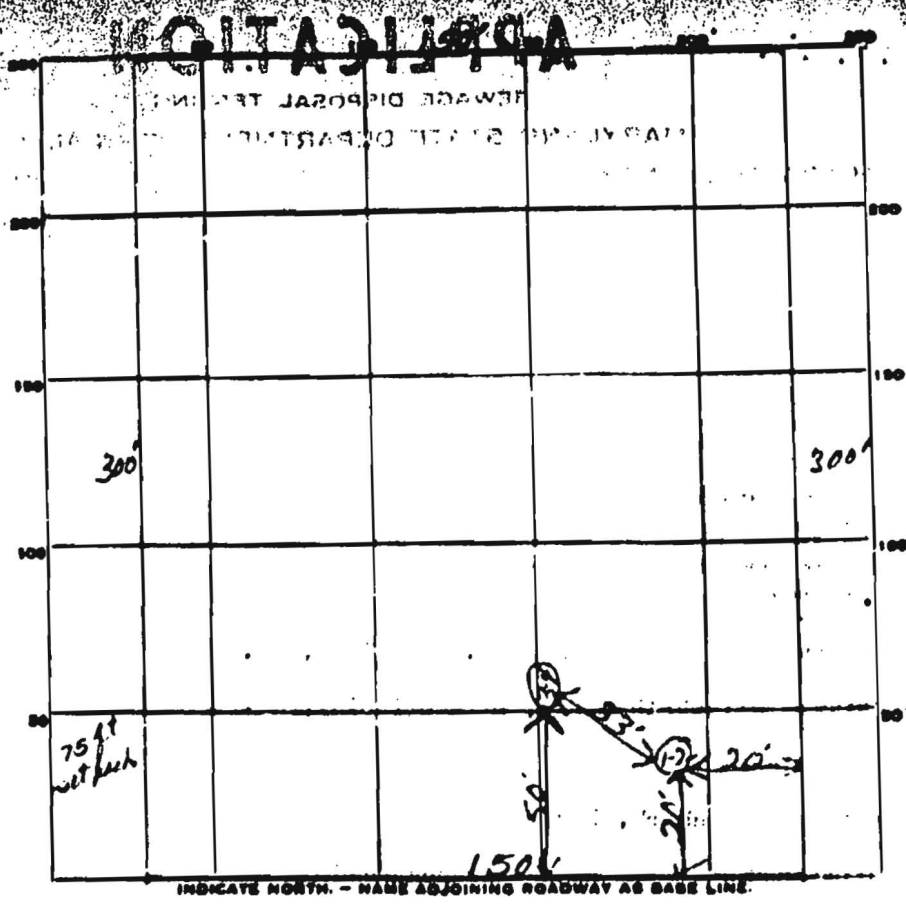

DATE	TEST NO.	DEPTH	PRE-WET		TEST - 1" DROP		TIME
			START	STOP	START	STOP	
9/17/69	1	10 1/2'	10 ²¹	10 ²³	10 ²²	10 ²³	1 min
	2	5'	10 ²¹	10 ²³	10 ²³	10 ²⁴	1 min
	3	10'	10 ²⁴	10 ²⁵	10 ²⁵	10 ²⁶	1 min
	4	5'	10 ²⁴	10 ²⁶	10 ²⁶	10 ³¹	5 min

Let A
26
8m
3m AV

SOIL AUGER FINDING _____
 TESTED BY: _____
 REMARKS: System before house built