

6/27/74
between 10:00
+ 12 noon if possible
7/5/73

PERMIT

SEWAGE DISPOSAL SYSTEM

MARYLAND STATE DEPARTMENT OF HEALTH

HOWARD COUNTY

INDEXED

ELLICOTT CITY

DISTRICT 3rd

DATE 3/23/74

Patrick J. Landrin

IS PERMITTED TO INSTALL X ALTER

ADDRESS 14010 Forsythe Road, Sykesville, Maryland

PHONE 442-2416

A SEWAGE DISPOSAL SYSTEM LOCATED AT _____

SUBDIVISION Woodmark

ROAD Hansen Branch Road

LOT 57, Blk. A, Sec. 6

PROPERTY OWNER Mr. John Bastelec

ADDRESS _____

SPECIFICATIONS 4 bedrooms

DRAIN FIELD _____ DEPTH _____ FEET. BOTTOM AREA _____ SQ. FT.

SEEPAGE PITS _____ ABSORBENT SIDE-WALL AREA _____ SQ. FT.

SEPTIC TANK CAPACITY 1250 GALLONS

FOR GARBAGE GRINDER, INCREASE DISPOSAL AREA 25% & TANK CAPACITY 50%.

OTHER DRY WELL - 400 sq. ft. sidewall area below inlet. Inlet of dry well to be no deeper than 4 ft., and bottom of dry well to be no deeper than 12 ft. Place the dry well 55 ft. from the front lot line and 50 ft. off the right side of the lot as seen when facing the lot from Hansen Branch Road.

NOTE: ALL PIPE FROM HOUSE TO DRY WELL MUST BE CAST IRON.

PERMIT VOID AFTER THREE YEARS.

NOTE: INSTALL STAND PIPE ON SEPTIC TANK AND DRY WELL.

PLANS APPROVED BY Raymond Hodges & Robert Torre DATE 8/27/72 and 3/12/74

FILL SEPTIC TANK AND DISTRIBUTION BOX WITH WATER BEFORE CALLING FOR AN INSPECTION. COVER NO WORK UNTIL INSPECTED AND APPROVED.

NEITHER THE HOWARD COUNTY COMMISSIONERS NOR THE HEALTH DEPARTMENT IS RESPONSIBLE FOR THE SUCCESSFUL OPERATION OF ANY SYSTEM.

ATL/CJ


5000

PERMIT

MARYLAND STATE DEPARTMENT OF HEALTH
SEWAGE DISPOSAL SYSTEM

ELICOTT CITY HOWARD COUNTY

INDEXED

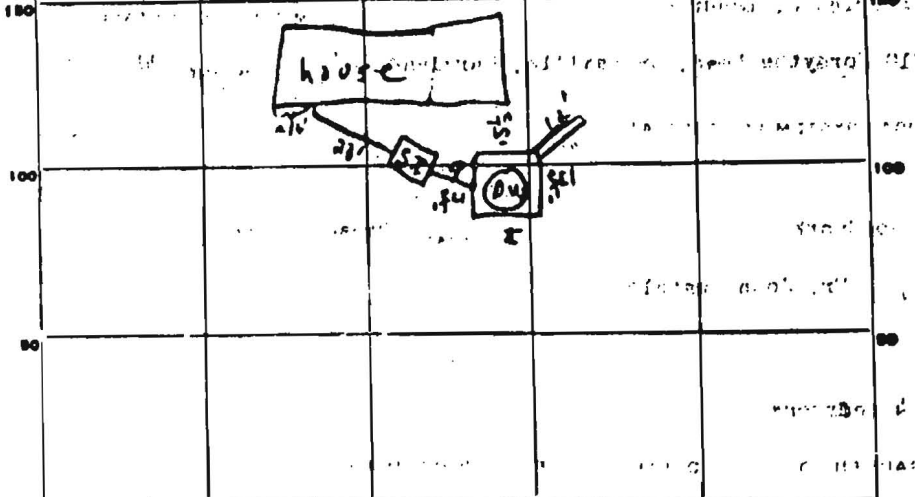

INDICATE NORTH - NAME ADJOINING ROADWAY AS BASE LINE

13.5
14
17.5
15.5
60.5
6.5

PERMIT CARD ✓ signed with satisfactory dig 10ft trench S.T. | AW

SEPTIC TANK, LEVEL ✓ CLEANOUTS ✓

DISTRIBUTION BOX, LEVEL

TILE FIELD, DEPTH FT. TRENCH WIDTH FT.

GRAVEL DEPTH IN. TOTAL LENGTH FT.

NUMBER OF TRENCHES TOTAL BOTTOM AREA

SEEAGE PITS, INSIDE DIAMETER 57 FT. DEPTH BELOW INLET 6.5 FT.

ABSORBENT AREA +393 SQ. FT. (465 ft)

3025
3630
37325
72
465
1210
55
605
15
16
72

REMARKS 7/1/74 Dwyer inlet at 5 1/2' below original grade. Septic tank
slips slightly to lower side (down). Location of Dwyer is OK Partial
check only 5' 10" trench or deeper as well as necessary
7/5/74 12' trench OK