


APPROVED
WALK-THRU BUILDING PERMIT
 BP# B0050846 # P# 514272-A
 APP. SAN KJB DATE: 12/20/01
 DESC. OF WORK: Deck
12' x 22'

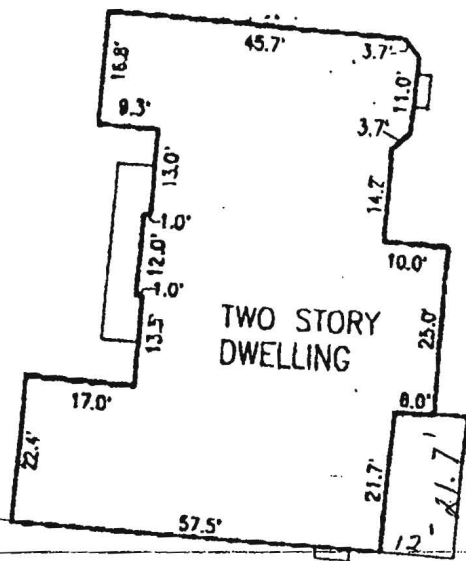


SURVEYOR'S CERTIFICATE

I HEREBY CERTIFY TO THE BEST OF MY KNOWLEDGE AND BELIEF THE DWELLING(S) SHOWN ON THIS DRAWING LIES WITHIN THE LOT LINES SHOWN AS COMPILED FROM TITLE OR OTHER SOURCES. OTHER IMPROVEMENTS ARE FOR PICTORIAL PURPOSES ONLY. THIS DRAWING IS NOT A BOUNDARY SURVEY AND HAS BEEN PREPARED EXCLUSIVELY FOR TITLE PURPOSES ONLY. PREPARED WITHOUT THE BENEFIT OF A TITLE REPORT.

FOUNDATION DETAIL

SCALE: 1" = 30'

David Michael Harris
 REC. No. 10978

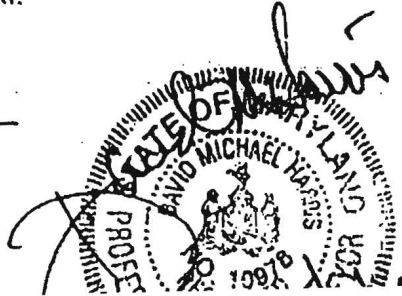

RECORD PLAT No. 13855
 EMA FIRM No. 240044 0025 B
 ONE-

LOCATION DRAWING

14069