

C1 1008 SEQUENCE NO. (DENV USE ONLY)
 1 2 3 4 5 6
 (THIS NUMBER IS TO BE PUNCHED IN COLS. 3-6 ON ALL CARDS)

STATE OF MARYLAND
 WELL COMPLETION REPORT
 FILL IN THIS FORM COMPLETELY
 PLEASE PRINT OR TYPE

THIS REPORT MUST BE SUBMITTED WITHIN 45 DAYS AFTER WELL IS COMPLETED.
 COUNTY NUMBER A4029

ST/CO USE ONLY
 DATE Received 052489
 DATE WELL COMPLETED 012690

Depth of Well 300
 (TO NEAREST FOOT)

PERMIT NO.
 FROM "PERMIT TO DRILL WELL"
H0-89-0872

OWNER VISION BUILDERS INC.
 last name R. KA. VALLEY first name CT. TOWN Lisbon
 STREET OR RFD R. KA. VALLEY CT.
 SUBDIVISION R. KA. VALLEY SECTION LOT 3

WELL LOG
 Not required for driven wells

STATE THE KIND OF FORMATIONS PENETRATED, THEIR COLOR, DEPTH, THICKNESS AND IF WATER BEARING

DESCRIPTION (Use additional sheets if needed)	FEET		Check if water bearing
	FROM	TO	
Overburden	0	10	
Brown Shale	10	55	
Blue Slate	55	300	X

GROUTING RECORD
 WELL HAS BEEN GROUTED (Circle appropriate box) Y N
 TYPE OF GROUTING MATERIAL
 CEMENT CM BENTONITE CLAY BC
 NO. OF BAGS 12 NO. OF POUNDS 1200
 GALLONS OF WATER 72
 DEPTH OF GROUT SEAL (to nearest foot)
 from 0 ft. to 57 ft.
 (enter 0 if from surface)

CASING RECORD
 casing types insert appropriate code below
 ST CO
 STEEL CONCRETE
 PL OT
 PLASTIC OTHER
 MAIN CASING TYPE Nominal diameter top (main) casing (nearest inch) Total depth of main casing (nearest foot)
 ST 6 57
 60 61 63 64 66 70

OTHER CASING (if used)
 diameter depth (feet)
 inch from to

SCREEN RECORD
 screen type or open hole insert appropriate code below
 ST BR HO
 STEEL BRASS OPEN HOLE
 PL OT
 PLASTIC OTHER

DEPTH (nearest ft.)
 1 110 57 300
 8 9 11 15 17 21
 2
 23 24 26 30 32 36
 3
 38 39 41 45 47 51

CIRCLE APPROPRIATE LETTER
 A A WELL WAS ABANDONED AND SEALED WHEN THIS WELL WAS COMPLETED
 E ELECTRIC LOG OBTAINED
 P TEST WELL CONVERTED TO PRODUCTION WELL

I HEREBY CERTIFY THAT THIS WELL HAS BEEN CONSTRUCTED IN ACCORDANCE WITH COMAR 28.04.04 "WELL CONSTRUCTION" AND IN CONFORMANCE WITH ALL CONDITIONS STATED IN THE ABOVE CAPTIONED PERMIT, AND THAT THE INFORMATION PRESENTED HEREIN IS ACCURATE AND COMPLETE TO THE BEST OF MY KNOWLEDGE.

DRILLERS IDENT. NO. 349
 DRILLERS SIGNATURE
 (MUST MATCH SIGNATURE ON APPLICATION)
 SITE SUPERVISOR (sign. of driller or journeyman responsible for sitework if different from permittee)


SLOT SIZE 1 2 3
 DIAMETER OF SCREEN (NEAREST INCH)
 56 60
 from to

GRAVEL PACK IF WELL DRILLED WAS FLOWING WELL INSERT F IN BOX 68


OEP USE ONLY (NOT TO BE FILLED IN BY DRILLER)
 T (E.R.O.S.) W Q
 70 72 74 75 76
 TELESCOPE CASING LOG INDICATOR OTHER DATA

PUMPING TEST
 HOURS PUMPED (nearest hour) 3
 8 9
 PUMPING RATE (gal. per min. to nearest gal.) 4
 11 15
 METHOD USED TO MEASURE PUMPING RATE submersible
 WATER LEVEL (distance from land surface)
 BEFORE PUMPING 08
 17 20
 WHEN PUMPING 041
 22 25
 TYPE OF PUMP USED (for test)
 A air P piston T turbine
 27 27 27
 C centrifugal R rotary O other (describe below)
 27 27 27
 J jet S submersible
 27 27

PUMP INSTALLED
 DRILLER WILL INSTALL PUMP YES NO
 (CIRCLE) (YES or NO)
 IF DRILLER INSTALLS PUMP, THIS SECTION MUST BE COMPLETED FOR ALL WELLS EXCEPT HOME USE
 TYPE OF PUMP INSTALLED PLACE (A,C,J,P,R,S,T,O) IN BOX - SEE ABOVE: 29
 CAPACITY: GALLONS PER MINUTE (to nearest gallon) 31 35
 PUMP HORSE POWER 37 41
 PUMP COLUMN LENGTH (nearest ft.) 43 47
 CASING HEIGHT (circle appropriate box and enter casing height)
 + above } LAND SURFACE
 - below } 1 (nearest foot)
 48 51

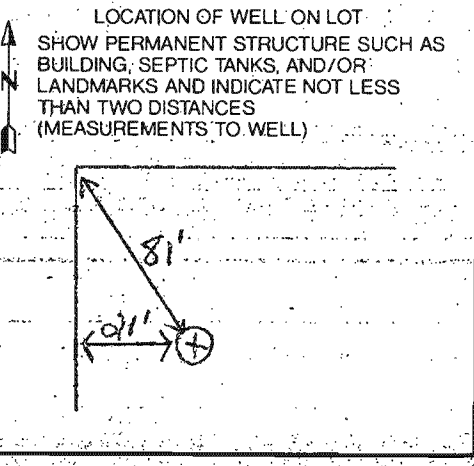

COUNTY

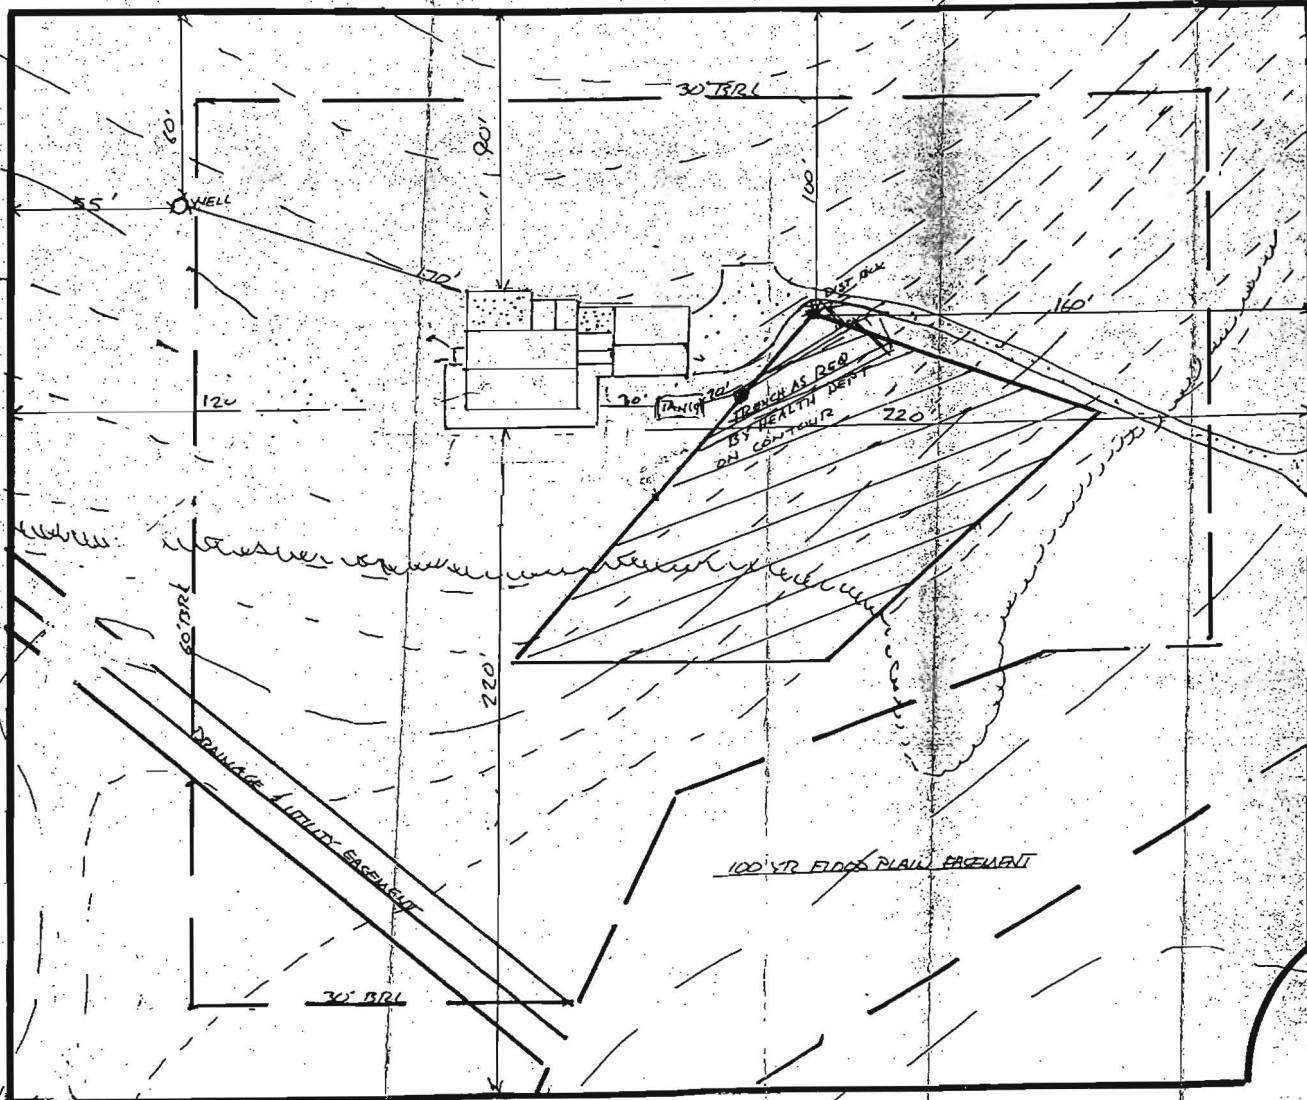

Revised Plans as house +
 Septic were built (mostly) 9/19/84

REVISED
 Date: 11/29/83
 Permit # 51362
 Comments: Driveway location
[Signature]

1625 BOKA VALLEY COURT
 Lot 3

Elevations:

Well	541.00
House	
F.F.	543.00
Base	534.00
Inv. Out	536.00
Tank	
Fin Gr	539.00
Ex Gr	539.00
Inv. In	535.20
Inv. Out	534.80
Dist. Box	
Ex Gr	539.00
Inv. In	534.00

Trenches to be on contour and length to be determined by Health Dept.

Prepared by Fred Dickson
 410-781-6786

Property known as: LOT 3


THIS PLAT CAN NOT BE USED TO ESTABLISH PROPERTY LINES OR CORNERS.

BOKA VALLEY
LOTS 1-7, SECTION 1, AREA 1
PLAT # 8574
4TH ELECTION DISTRICT
HOWARD COUNTY, MD.

DETAIL SCALE: 1"=30'




Walter Park

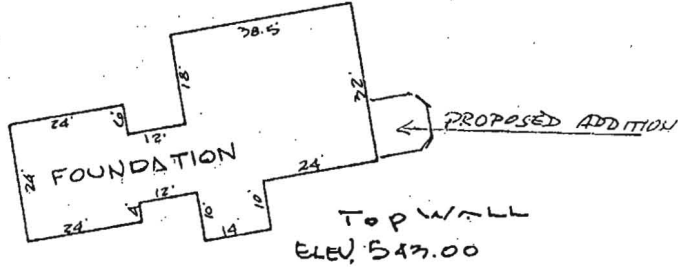

12-2-94 **BP57452**
Proposed location of sunroom will have no impact on existing well or septil. OK to proceed.
Amy McMillen

BOKA VALLEY COURT

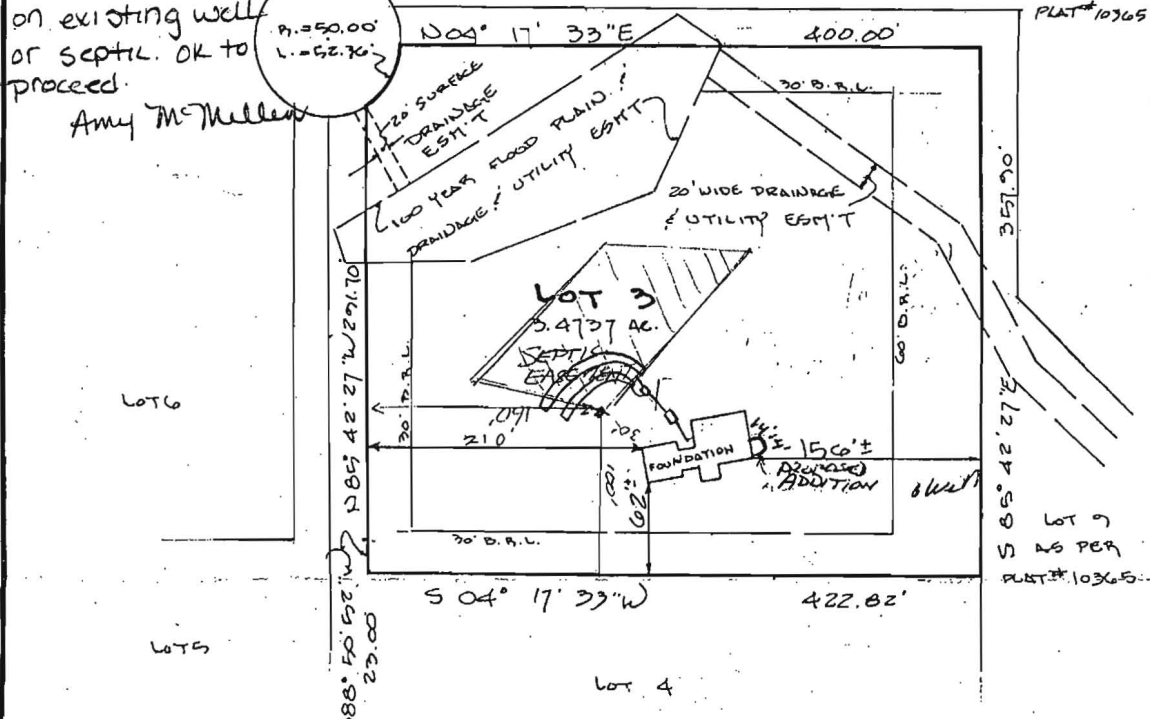

LOCATION SURVEY PLAT
SUBJECT PROPERTY NOT LOCATED IN A FLOOD PLAIN AREA UNLESS OTHERWISE NOTED




CERTIFICATION	SEAL	SCALE 1"=100' DATE 2-7-1994
<p>This is to certify that I have surveyed the property known as: <u>LOT 3</u> <u>BOKA VALLEY COURT</u></p> <p>for the purpose of locating the improvements thereon, and the improvements are located as shown.</p>	 <i>Walter Park</i>	<p>LAND DESIGN ENGINEERING, INC. 8835 Columbia 100 Parkway Unit N Columbia, MD 21045 (410) 715-1070 (301) 596-3424 (410) 715-0681 (Fax)</p>

DAISY ROAD

LAND DEDICATED
COUNTY, MARYLAND
OF A PUBLIC ROAD

W 297.00
R=1169.66 L=233.20
N 04° 17' 33" E
S 04° 17' 33" W AREA= 0.9137 AC.
400.00

INGRESS & EGRESS RESTRICTED
VEHICULAR
INGRESS & EGRESS
RESTRICTED

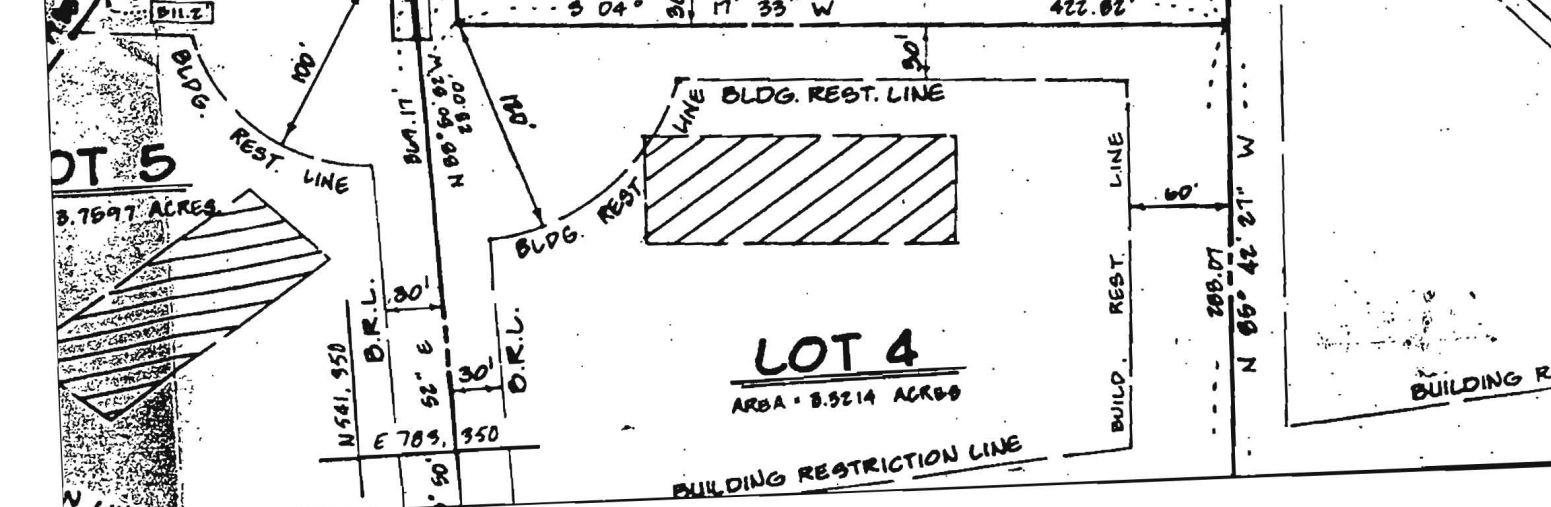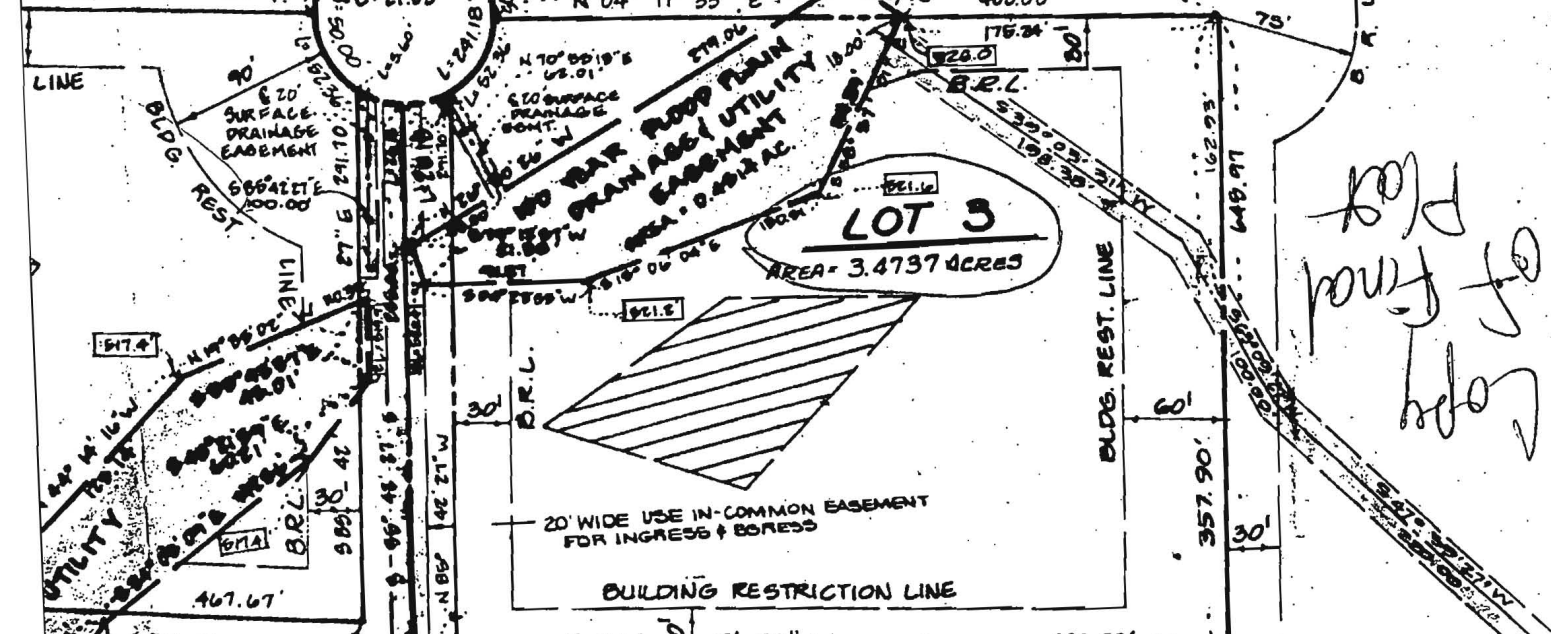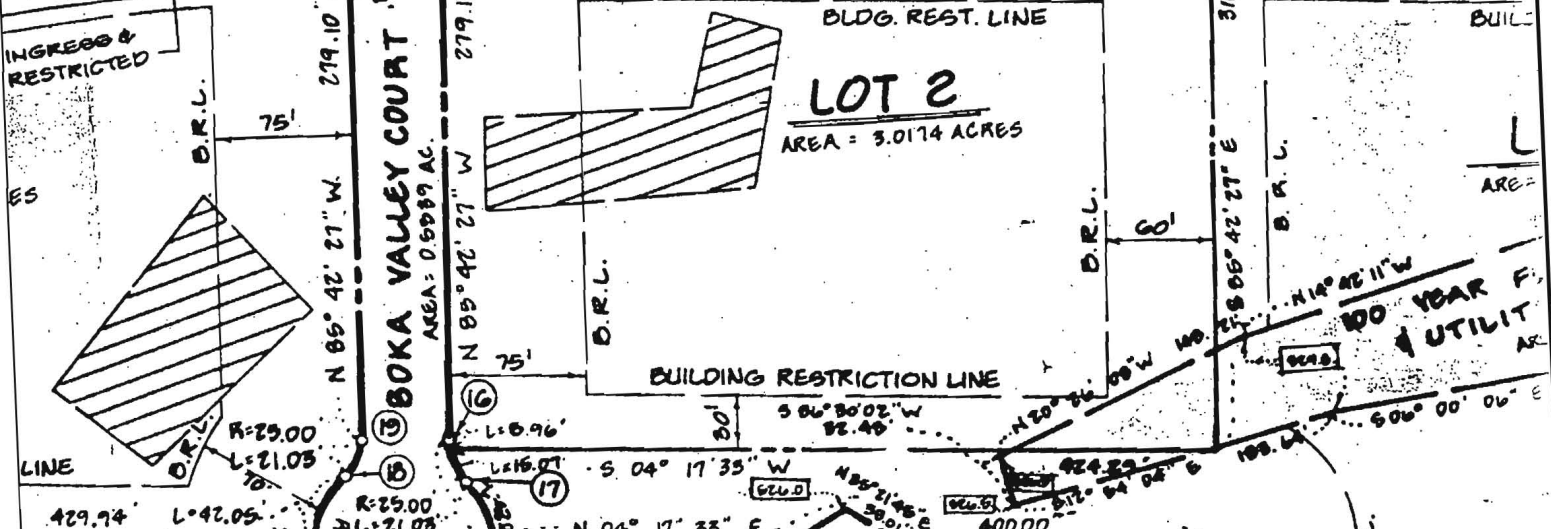

Copy of final plat

BUILDING RESTRICTION LINE