

2/16/94
12:00
3/17/94
12:00
3/16/94

04-399008

PERMIT

P 49857

SEWAGE DISPOSAL SYSTEM

A 41029

DEPARTMENT OF HEALTH AND MENTAL HYGIENE

DISTRICT 4th

*Time Expired for F.C.O.P. Compliance

DATE 1/31/94

HOWARD COUNTY HEALTH DEPARTMENT

BUREAU OF ENVIRONMENTAL HEALTH
313-2640

INDEXED

DATE SYSTEM APPROVED 3/17/94

INSPECTOR *R. Bandy*

Fogle's Septic Clean, Inc.

IS PERMITTED TO INSTALL ALTER

ADDRESS 558 Obrecht Road, Sykesville, Maryland 21784 PHONE 795-5674

SUBDIVISION Boka Valley Estates LOT 3 ROAD 1825 Boka Valley Court

PROPERTY OWNER Fred C. Dickson Builders, Inc.

ADDRESS

SEPTIC TANK CAPACITY 1250 GALLONS

NUMBER OF BEDROOMS 4

240 SQUARE FEET PER BEDROOM

LINEAR FEET OF TRENCH REQUIRED 192

TRENCHES - Trench to be 2 feet wide. Inlet 4 feet below original grade. Bottom maximum depth 9 feet below original grade. Effective area begins at 4 feet below original grade. 5 feet of stone below distribution pipe.

LOCATION - Place the distribution box 145 feet from the back lot line and 205 feet from the right lot line as seen when facing the lot from Boka Valley Court. Run the trenches on contour toward the right rear corner of the lot.

NOTES - No trench to exceed 100 feet in length. Provide 6" - 8" diameter cleanout and cap to grade or above on septic tank. OK MR 1/26/94

PLANS APPROVED BY Raymond Hodges/C. Williams REVISED DATE 01/12/94

COVER NO WORK UNTIL INSPECTED AND APPROVED

NEITHER THE HOWARD COUNTY COUNCIL NOR THE HEALTH DEPARTMENT IS RESPONSIBLE FOR THE SUCCESSFUL OPERATION OF ANY SYSTEM

NOTE: CLEANOUT REQUIRED EVERY 70 FEET OF SEWER LINE AND/OR AT 90° SWEEPS IN LINES FROM HOUSE TO DRAIN FIELDS, 90° ELBOWS NOT ACCEPTABLE.

NOTE: ALL PARTS OF SEPTIC SYSTEMS (I.E. TANK, DISTRIBUTION BOX TRENCHES) TO BE 100 FEET FROM WELL (UNLESS OTHERWISE SPECIFICALLY AUTHORIZED)

NOTE: IF DEEP TRENCH(ES) ARE USED CALL FOR INSPECTION BEFORE AND AFTER PLACING GRAVEL IN TRENCH(ES)

NOTE: NO DRY WELL SHALL EXCEED 15 FOOT IN DIAMETER NO ABSORPTION TRENCH TO EXCEED 100 FEET IN LENGTH

NOTE: ALL PIPE FROM HOUSE TO SEPTIC TANK MUST BE CAST IRON OR SCHEDULE 35/40 PVC OR ABS

PERMIT VOID AFTER TWO YEARS

NOTE: INSTALL STAND PIPE ON SEPTIC TANK AND DRY WELL STAND PIPES MUST BE 8 INCHES IN DIAMETER CAST IRON, CONCRETE OR TERRA COTTA OR PVA OR ABS ACCEPTED. IF TOP OF SEPTIC TANK IS DEEPER THAN 3 FEET. MANHOLE TO GRADE REQUIRED.

NOTE: DISTRIBUTION BOXES MUST HAVE BAFFLES


*INSTALLER IS RESPONSIBLE FOR OBTAINING FINAL APPROVAL ON THIS PERMIT

HD-260(8-90)

*CALL 461-9833 FOR INSPECTION OF SEPTIC SYSTEM.

BLDG. PERMIT SIGNED
AND RETURNED 12/2/94
Serial # 57452
on stand pipe

A 41029

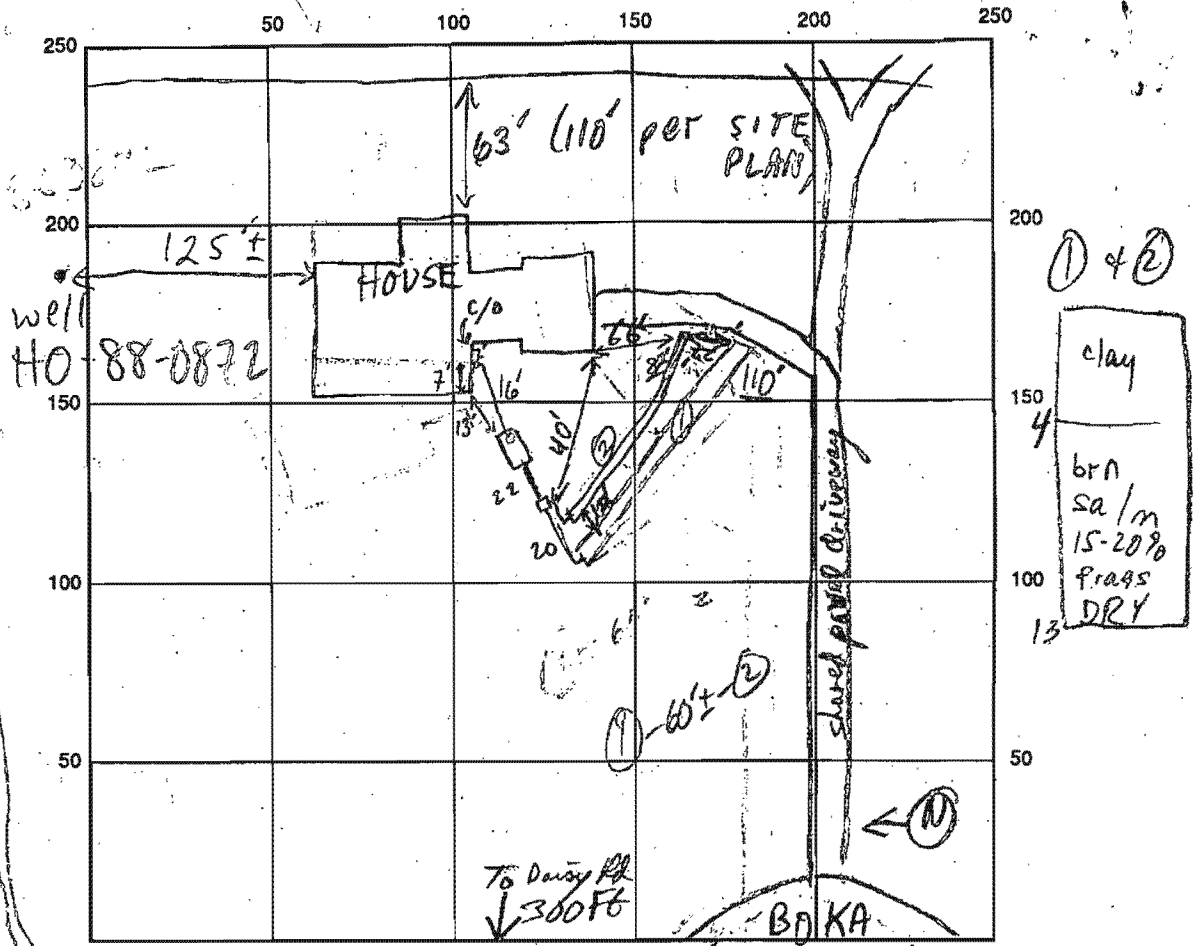

SEPTIC TANK LEVEL 1250 GAL-OK CLEANOUTS OK (ST. & INLINE)

DISTRIBUTION BOX LEVEL OK - BAFFLE IN

DRAIN FIELD/TITLE DEPTH $\frac{9}{9}$ FT. TRENCH WIDTH 2 FT. INLET DEPTH $\frac{4}{4}$ FT.

EFFECTIVE GRAVEL DEPTH $\frac{5}{5}$ FT. TOTAL LENGTH 110/12 FT.

NUMBER OF TRENCHES 2 Total ONE SIDEWALL/BOTTOM AREA 960 SQ. FT.

DRYWALL INSIDE DIAMETER FT. EFFECTIVE DEPTH BELOW INLET FT.

ABSORBENT AREA SQ. FT.

REMARKS: 2/16/94 #1 HOUSE LOCATION MOVED 50' E UPHILL FROM SITE PLAN LOCAT 10N;
DRIVEWAY ALSO REVERSED FROM SITE PLAN LAYOUT, BUT NO IMPACT TO
SDA DUE TO HOUSE RELOCATION; SDA ALSO APPEARED "LOW" BUT HOLES
CONFIRM - OK; IMR 3/16/94 OK TO STONE TRENCH (1), DIG (2) MR
OK to cover lot trench, OK to gravel fill second. OK to cover system 3/17/94
with a line, pull boxes, covered OK by IMR on 3/16

DATE SYSTEM APPROVED 3/17/94 INSPECTOR P. [Signature]

P/S
Type

March 2, 1994

Fred C. Dickson Builders
5414 Mineral Hill Road
Eldersburg, MD 21784

RE: House Relocation
Boka Valley Lot 3
1825 Boka Valley Court

Dear Mr. Dickson,

On February 16, 1994, during a septic system inspection on the above referenced lot, a sanitarian from this office noticed significant discrepancies between the approved site plan and the actual house layout. On that date, Mark Rifkin observed the house to be moved 50 feet uphill, and the driveway location switched from the left side of the house to the right side of the house.

Please submit an accurate, updated site plan for this house so that we may maintain accurate property records.

If you have any questions relative to this matter, please call 313-2640. Thank you very much for your attention to this matter.

Very Truly Yours,

Mark E. Rifkin
Sanitarian,
Water & Sewerage Program

H:\USER\DATA\BOKAVAL3