

4/8/98  
10:00

# PERMIT

## SEWAGE DISPOSAL SYSTEM

### DEPARTMENT OF HEALTH AND MENTAL HYGIENE

P 59929-A

A REPAIR

DISTRICT \_\_\_\_\_

HOWARD COUNTY HEALTH DEPARTMENT

BUREAU OF ENVIRONMENTAL HEALTH

~~XXXXXXXXXX~~ 410-313-2640

INDEXED

DATE 4.8.98

DATE SYSTEM APPROVED 4.8.98

INSPECTOR KM

Hatfield's Equipment Dedication Service, Inc. IS PERMITTED TO INSTALL \_\_\_\_\_ ALTER X

ADDRESS 13785 Burntwoods Road, Glenelg, Maryland 21737 PHONE 410-854-6172

SUBDIVISION \_\_\_\_\_ LOT \_\_\_\_\_ ROAD 11737 Bragdon Woods Court

PROPERTY OWNER \_\_\_\_\_ Catalano

ADDRESS \_\_\_\_\_ 11737 Bragdon Woods Court  
Clarksville, Maryland 21029

SEPTIC TANK CAPACITY 1000 GALLONS

NUMBER OF BEDROOMS 3

125 SQUARE FEET PER BEDROOM

LINEAR FEET OF TRENCH REQUIRED 75

REPAIR - PURPOSE - Septic system has failed.  
Call for inspection when ground is opened so sanitarian can recommend repair.  
04/03/98

Existing tank and drywell to remain, septic tank pumped 4/8/98.  
Bottom at 8.0', inlet at 3.0', 5.0' of stone  
two trenches to be installed and connected to existing distribution

PLANS APPROVED BY Kim Mauck DATE 4.8.98

COVER NO WORK UNTIL INSPECTED AND APPROVED

NEITHER THE HOWARD COUNTY COUNCIL NOR THE HEALTH DEPARTMENT IS RESPONSIBLE FOR THE SUCCESSFUL OPERATION OF ANY SYSTEM

NOTE: CLEANOUT REQUIRED EVERY 70 FEET OF SEWER LINE AND/OR AT 90° SWEEPS IN LINES FROM HOUSE TO DRAIN FIELDS, 90° ELBOWS NOT ACCEPTABLE.

NOTE: ALL PARTS OF SEPTIC SYSTEMS (I.E. TANK, DISTRIBUTION BOX TRENCHES) TO BE 100 FEET FROM WELL (UNLESS OTHERWISE SPECIFICALLY AUTHORIZED)

NOTE: IF DEEP TRENCH(ES) ARE USED CALL FOR INSPECTION BEFORE AND AFTER PLACING GRAVEL IN TRENCH(ES)

NOTE: NO DRY WELL SHALL EXCEED 15 FOOT IN DIAMETER NO ABSORPTION TRENCH TO EXCEED 100 FEET IN LENGTH

NOTE: ALL PIPE FROM HOUSE TO SEPTIC TANK MUST BE CAST IRON OR SCHEDULE 35/40 PVC OR ABS

PERMIT VOID AFTER TWO YEARS


NOTE: INSTALL STAND PIPE ON SEPTIC TANK AND DRY WELL STAND PIPES MUST BE 6 INCHES IN DIAMETER CAST IRON. CONCRETE OR TERRA COTTA OR PVA OR ABS ACCEPTED. IF TOP OF SEPTIC TANK IS DEEPER THAN 3 FEET, MANHOLE TO GRADE REQUIRED.

NOTE: DISTRIBUTION BOXES MUST HAVE BAFFLES

\*INSTALLER IS RESPONSIBLE FOR OBTAINING FINAL APPROVAL ON THIS PERMIT

\*CALL 461-9933 FOR INSPECTION OF SEPTIC SYSTEM.

P59929-A

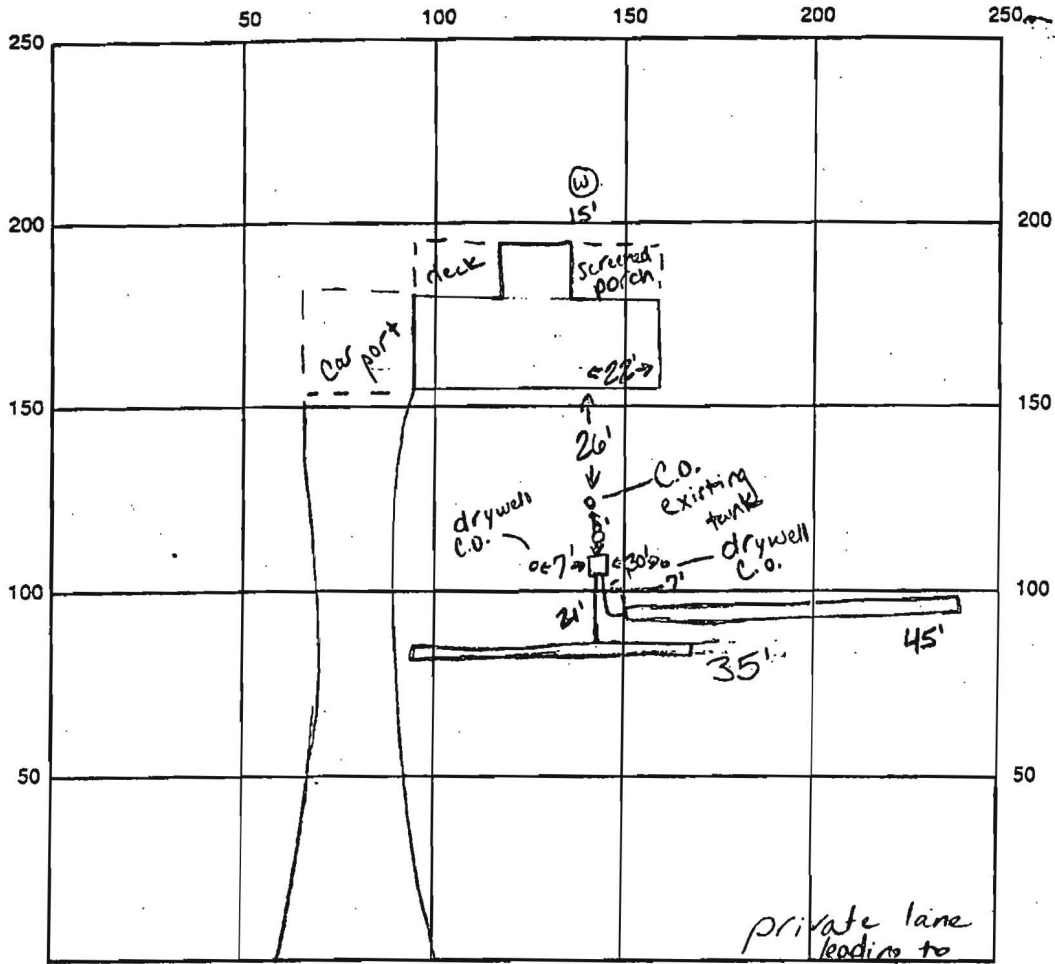

INDICATE NORTH - NAME ADJOINING ROADWAY AS BASE LINE Braydon Woods Ct.

SEPTIC TANK LEVEL existing CLEANOUTS 1 on tank, 1 on each drywell  
 DISTRIBUTION BOX LEVEL ok, baffle in  
 DRAIN FIELD/TITLE DEPTH 8.0' FT. TRENCH WIDTH 2.0 FT. INLET DEPTH 3.0' FT.  
 EFFECTIVE GRAVEL DEPTH 5.0' FT. TOTAL LENGTH  $\frac{12 \times 35}{12 \times 45}$  FT.  $\rightarrow$  75'  
 NUMBER OF TRENCHES 2 ONE SIDEWALL/BOTTOM AREA 375 SQ. FT.  
 DRYWALL INSIDE DIAMETER — FT. EFFECTIVE DEPTH BELOW INLET — FT.  
 ABSORBENT AREA — SQ. FT.

REMARKS: 4.8.98/lan) initial trench looks good, (see front for installation requirements)  
ok to continue (KMM)  
4.8.98/pm) ok to continue (and cover all work) (KMM)


DATE SYSTEM APPROVED 4.8.98 INSPECTOR Kim Maisto



1615  
1610

1615  
1610

2 loads out of Drywell  
135 LG branch  
Install silt fence

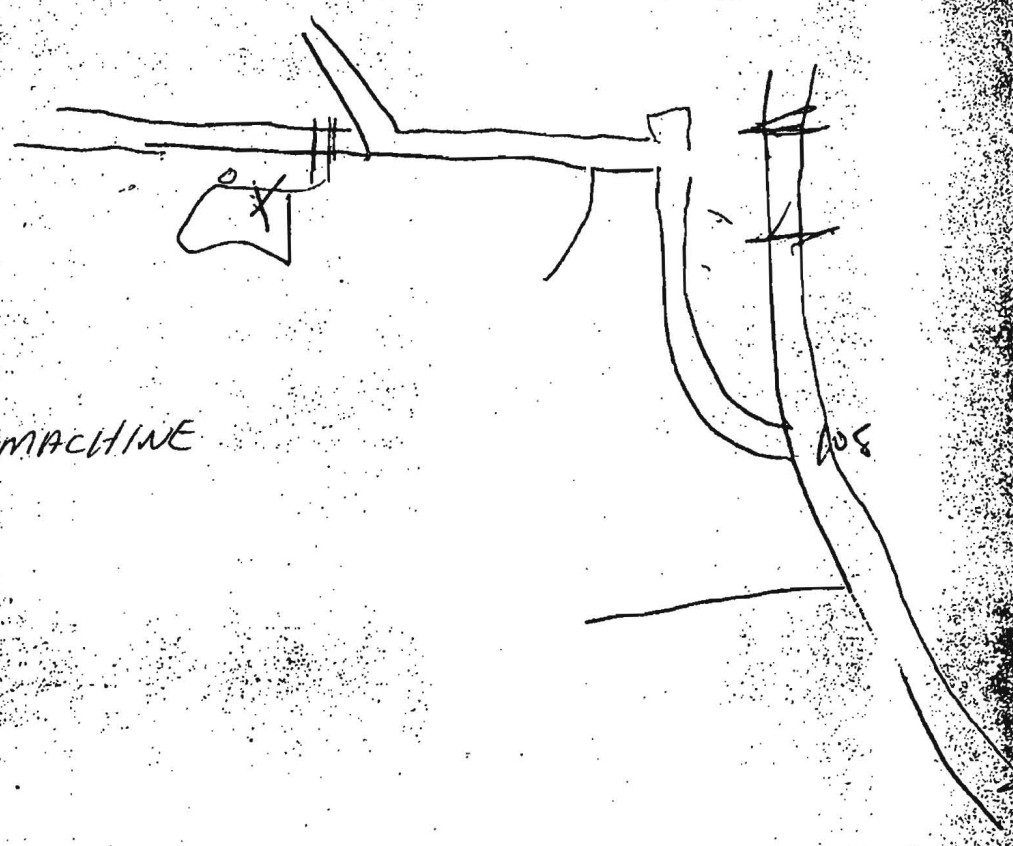

DUMP  
135 LG TRACK MACHINE