

PRELIMINARY

APPLICATION

A 17787

SEWAGE DISPOSAL TESTING

P _____

STATE OF MARYLAND - DEPARTMENT OF HEALTH AND MENTAL HYGIENE

HOWARD COUNTY HEALTH DEPARTMENT
ENVIRONMENTAL HEALTH SERVICES
P. O. BOX 476, ELLICOTT CITY, MARYLAND 21043
TELEPHONE: 465-8000, EXT. 336

DISTRICT 4th

DATE 12/13/72

TO: THE COUNTY HEALTH OFFICER
ELLICOTT CITY, MARYLAND

I, HEREBY, APPLY FOR THE NECESSARY TEST IN ORDER TO CONSTRUCT (OR RECONSTRUCT) A SEWAGE DISPOSAL SYSTEM.

PROPERTY OWNER Brantly Baptist Church

Any questions call Purdum & Jeschke

ADDRESS 5007 Baltimore National Pike, Balto., Md. PHONE 465-1635

PROPERTY LOCATION:

SUBDIVISION Brentwoods LOT NO. 5, Blk. ^B/_K

ROAD AND DESCRIPTION Burntwoods Road

SIZE OF LOT 155' x 260' x 155' x 260' TYPE BLDG. 3 or 4 bedrooms
NUMBER OF BEDROOMS _____

IF NOT SINGLE RESIDENCE DESCRIBE _____

THE SYSTEM INSTALLED UNDER THIS APPLICATION IS ACCEPTABLE ONLY UNTIL PUBLIC FACILITIES BECOME AVAILABLE.

SIGNATURE OF APPLICANT /s/ Purdum and Jeschke

APPROVED BY _____ FOR _____ DATE _____
(KIND OF SYSTEM)

REJECTED BY _____ FOR _____ DATE _____
(KIND OF SYSTEM)

HOLD PENDING FURTHER TESTS _____ DATE _____


REASONS FOR REJECTION OR HOLDING _____

THIS IS NOT A PERMIT

11101

APPLICATION

PERMITTING

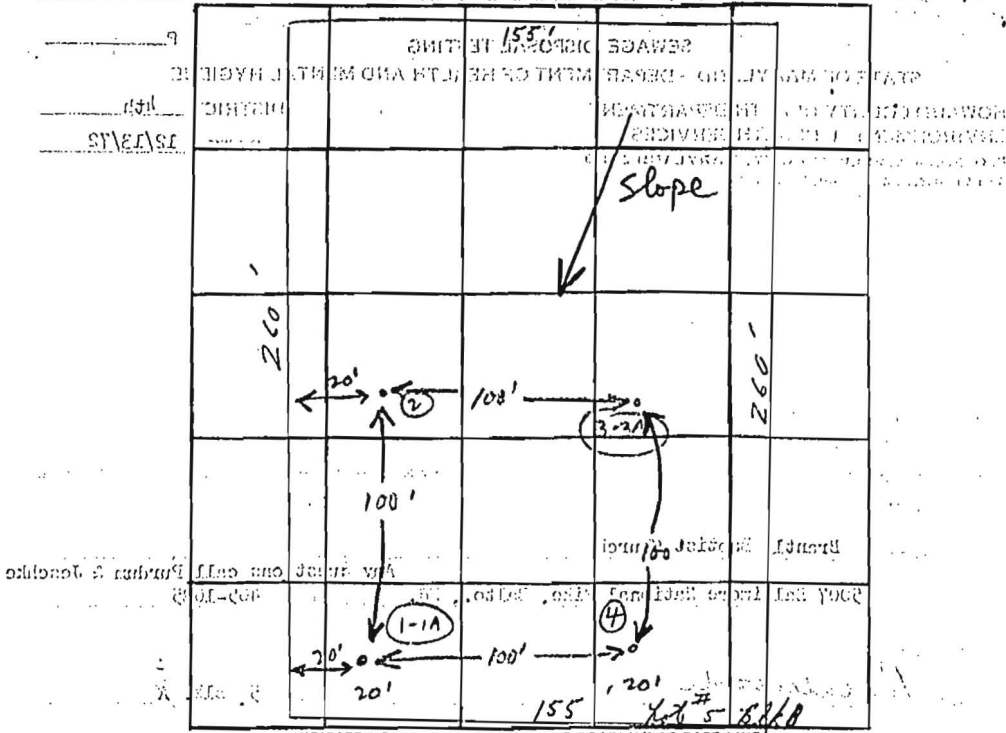

DATE	TEST NO.	DEPTH	PRE-WET		TEST - 1" DROP		TIME
			START	STOP	START	STOP	
11/10/72	1	3'	11:15	11:15	11:15	11:16	1
	1A	13'	11:15	11:26	11:26	11:55	29
	2	13'	TOP 3' - Clay Bottom 9' - (sand)) Dry		
	3	3'	11:30	11:31	11:31	11:32	2
	3A	13'	11:30	11:33	11:33	11:36	3
	4	13'	TOP 3' - Clay Bottom 9' - (sand)) Dry		

awTime
9
MIN

REMARKS Dry Well at (3-3A)

TYPE OF SOIL Inlet 3'

TESTED BY H. Snyder Max Depth 13' ALSO PRESENT: