

APPLICATION

A 23875

SEWAGE DISPOSAL TESTING

P _____

STATE OF MARYLAND - DEPARTMENT OF HEALTH AND MENTAL HYGIENE

HOWARD COUNTY HEALTH DEPARTMENT
ENVIRONMENTAL HEALTH SERVICES
P. O. BOX 476, ELLICOTT CITY, MARYLAND 21043
TELEPHONE 465-5000, EXT. 356

DISTRICT Fourth

DATE Aug. 17, 1976

TO THE COUNTY HEALTH OFFICER
ELLICOTT CITY, MARYLAND

I, HEREBY, APPLY FOR THE NECESSARY TEST IN ORDER TO CONSTRUCT (OR RECONSTRUCT) A SEWAGE DISPOSAL SYSTEM.

PROPERTY OWNER Brantly Associates
c/o H. F. Cole & Company, Inc.
ADDRESS 218 Teachers Building PHONE 730-0810
Columbia, Md. 21044

PROPERTY LOCATION:

SUBDIVISION Brantly LOT NO. 24

ROAD AND DESCRIPTION Brantly Road

SIZE OF LOT 40,000 s.f. TYPE BLDG. 3 or 4 bedroom
NUMBER OF BEDROOMS

IF NOT SINGLE RESIDENCE DESCRIBE _____

THE SYSTEM INSTALLED UNDER THIS APPLICATION IS ACCEPTABLE ONLY UNTIL PUBLIC FACILITIES BECOME AVAILABLE.

SIGNATURE OF APPLICANT /s/ Hugh Cole

APPROVED BY _____ FOR _____ DATE _____
(KIND OF SYSTEM)


REJECTED BY _____ FOR _____ DATE _____
(KIND OF SYSTEM)

HOLD PENDING FURTHER TESTS _____ DATE _____

REASONS FOR REJECTION OR HOLDING _____

THIS IS NOT A PERMIT

A23875

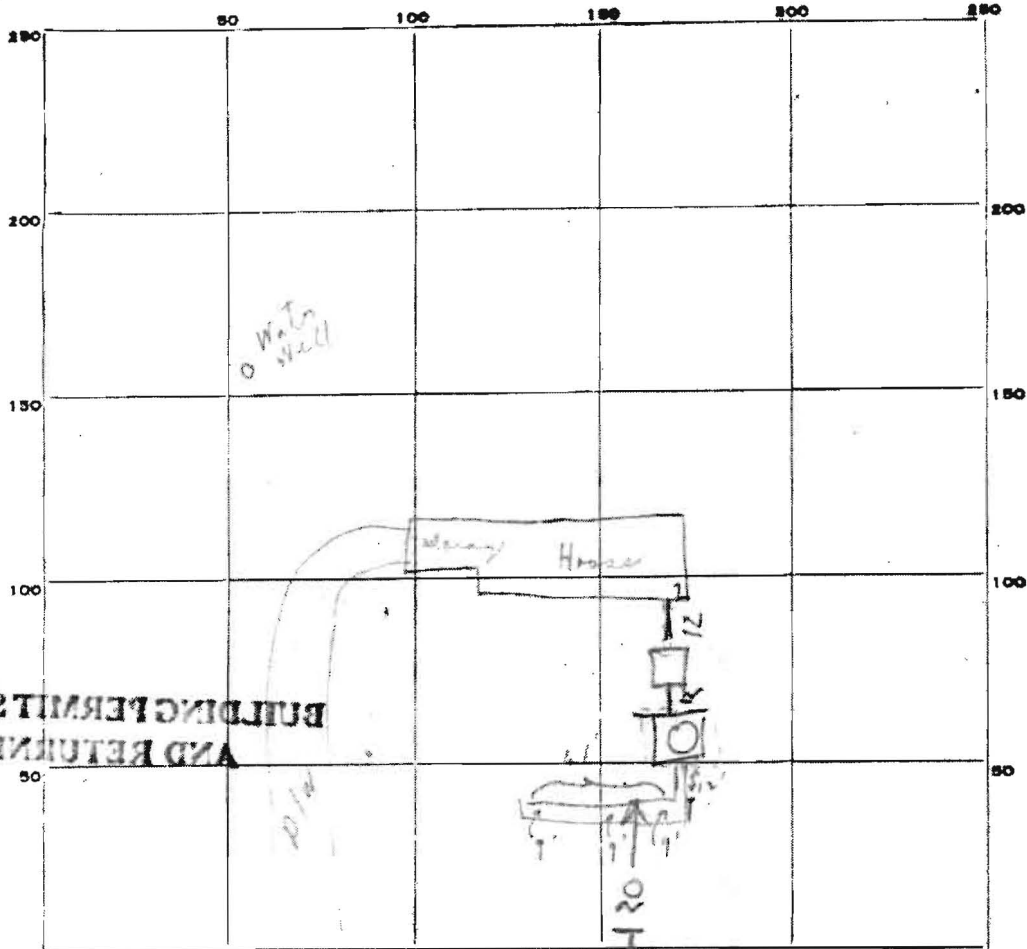

3
11
26
22
43

BUILDING PERMITTED
AND RETURNED

INDICATE NORTH - NAME ADJOINING ROADWAY AS BASE LINE.

PERMIT CARD _____ *Brently Road*
 SEPTIC TANK, LEVEL OK 1250 CLEANOUTS S.T. | D.W. OK | OK
 DISTRIBUTION BOX, LEVEL N/A 7/10/78
 TILE FIELD, DEPTH 9 FT. TRENCH WIDTH 2 FT.
 GRAVEL DEPTH 6 IN. TOTAL LENGTH 61 FT.
 NUMBER OF TRENCHES 1 TOTAL BOTTOM AREA 368
 SEEPAGE PITS, INSIDE DIAMETER PERIMETER 48 FT. DEPTH BELOW INLET 8 FT.
 ABSORBENT AREA 384 SQ. FT.

REMARKS A.M. 4/29/78 Trench 11' long - 9' deep. Permitted
7/10/78 - DW INLET 2 FT BELOW GRADE
750 TOTAL SQ FT ABSORBENT AREA

DATE SYSTEM APPROVED 7/10/78 INSPECTOR Raymond Dodge