

4/18/90 pm
4/19/90 am
4/20/90 11:00

PERMIT

SEWAGE DISPOSAL SYSTEM

MARYLAND STATE DEPARTMENT OF HEALTH

P 45786

A 42659

DISTRICT 5th

DATE 04/17/90

DATE SYSTEM APPROVED 4/20/90

INSPECTOR C. Williams

HOWARD COUNTY
BUREAU OF ENVIRONMENTAL HEALTH
461-9933

05-371058

INDEXED

Alan Whitworth Excavating IS PERMITTED TO INSTALL X ALTER

ADDRESS 12680 Clarksville Pike, Clarksville, Maryland 21029 PHONE 854-2513/531-5033

SUBDIVISION Walter Rydzewski Property ROAD 11743 Bragdon Woods Dr. LOT Map 29 Parcel 45

PROPERTY OWNER Mr. Walter Rydzewski EILEEN ALMARIO

ADDRESS _____

* IF 2 SEPARATE SEPTIC SYSTEMS ARE DESIRED UPPER SYSTEM TO HAVE *
1250 GAL OR LARGER TANK, 2 - 90' TRENCHES 3' WIDE WITH 2' STONE.
LOWER SYSTEM TO HAVE 1000 GAL OR LARGER TANK, 80' TRENCH 3' WIDE
2' STONE.

SEPTIC TANK CAPACITY 1250 GALLONS NUMBER OF BEDROOMS 4

TRENCHES - 180 sq. ft. per bedroom. Trench to be 3 feet wide. Inlet 3 feet below original grade. Bottom maximum depth 5 feet below original grade. Effective area begins at 3 feet below original grade. 2 feet of stone below distribution pipe.

LOCATION - Start the first trench 40 feet from the right lot line and 150 feet from the front (171') lot line. Run trenches along contour towards the rear (187') lot line.

NOTE - No trench to exceed 100 feet in length. Provide 6" - 8" diameter cleanout and cap to grade or above on septic tank. G.L.C.W.

PLANS APPROVED BY Craig Williams cm DATE 11/28/88

COVER NO WORK UNTIL INSPECTED AND APPROVED

NEITHER THE HOWARD COUNTY COUNCIL NOR THE HEALTH DEPARTMENT IS RESPONSIBLE FOR THE SUCCESSFUL OPERATION OF ANY SYSTEM

NOTE: CLEANOUT REQUIRED EVERY 70 FEET OF SEWER LINE AND/OR AT 90° SWEEPS IN LINES FROM HOUSE TO DRAIN FIELDS

NOTE: ALL PARTS OF SEPTIC SYSTEMS (I.E., TANK, DISTRIBUTION BOX, TRENCHES) TO BE 100 FEET FROM WELL (UNLESS OTHERWISE SPECIFICALLY AUTHORIZED)

NOTE: IF DEEP TRENCHES ARE USED CALL FOR INSPECTION BEFORE AND AFTER PLACING GRAVEL IN TRENCHES

NOTE: NO DRY WELL SHALL EXCEED 15 FOOT IN DIAMETER NO ABSORPTION TRENCH TO EXCEED 100 FEET IN LENGTH

NOTE: ALL PIPE FROM HOUSE TO SEPTIC TANK MUST BE CAST IRON OR SCHEDULE 40 PVC OR ABS

PERMIT VOID AFTER TWO YEARS

NOTE: INSTALL STAND PIPE ON SEPTIC TANK AND DRY WELL. STAND PIPES MUST BE 6 INCHES IN DIAMETER. CAST IRON, CONCRETE OR TERRA COTTA OR PVC OR ABS ACCEPTED. IF TOP OF SEPTIC TANK IS DEEPER THAN 3 FEET, MANHOLE TO GRADE REQUIRED

NOTE: DISTRIBUTION BOXES MUST HAVE BAFFLES


AND RETURNED 1-12-2010
Serial # B70122106
Additional deck

*INSTALLER IS RESPONSIBLE FOR OBTAINING FINAL APPROVED PERMITS PERMIT

*CALL 461-9933 FOR INSPECTION OF SEPTIC SYSTEMS.

AND RETURNED 1-12-2010
Serial # B70122106
deck

42659

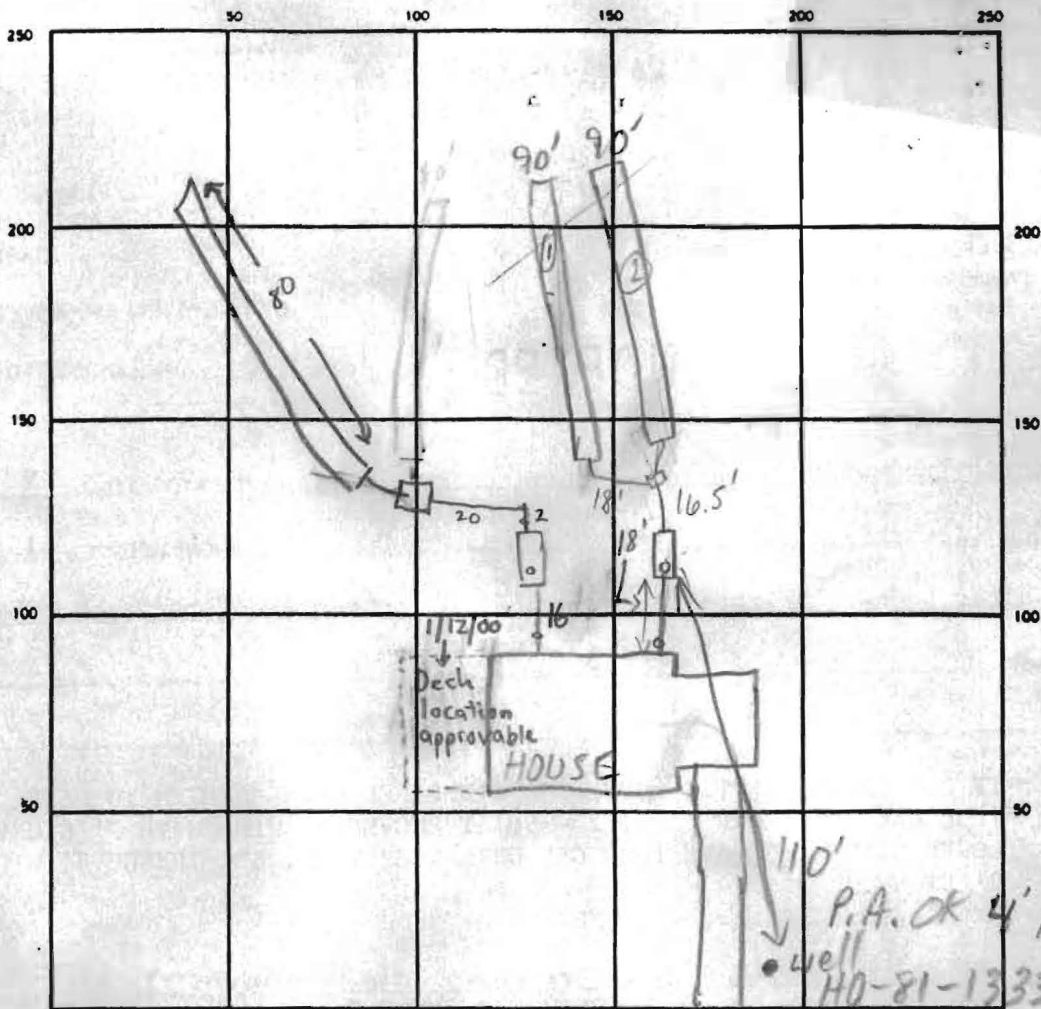

INDICATE NORTH - NAME ADJOINING ROADWAY AS BASE LINE

COMMON DRIVE

SEPTIC TANK. LEVEL MAIN-1500 BASEMENT 1500 CLEANOUTS OK - BOTH

DISTRIBUTION BOX. LEVEL OK MAIN BASEMENT

DRAIN FIELD/TILE FIELD. DEPTH 5/5 FT. TRENCH WIDTH 3/3 FT. INLET DEPTH 3/3 FT.

EFFECTIVE GRAVEL DEPTH 2/2 FT. TOTAL LENGTH 90 MAIN / 90 BASEMENT FT.

NUMBER OF TRENCHES 2 MAIN / 1 BASEMENT ONE SIDEWALL/BOTTOM AREA 540 / 240 SQ FT

DRYWELL INSIDE DIAMETER — FT. EFFECTIVE DEPTH BELOW INLET — FT.

TOTAL ABSORBENT AREA 760 SQ FT.

REMARKS 4/19/90 #1 HOUSE PLUMBING DOES NOT SEEM TO ALLOW
INSTALLATION OF SYS. PER SPECS (TOO LOW); S.T. FOR MAIN
SYS SET AT DIFF LOC., SOME SDA AREA LOST; DB FOR
EACH SYS. RESET AS BOTH DB'S WERE TOO LOW ALSO MR
4/19/90 #2 OK TO COVER MAIN SYS. WHEN READY

DATE SYSTEM APPROVED 4/20/90 INSPECTOR Cwilliam







