

OCT 3, 1988
NOON

APPLICATION

PERCOLATION TESTING

A 42457

P _____

HOWARD COUNTY HEALTH DEPARTMENT
BUREAU OF ENVIRONMENTAL HEALTH
P.O. BOX 476 ELLICOTT CITY, MARYLAND 21043
TELEPHONE: 461-9933

DISTRICT _____

DATE 9/29/88

REVIEW OK CW

TO: THE COUNTY HEALTH OFFICER
ELLICOTT CITY, MARYLAND

I HEREBY APPLY FOR THE NECESSARY TEST IN ORDER TO CONSTRUCT (OR RECONSTRUCT) A SEWAGE DISPOSAL SYSTEM.

PROPERTY OWNER WALTER RYDZEWSKI - 531-6376

ADDRESS 11743 BRAGDON WOODS CLARKSVILLE 21029 PHONE _____

PROSPECTIVE BUYER N/A

ADDRESS _____ PHONE _____

PROPERTY LOCATION:

SUBDIVISION RYDZEWSKI PROPERTY LOT NO. TAX MAP 29 PARCEL 45

ROAD AND DESCRIPTION 11743 BRAGDON WOODS

TAX MAP 29 PARCEL # 45 (RETEST TO MOVE SEPTIC AREA HIGHER ON LOT)

SIZE OF LOT 1 AC26 TYPE BLDG. RESIDENTIAL
(SINGLE FAMILY DWELLING OR COMMERCIAL)

THE SYSTEM INSTALLED UNDER THIS APPLICATION IS ACCEPTABLE ONLY UNTIL PUBLIC FACILITIES BECOME AVAILABLE. I FULLY UNDERSTAND THE FEE CONNECTED WITH THE FILING OF THIS PERC TEST APPLICATION IS NON-REFUNDABLE UNDER ANY CIRCUMSTANCES. I ALSO AGREE TO COMPLY WITH ALL M.O.S.H.A. REQUIREMENTS IN TESTING THIS LOT.

Walter Rydzewski
(SIGNATURE OF APPLICANT)

APPROVED BY _____ FOR _____ DATE _____

REJECTED BY _____ FOR _____ DATE _____



HOLD PENDING FURTHER TESTS _____ DATE _____

REASONS FOR REJECTION OR HOLDING _____

BLDG. PERMIT SIGNED
AND RETURNED 9/20/88
Serial # 29290 - SFD
4 Bedroom

HD-216

THIS IS NOT A PERMIT

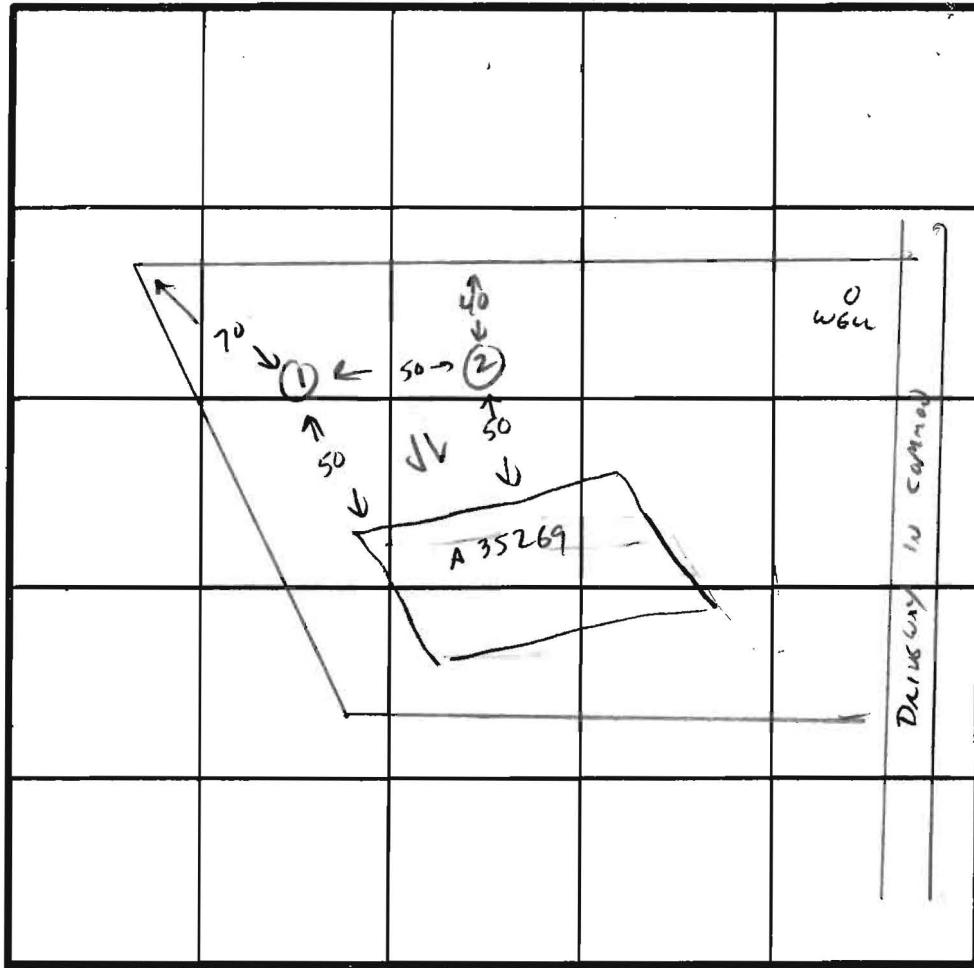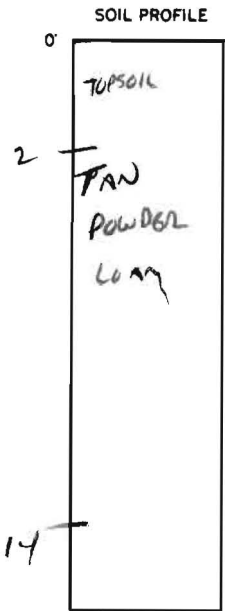

INDICATE NORTH - NAME ADJOINING ROADWAY AS BASE LINE.

DATE	TEST NO.	DEPTH	PRE-WET		TEST - 1" DROP		TIME
			START	STOP	START	STOP	
10/3/88	1	3 8	VIS	OK	LOAM		EST 2-3 MIN
		14					
	2	3 8	VIS	OK	LOAM		EST 2-3 MIN
		14					

REMARKS OK TO MOVE SYSTEM HIGH ON LOT AS PROPOSED BY APPLICANT.

TYPE OF SOIL MIC A LOAM

TESTED BY C. William ALSO PRESENT RYDZOWSKI

5/9/85
7:30 PM
NO SHOW
THAT DAY

APPLICATION

5-27-85
1:30 PM

SEWAGE DISPOSAL TESTING

STATE OF MARYLAND - DEPARTMENT OF HEALTH AND MENTAL HYGIENE

A 35269
P _____

HOWARD COUNTY HEALTH DEPARTMENT
ENVIRONMENTAL HEALTH SERVICES
PO BOX 476 ELLICOTT, MARYLAND 21043
TELEPHONE: 992-2330

DISTRICT _____
DATE 4/10/85

TO: THE COUNTY HEALTH OFFICER
ELLICOTT CITY, MARYLAND

I HEREBY APPLY FOR THE NECESSARY TEST IN ORDER TO CONSTRUCT (OR RECONSTRUCT) A SEWAGE DISPOSAL SYSTEM.

PROPERTY OWNER Walter J. and Ella Mae Rydzewski BOB MENCH ^H 531-3936
ATTN: BOB MENCH 4964-6230
ADDRESS 11680 Clarksville Pike, Clarksville, Md. 21029 PHONE (301) 531-2550

PROPERTY LOCATION:

SUBDIVISION None Tax map # 29, Parcel 45
ROAD AND DESCRIPTION 11666 Clarksville Pike (Md. Rt. 108) - northwest side of Rte. 108
Immediately west of Middle Patuxent River 1st driveway to right after crossing
river going toward Clarksville. Turn
on stone driveway to perc site.
SIZE OF LOT 1.172 Ac. ± TYPE BLDG. Residence

THE SYSTEM INSTALLED UNDER THIS APPLICATION IS ACCEPTABLE ONLY UNTIL PUBLIC FACILITIES BECOME AVAILABLE.

I FULLY UNDERSTAND THE FEE CONNECTED WITH THE FILING OF THIS PERC TEST APPLICATION IS NON-REFUNDABLE UNDER ANY CIRCUMSTANCES.

SIGNATURE OF APPLICANT _____



APPROVED BY _____ FOR _____ DATE _____

REJECTED BY _____ FOR _____ DATE _____

HOLD PENDING FURTHER TESTS _____ DATE _____

REASONS FOR REJECTION OR HOLDING CERTIFIED LOCATIONS REQUIRED. 5/27/85
SHALLOW SYSTEM DUE TO VARIABLE DEPTH TO ROCK. C. Wilbur

THIS IS NOT A PERMIT

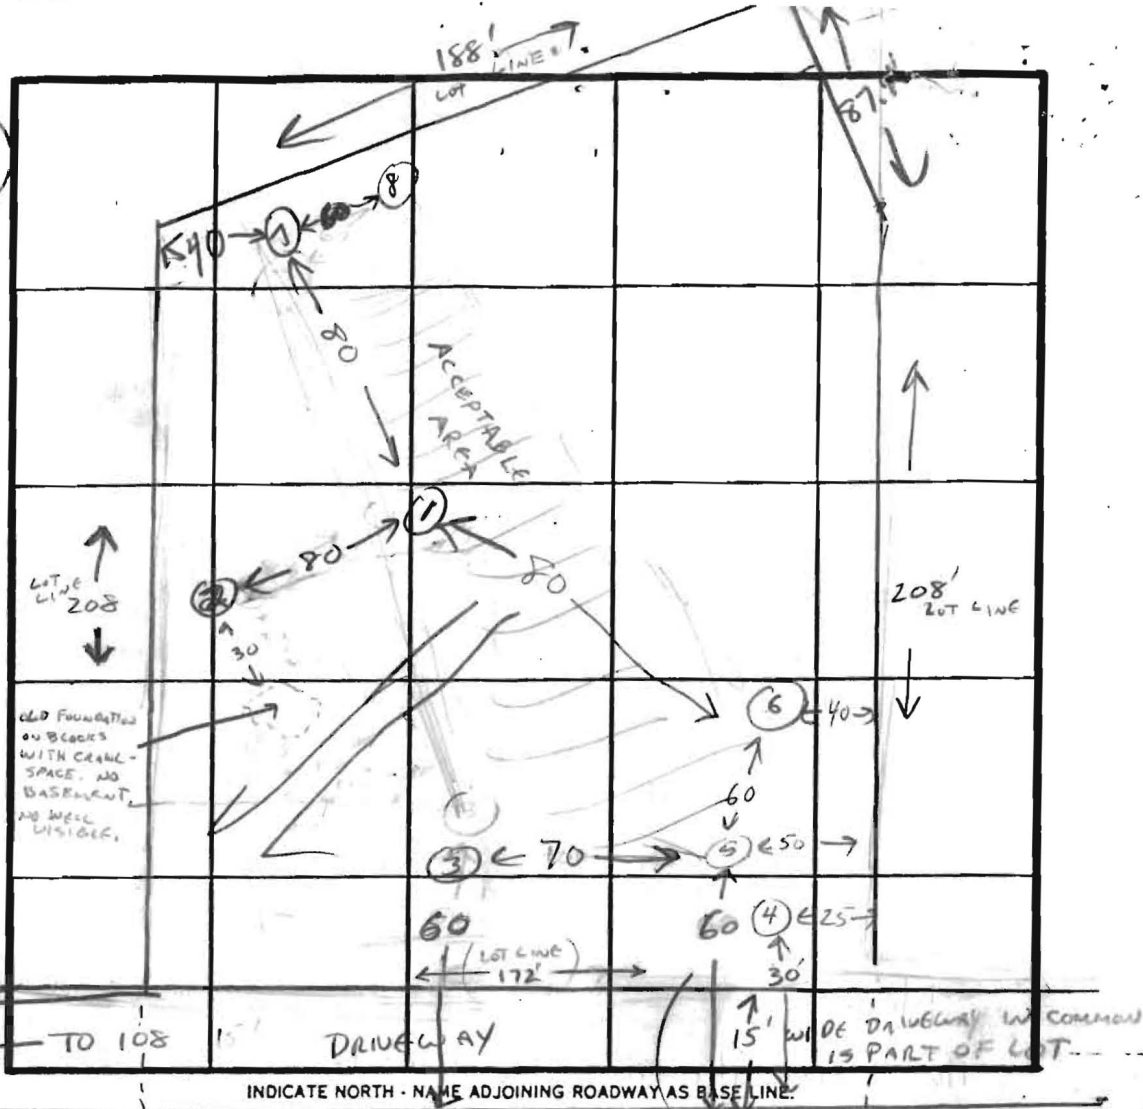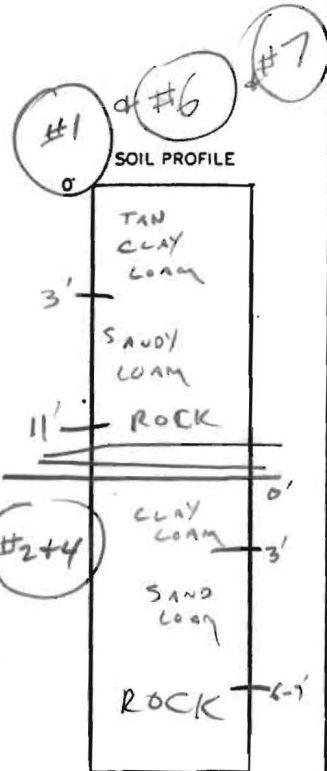

DATE	TEST NO.	DEPTH	PRE-WET		TEST - 1' DROP		TIME
			START	STOP	START	STOP	
5-27-85	1	3	2:51	2:53	2:53	2:57	4 MIN
		8	SAND LOAM				OK
5-27-85	2	11	ROCK BOT TM				X
		7	ROCK				X
5-27-85	3 LOW	3	3:52	3:54	3:54	3:56	2 MIN
		8	SAND LOAM				OK
5-27-85	4	11	ROCK EDGE ON ONE SIDE OF HOLE				X
		15	SANDY, DRY TO 15' ON OTHER SIDE				X
5-27-85	5	3	VIS OK				
		8	SOME ROCK CHUNKS		INTERPEASED	WITH SAND	LOAM 3-11"
5-27-85	6 HIGH	11	ROCK				X
		3	4:47	4:49	4:51	4:53	2 MIN
5-27-85	7	8	OK VIS SAND				
		11	ROCK BOTTOM				
5-27-85	8	3	5:06	5:08	5:08	5:10	2 MIN
		11	ROCK BOTTOM				

TIME 3 MIN
 INLET 3"
 MAX DEPTH 4.5'
 18" STONE 3" WIDE

REMARKS GOOD HOLES 1-3-5-6-7-8. MARKED WITH ORANGE FOR SURVEYOR
 TYPE OF SOIL MICA SAND LOAM - VARIABLE DEPTH TO ROCK BOTTOM
 TESTED BY C. Miller ALSO PRESENT WHITWORTH, BOB MENCH

J. D. ASPHALL

TRAIL

901

011

211

411

Existing well site

Radius

200.300

122

124

124

GARAGE

PROPOSED HOUSE

FF: 128.04
BE: 114.04

121

124

6.9'

122

120

110

116

121

111

N 32° 32' 47" E

07.71'

122

51' 00" E

DISTRIBUTION BOX

1250
1000 GALLON
SEPTIC TANK

MANHOLE

100 I.F.P.

100 I.F.P.

4" perforated
sanitary pipe

N 81° 18'

24"


122

124

winning

11

JAY D. ADRIANALTY

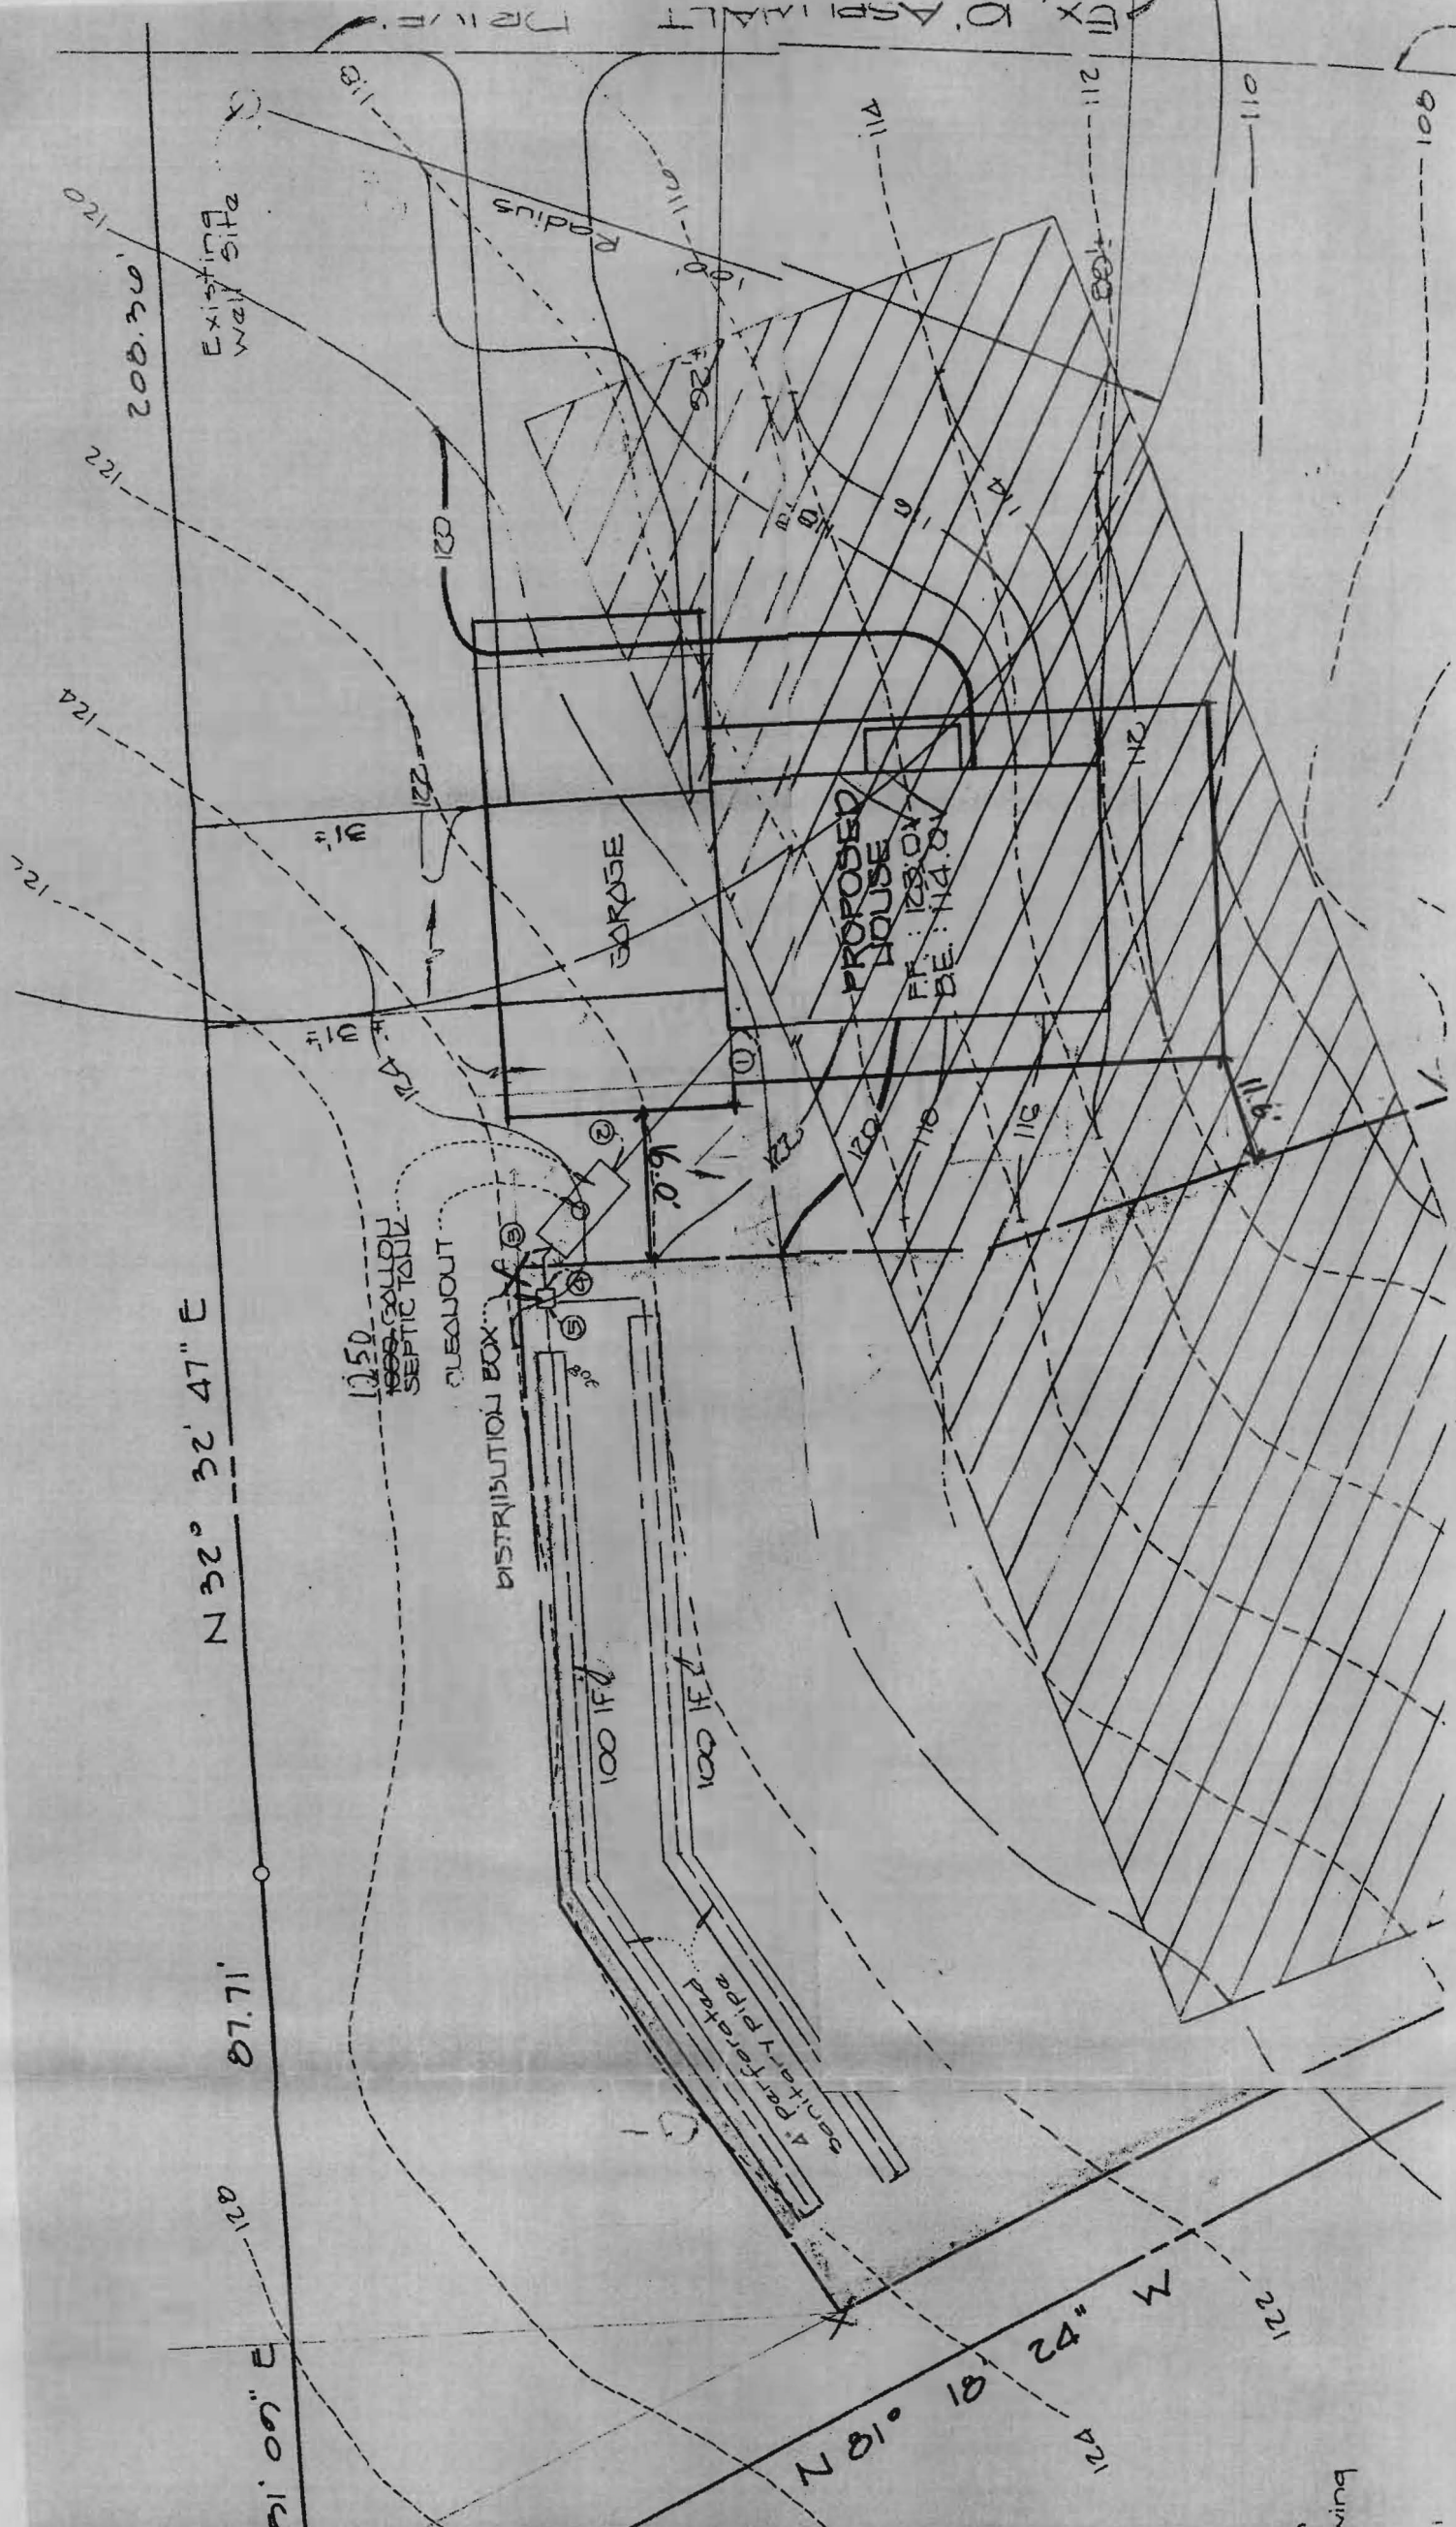

winning