



B 1 3965  
1 2 3 4 5 6  
(THIS NUMBER IS TO BE PUNCHED IN COLS. 3-6 ON ALL CARDS)

SEQUENCE NO. (OEP USE ONLY)

STATE OF MARYLAND PERMIT TO DRILL WELL  
please print or type

OEP PERMIT NUMBER  
70 79  
48-811-1335  
fill in this form completely

Date Received  
8 13  
OWNER INFORMATION  
15 Last Name 8 13 34 First Name  
17680 CLARKSVILLE PK  
36 55 Street or RFD  
CLARKSVILLE MD 21029  
57 70 State 72 Zip 76

B 3 LOCATION OF WELL  
1 2  
8 COUNTY 21  
23 SUBDIVISION 42  
SECTION 44 46 LOT 48 50  
52 NEAREST TOWN  
MILES FROM TOWN (enter 0 if in town) 73 76 77 78

DRILLER INFORMATION  
Driller's Name 77 License No. 80  
Joseph L. Mayne 238  
Firm Name  
Joseph L. Mayne Well Drilling  
Address  
5512 Ridge Rd. Mt Airy, Md. 21771  
Signature 1/14/86 Date

B 4 DIRECTION OF WELL FROM TOWN (CIRCLE BOX)  
NORTH  
WEST  
EAST  
SOUTH  
ON WHICH SIDE OF ROAD (CIRCLE APPROPRIATE BOX)  
NEAR WHAT ROAD  
DISTANCE FROM ROAD  
ENTER FT or MI

B 2 WELL INFORMATION  
APPROX. PUMPING RATE (GAL. PER MIN.)  
AVERAGE DAILY QUANTITY NEEDED (GAL. PER DAY)

USE FOR WATER (CIRCLE APPROPRIATE BOX)  
D HOME (SINGLE OR DOUBLE HOUSEHOLD UNIT ONLY)  
F FARMING (LIVESTOCK WATERING & AGRICULTURAL IRRIGATION)  
I INDUSTRIAL, COMMERCIAL, STATE AND FEDERAL GOV. OTHER (REQUIRES APPROPRIATION PERMIT)  
P PUBLIC OR PRIVATE WATER COMPANY (REQUIRES APPROPRIATION PERMIT AND STATE HEALTH DEPARTMENT APPROVAL)  
T TEST; OBSERVATION, MONITORING (MAY REQUIRE APPROPRIATION PERMIT)


NOT TO BE FILLED IN BY DRILLER HEALTH DEPARTMENT APPROVAL  
COUNTY NAME HOWARD COUNTY NO. A 35269  
OEP SIGNATURE B. Nelson STATE HEALTH INSERT S  
DATE ISSUED 08/03/86  
CO SIGNATURE EXP. DATE  
NORTH GRID 509 0 0 0 EAST GRID 0802000

APPROXIMATE DEPTH OF WELL 260 FEET  
APPROXIMATE DIAMETER OF WELL 6 INCH NEAREST INCH

SHOW MAJOR FEATURES OF BOX & LOCATE WELL WITH AN X  
SOURCES OF DRILLING WATER  
1. WELL  
2.  
3.  
WRITE THE BOX NUMBER FROM THE MAP HERE  
E 922  
N 509  
DRAW A SKETCH BELOW SHOWING LOCATION OF WELL IN RELATION TO NEARBY TOWNS AND ROADS AND GIVE DISTANCE FROM WELL TO NEAREST ROAD JUNCTION

METHOD OF DRILLING (circle one)  
BORED (or Augered) JETTED Jetted & DRIVEN  
AIR-ROtary AIR-PERcussion ROTARY (Hydraulic Rotary)  
CABLE REVerse-ROtary DRive-POINT  
other

REPLACEMENT OR DEEPEMED WELLS (CIRCLE APPROPRIATE BOX)  
N THIS WELL WILL NOT REPLACE AN EXISTING WELL  
Y THIS WELL WILL REPLACE A WELL THAT WILL BE ABANDONED AND SEALED  
S THIS WELL WILL REPLACE A WELL THAT WILL BE USED AS A STANDBY  
D THIS WELL WILL DEEPEM AN EXISTING WELL  
PERMIT NUMBER OF WELL TO BE REPLACED OR DEEPEMED (IF AVAILABLE)

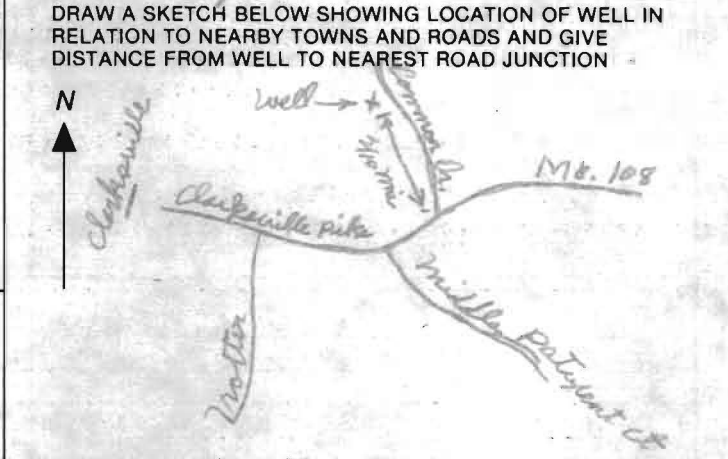

Not to be filled in by driller (OEP USE ONLY)  
APPROP. PERMIT NUMBER GAP  
FORCE INITIALS PERMIT NO. 48-811-1335

SPECIAL CONDITIONS

4/15/86  
NEW PERC  
CLOSE TO 1/1578  
SEAL  
REWRITE  
SPECS

PARCEL  
35

Oberhaltzer  
property

2/3/86  
WELL  
OR  
FIELD STONE  
Pa

Jacob  
Oberhaltzer

A-10972


EX FOUNDATION  
TO BE DAZED

Catalano  
property

PARCEL 43

Watson  
estate

4/15/86  
PROPOSED  
SITE  
Pa

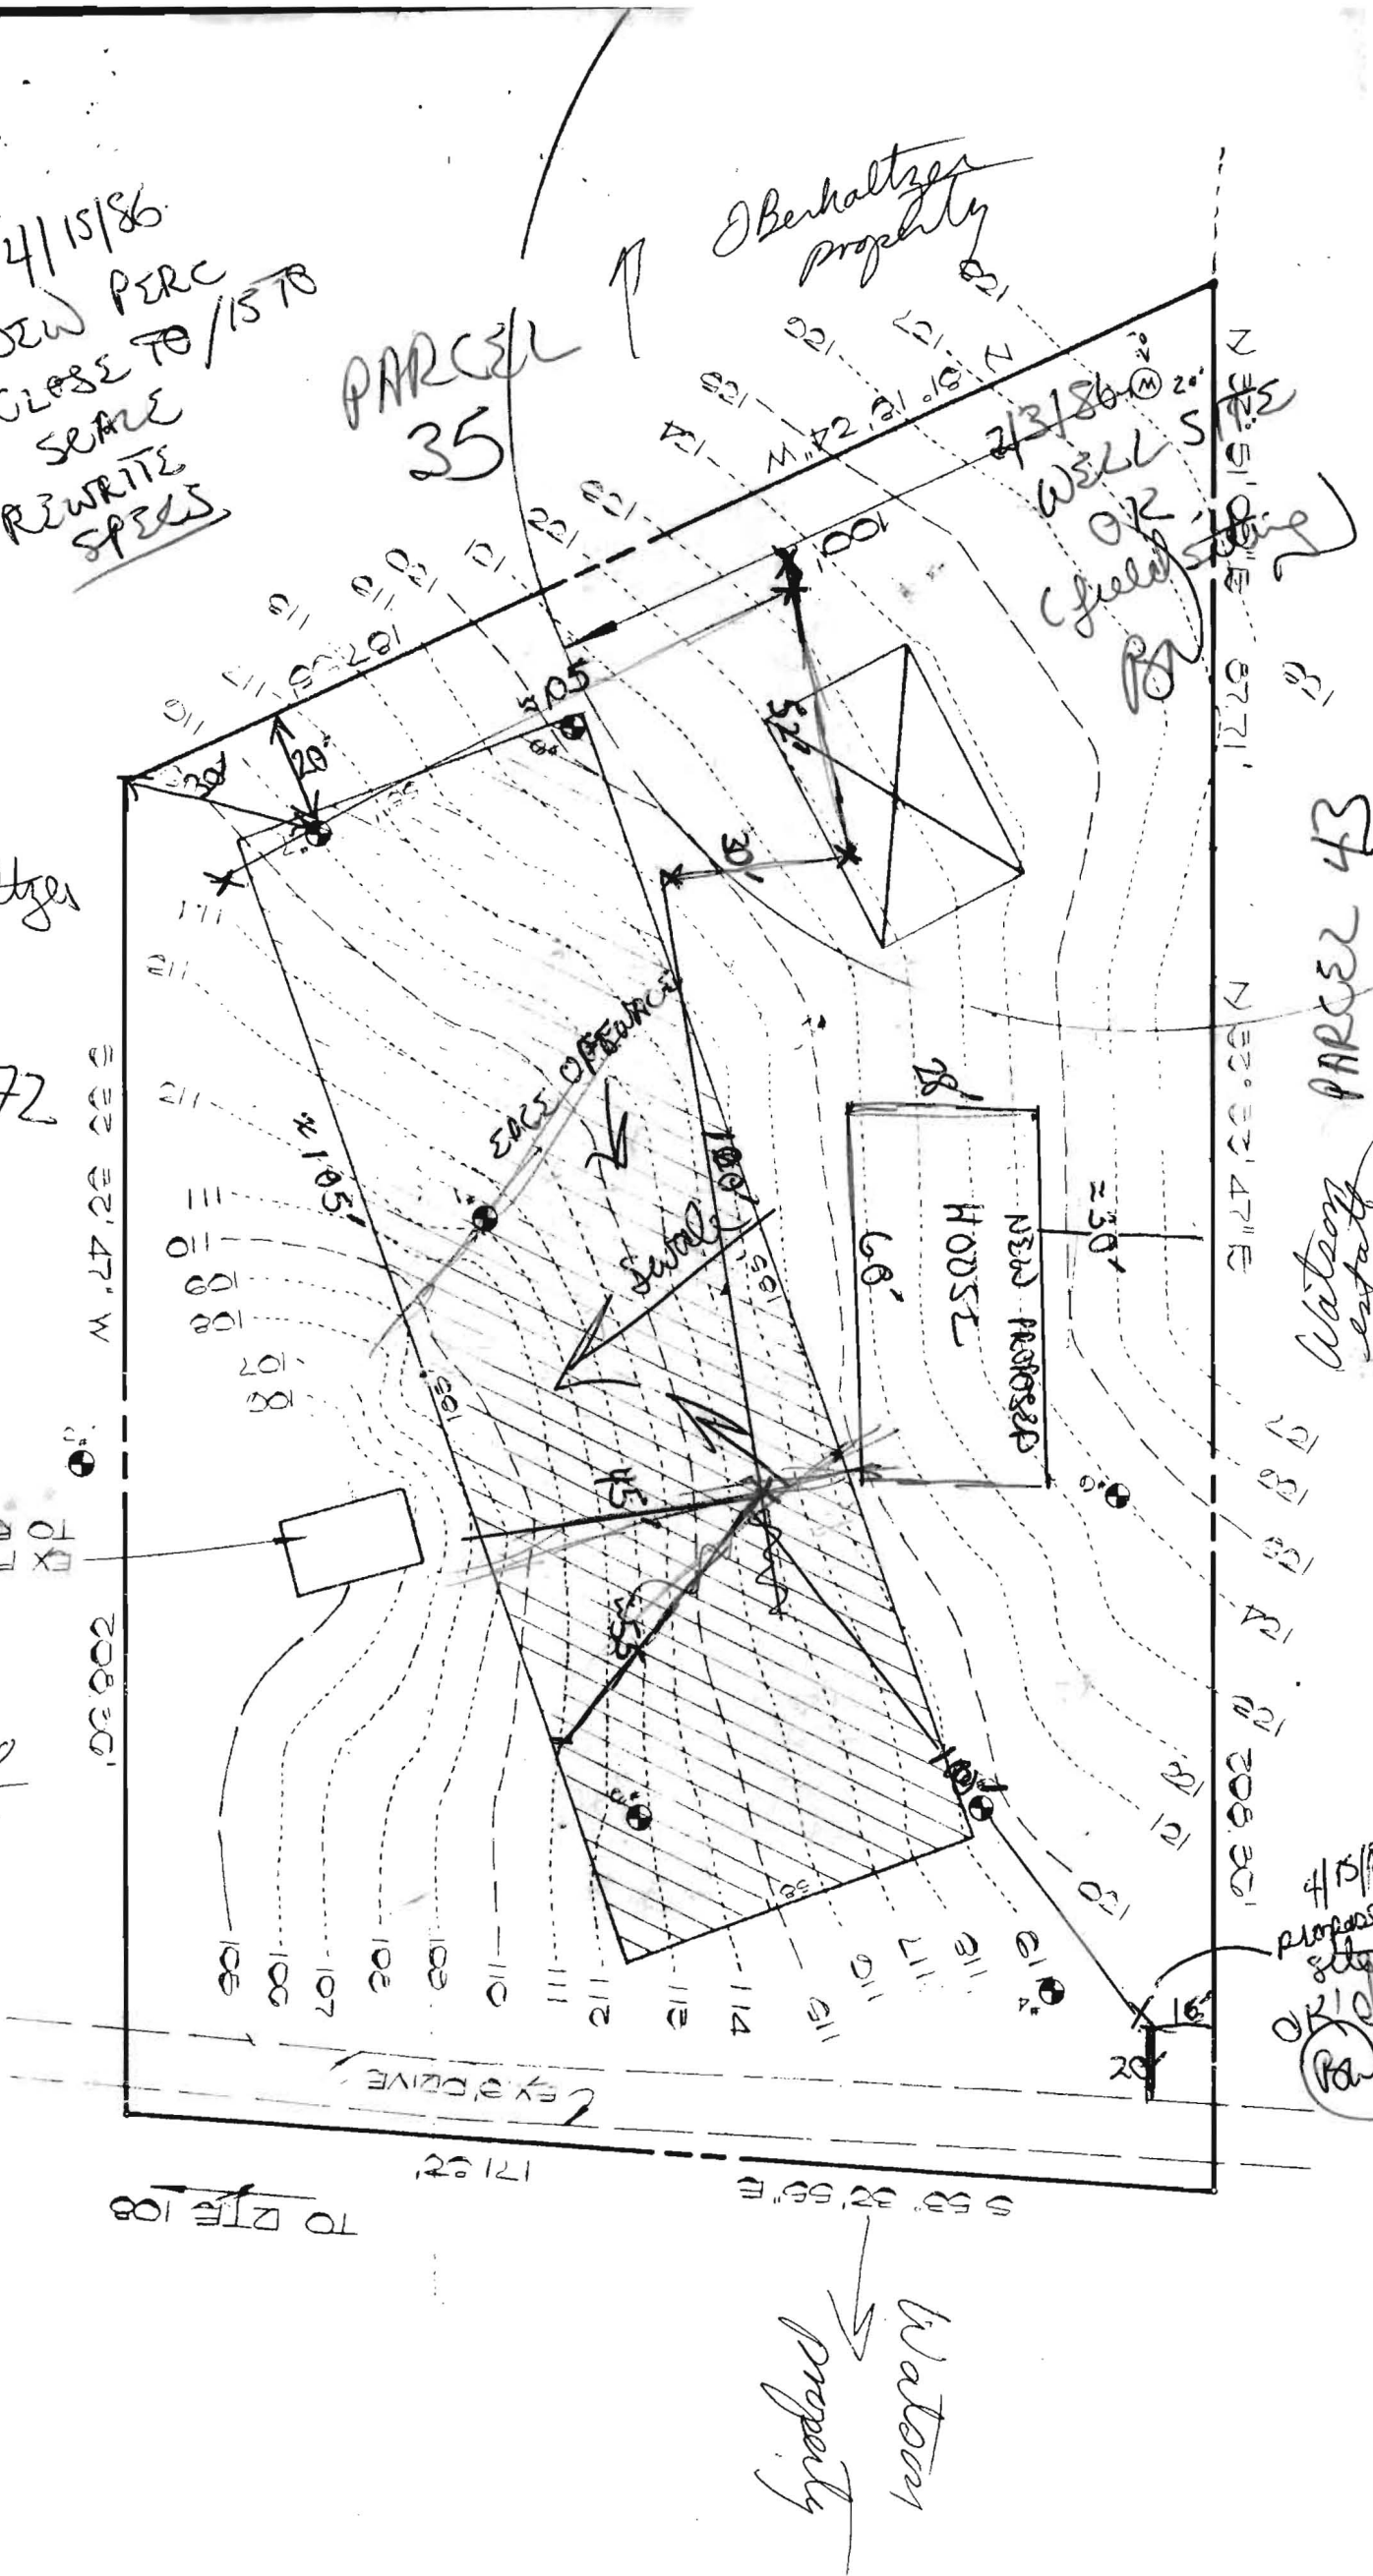

Walter + Ella Rydzewski  
 11680 Clarksville Pike  
 Clarksville Md 21029

531-2550

Ella - at work for messages

202-722-0510

