

# APPLICATION

A 17879  
F \_\_\_\_\_  
DISTRICT 3rd  
DATE 2/21/73

**SEWAGE DISPOSAL TESTING**  
**STATE OF MARYLAND - DEPARTMENT OF HEALTH AND MENTAL HYGIENE**  
**HOWARD COUNTY HEALTH DEPARTMENT**  
**ENVIRONMENTAL HEALTH SERVICES**  
P. O. BOX 476, ELLICOTT CITY, MARYLAND 21043  
TELEPHONE: 410-5866, EXT. 365

TO: THE COUNTY HEALTH OFFICER  
ELLICOTT CITY, MARYLAND

I, HEREBY, APPLY FOR THE NECESSARY TEST IN ORDER TO CONSTRUCT (OR RECONSTRUCT) A SEWAGE DISPOSAL SYSTEM.

PROPERTY OWNER JAMES F. Berlin  
ADDRESS 2602 Annapolis Road, Severn, Md, 21144 PHONE 569-9666

PROPERTY LOCATION:  
SUBDIVISION Breezeood Farms LOT NO. 14, Sect. 4  
ROAD AND DESCRIPTION Breezeood Drive

SIZE OF LOT 70,000 sq. ft. TYPE BLDG. 3 OF 4 BEDROOMS  
NUMBER OF BEDROOMS

IF NOT SINGLE RESIDENCE DESCRIBE \_\_\_\_\_

THE SYSTEM INSTALLED UNDER THIS APPLICATION IS ACCEPTABLE ONLY UNTIL PUBLIC FACILITIES BECOME AVAILABLE.

SIGNATURE OF APPLICANT /s/ William G. Rasche, II

APPROVED BY \_\_\_\_\_ FOR \_\_\_\_\_ DATE \_\_\_\_\_  
(KIND OF SYSTEM)


REJECTED BY \_\_\_\_\_ FOR \_\_\_\_\_ DATE \_\_\_\_\_  
(KIND OF SYSTEM)

HOLD PENDING FURTHER TESTS \_\_\_\_\_ DATE \_\_\_\_\_

REASONS FOR REJECTION OR HOLDING \_\_\_\_\_  
\_\_\_\_\_  
\_\_\_\_\_

# THIS IS NOT A PERMIT

7-10-73  
 12-27-73  
 1-18-74

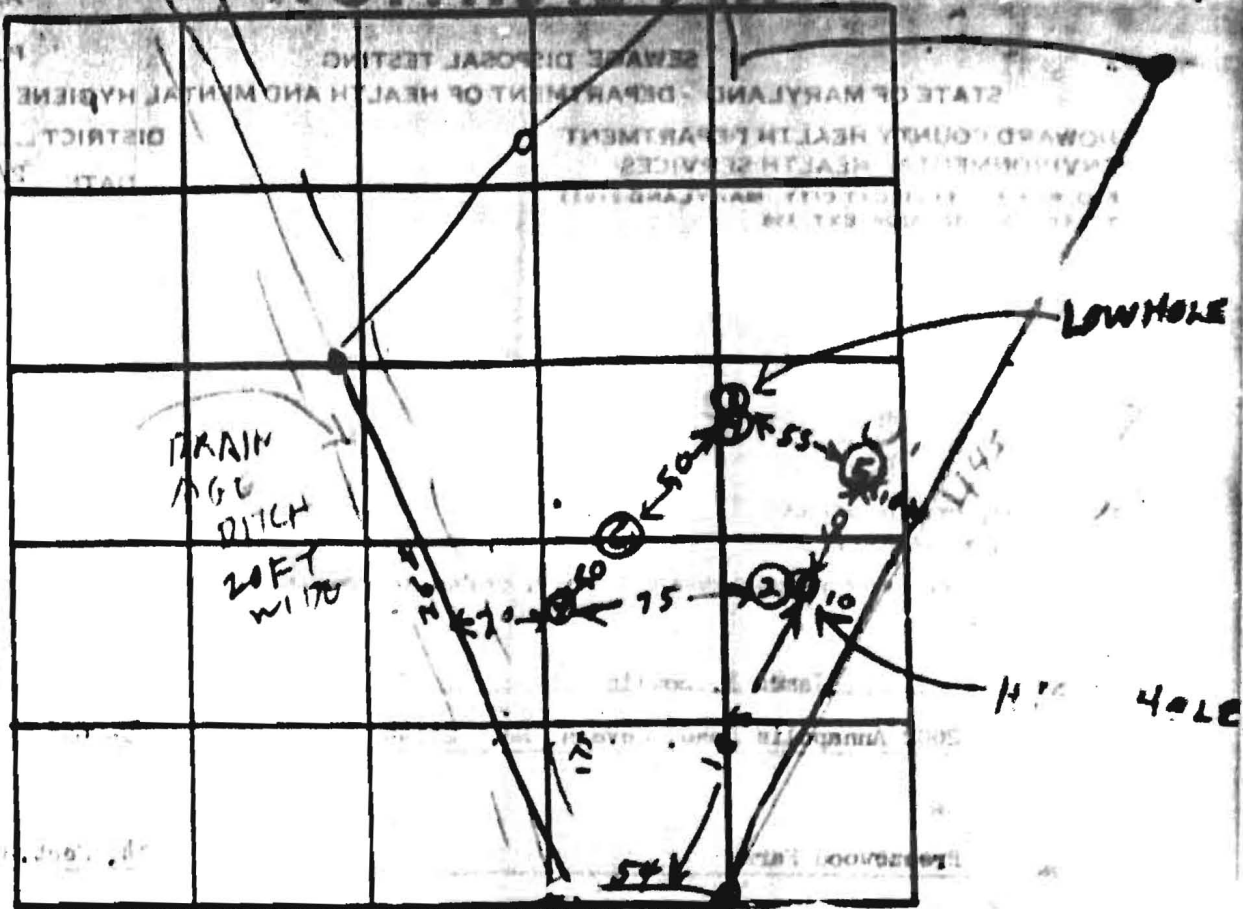

INDICATE NORTH - NAME ADJOINING ROADWAY AT EACH LINE

BRECKENRIDGE

DATE	TEST NO.	DEPTH	PRE-WET		TEST - 1" DROP		TIME
			START	STOP	START	STOP	
4/15/73	1	2	1144	1146	1146	1149	3
	2	11	1145	1146	1146	1147	1
	3	10	1151	1152	1152	1158	7
	4	2	1151	1202	1202	1215	17
	5	1 1/2	ALL SAND		Dry		
4/13/73	6	7	TOP 7 FEET SAND		BOLT BOTTOM		Dry
4/17/73	7		VISUAL				

HIGH HOLE  
 all sand  
 Low HOLE  
 av. time  
 7 min  
 Mandrel  
 3 FT.

REMARKS 4/13/73 Dig Another Visual Hole to extend distance  
 TYPE OF SOIL Holes too close together for close. let line  
 TESTED BY R. J. [Signature] ALSO PRESENT: [Signature]