

PRELIMINARY

APPLICATION

A 17981

SEWAGE DISPOSAL TESTING

P _____

STATE OF MARYLAND - DEPARTMENT OF HEALTH AND MENTAL HYGIENE

*4/21/77
1:30 p.m.*

HOWARD COUNTY HEALTH DEPARTMENT
ENVIRONMENTAL HEALTH SERVICES

DISTRICT 3rd

P. O. BOX 476, ELLICOTT CITY, MARYLAND 21043
TELEPHONE: 465-5000, EXT. 356

DATE 2/21/73

TO: THE COUNTY HEALTH OFFICER
ELLICOTT CITY, MARYLAND

I, HEREBY, APPLY FOR THE NECESSARY TEST IN ORDER TO CONSTRUCT (OR RECONSTRUCT) A SEWAGE DISPOSAL SYSTEM.

PROPERTY OWNER James F. Bowlin

ADDRESS 2602 Annapolis Road, Severn, Md. 21144 PHONE 569-9666

PROPERTY LOCATION:

SUBDIVISION Breezewood Farms LOT NO. 16, Sect. 4

ROAD AND DESCRIPTION Breezewood Drive

SIZE OF LOT 87,000 sq. ft. TYPE BLDG. 3 or 4 bedrooms
NUMBER OF BEDROOMS

IF NOT SINGLE RESIDENCE DESCRIBE _____

THE SYSTEM INSTALLED UNDER THIS APPLICATION IS ACCEPTABLE ONLY UNTIL PUBLIC FACILITIES BECOME AVAILABLE.

SIGNATURE OF APPLICANT /s/ William G. Rasche, II

APPROVED BY _____ FOR _____ DATE _____
(KIND OF SYSTEM)

REJECTED BY _____ FOR _____ DATE _____
(KIND OF SYSTEM)

HOLD PENDING FURTHER TESTS BJH DATE 4/29/73

REASONS FOR REJECTION OR HOLDING 4/29/73 - No space to put well

on high part of lot sufficient distance from sewage disposal areas on the lot & lot 17

12/22/75 - Listed as NON BUILDABLE ON FINAL signed by Dr. Loga 11/29/76

THIS IS NOT A PERMIT

5/17/77 Called 465 8551 could not get answer

INDICATE NORTH. - NAME ADJOINING ROADWAY AS BASE LINE.

DATE	TEST NO.	DEPTH	PRE-WET		TEST - 1" DROP		TIME
			START	STOP	START	STOP	
4/21/77	11D	9	144	150	150	203	13
	11S	2 1/2	144	145	145	148	3
	12S	3	157	159	159	201	2
	12D	10	158	204	204	212	8
4/21/77	13V	11	ALL SANDY				

REMARKS 4/21/77 - Rock Bottom Cannot Dig below 11 FT RH

TYPE OF SOIL _____

TESTED BY R. HODGES ALSO PRESENT: HARRIS
4/21/77 D. MURTUE

PRELIMINARY

APPLICATION

A 17981

SEWAGE DISPOSAL TESTING

P _____

STATE OF MARYLAND - DEPARTMENT OF HEALTH AND MENTAL HYGIENE

HOWARD COUNTY HEALTH DEPARTMENT
ENVIRONMENTAL HEALTH SERVICES
P. O. BOX 476, ELLICOTT CITY, MARYLAND 21043
TELEPHONE: 465-5000, EXT. 356

DISTRICT 3rd

DATE 2/21/73

TO: THE COUNTY HEALTH OFFICER
ELLICOTT CITY, MARYLAND

I, HEREBY, APPLY FOR THE NECESSARY TEST IN ORDER TO CONSTRUCT (OR RECONSTRUCT) A SEWAGE DISPOSAL SYSTEM.

PROPERTY OWNER James F. Bowlin

ADDRESS 2602 Annapolis Road, Severn, Md. 21144 PHONE 569-9666

PROPERTY LOCATION:

SUBDIVISION Breezewood Farms LOT NO. 16, Sect. 4

ROAD AND DESCRIPTION Breezewood Drive

SIZE OF LOT 87,000 sq. ft. TYPE BLDG. 3 or 4 bedrooms
NUMBER OF BEDROOMS

IF NOT SINGLE RESIDENCE DESCRIBE _____

THE SYSTEM INSTALLED UNDER THIS APPLICATION IS ACCEPTABLE ONLY UNTIL PUBLIC FACILITIES BECOME AVAILABLE.

SIGNATURE OF APPLICANT /s/ William G. Rasche, II


APPROVED BY _____ FOR _____ DATE _____
(KIND OF SYSTEM)

REJECTED BY _____ FOR _____ DATE _____
(KIND OF SYSTEM)

HOLD PENDING FURTHER TESTS _____ DATE _____

REASONS FOR REJECTION OR HOLDING _____

THIS IS NOT A PERMIT

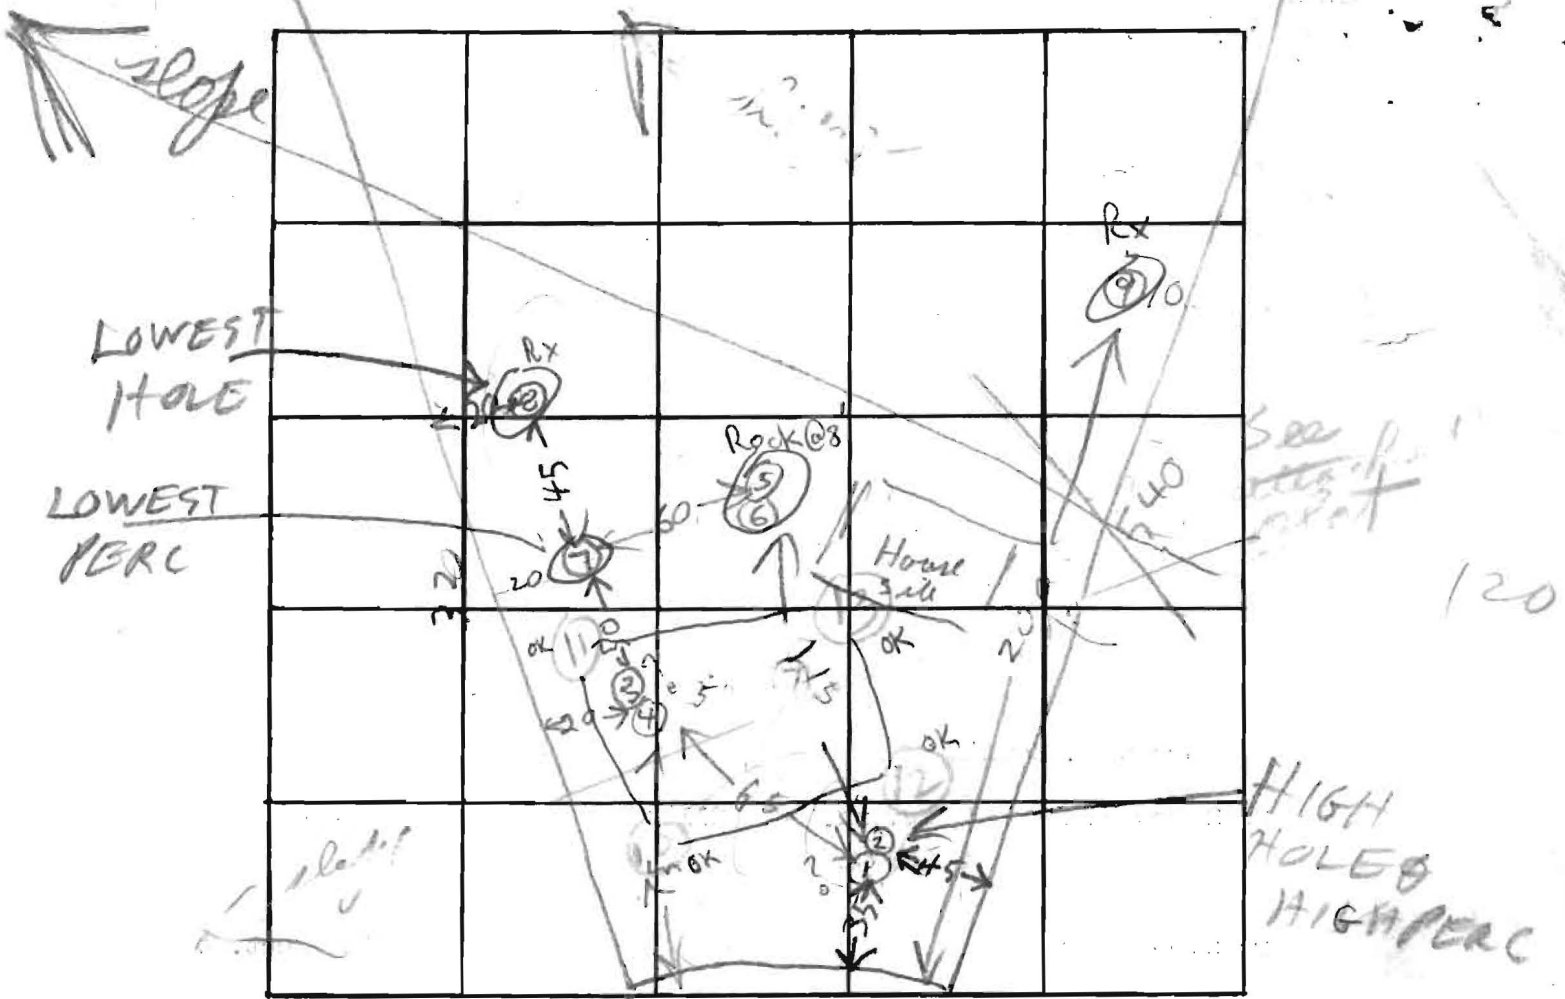

INDICATE NORTH. - NAME ADJOINING ROADWAY AS BASE LINE.

BREEZEWOOD FARM

DATE	TEST NO.	DEPTH	PRE-WET		TEST - 1" DROP		TIME
			START	STOP	START	STOP	
4/17/73	1	4	219	233	233	244	11
	2	12	All Soft Sand Duff		Dangerous to test		
	3	2	230	233	235	235	2
	4	4	Top 4 FT Sand		Rock Bottom		
	5	2	233	234	234	235	1
	6	8	Top 2 FT Sand		Rock Bottom		
	7	2 1/2	235	240	240	245	5
	8	7	All Sand		Rock Bottom		1 Day
4/17/73	9	7	all Sand		Rock Bottom		Duff
4/19/77	10 S	3	1135	137	137	141	4 min
	10 D	10	135	143	143	156	13

REMARKS

TYPE OF SOIL

TESTED BY

ALSO PRESENT:

Let 16 Sec 4

BREELEWOOD FARMS Sect 4
Breezewood Farms

Lot 16 sect 4

8/14/79 Rejected

- ① Show sewage disposal area & well on adjacent lots
- ② Show elevation of house site & well sites
- ③ Must state that perc holes are field located

8/15/79

Discussed above with Chuck Crovo He will make corrections R18

8/15/79 Plat picked up for corrections

8/29/79 Revised Plat OIC for Health Officer to sign R18

8/29/79 DM said get elevation of Wells

Discussed above with Mr Crovo

He is going to submit an accurate

^{0V00} Elevation for the Lot 16 But would like to submit a less precise elevation for wells on adjacent lots since it doesn't matter whether or not those wells are higher or lower than the septic system on lot 16 also Told Mr Crovo

8/29/79 - Told Mr Crovo
That The penciled lines & letter
must be changed to ink RM
Some one picked up plat