



Building Permit Application

Howard County Maryland
Department of Inspections, Licenses and Permits
3430 Court House Drive
Permits: 410-313-2455
www.howardcountymd.gov

Date Received: _____

Permit No.: _____

Proposing Address: 12309 Autumn Lane
Clarksville State: MD Zip Code: 21209

Unit/Apt. # _____ SDP/WP/BA #: _____

Lot/Tract: _____ Subdivision: _____

Location: _____ Area: _____ Lot: _____

Map: _____ Parcel: _____ Grid: _____

Map Coordinates: _____ Lot Size: _____

Proposing Use: _____

Proposed Use: inground swimming Pool

Estimated Construction Cost: \$ 40,000.00

Description of Work: install a 20x40 inground concrete swimming pool w/ cartridge filter, fenced to code filled by tanker

Occupant or Tenant: _____

Has tenant space previously occupied? Yes No

Contact Name: _____

Address: _____

City: _____ State: _____ Zip Code: _____

Phone: _____ Fax: _____

Email: _____

Property Owner's Name: Ed Sues
Address: 12309 Autumn Lane
City: Clarksville State: MD Zip Code: 21209
Phone: 410-808-6988 Fax: _____
Email: _____

Applicant's Name & Mailing Address, (If other than stated herein)
Applicant's Name: Dustin Gagon
Address: Baltimore Pulaski Hwy
City: Baltimore State: MD Zip Code: 21237
Phone: 443-220-3781 Fax: _____
Email: Dustin@ElitePools.com

Contractor Company: Elite Pools
Contact Person: Dustin Gagon
Address: 8335 Pulaski Hwy
City: Baltimore State: MD Zip Code: 21237
License No.: 71753
Phone: 443-220-3781 Fax: 443-927-8000
Email: Dustin@elite

Engineer/Architect Company: Elite Pools
Responsible Design Prof.: _____
Address: _____
City: _____ State: _____ Zip Code: _____
Phone: _____ Fax: _____
Email: _____

Commercial Building Characteristics	Residential Building Characteristics	
Height:	<input type="checkbox"/> SF Dwelling <input type="checkbox"/> SF Townhouse	
No. of stories:	Depth	Width
Gross area, sq. ft./floor:	1 st floor:	
	2 nd floor:	
Area of construction (sq. ft.):	Basement:	
	<input type="checkbox"/> Finished Basement	
Use group:	<input type="checkbox"/> Unfinished Basement	
	<input type="checkbox"/> Crawl Space	
Construction type:	<input type="checkbox"/> Slab on Grade	
Reinforced Concrete	No. of Bedrooms:	
Structural Steel	Multi-family Dwelling	
Masonry	No. of efficiency units:	
Wood Frame	No. of 1 BR units:	
State Certified Modular	No. of 2 BR units:	
	No. of 3 BR units:	
	Other Structure:	
	Dimensions:	
Roadside Tree Project Permit	Footings:	
<input type="checkbox"/> Yes <input type="checkbox"/> No	Roof:	
Roadside Tree Project Permit #	<input type="checkbox"/> State Certified Modular	
	<input type="checkbox"/> Manufactured Home	

Utilities	
Water Supply	
<input type="checkbox"/> Public	
<input checked="" type="checkbox"/> Private	
Sewage Disposal	
<input checked="" type="checkbox"/> Public	
<input type="checkbox"/> Private	
Electric: <input type="checkbox"/> Yes <input type="checkbox"/> No	
Gas: <input type="checkbox"/> Yes <input type="checkbox"/> No	
Heating System	
<input type="checkbox"/> Electric <input type="checkbox"/> Oil	
<input type="checkbox"/> Natural Gas <input type="checkbox"/> Propane Gas	
<input type="checkbox"/> Other:	
Sprinkler System:	
<input type="checkbox"/> Yes <input type="checkbox"/> No	
Grading Permit Number: _____	
Building Shell Permit Number: _____	

UNDERSIGNED HEREBY CERTIFIES AND AGREES AS FOLLOWS: (1) THAT HE/SHE IS AUTHORIZED TO MAKE THIS APPLICATION; (2) THAT THE INFORMATION IS CORRECT; (3) THAT HE/SHE WILL COMPLY WITH REGULATIONS OF HOWARD COUNTY WHICH ARE APPLICABLE THERETO; (4) THAT HE/SHE WILL PERFORM NO WORK ON THE ABOVE REFERENCED PROPERTY NOT SPECIFICALLY DESCRIBED IN THIS APPLICATION; (5) THAT HE/SHE GRANTS COUNTY OFFICIALS THE RIGHT TO ENTER ONTO THIS PROPERTY FOR THE PURPOSE OF INSPECTING THE WORK PERMITTED AND POSTING NOTICES.

Applicant's Signature: Dustin Gagon
 Email Address: Dustin@ElitePools.com
 Title: Project Manager / Elite Pools
 Company: _____

Print Name: Dustin Gagon
 Date: 9/17/15


Checks Payable to: DIRECTOR OF FINANCE OF HOWARD COUNTY
 PLEASE WRITE NEATLY & LEGIBLY
 -FOR OFFICE USE ONLY-

AGENCY	DATE	SIGNATURE OF APPROVAL
Highways		
Planning Officials (Zoning)		
Engineering		
	<u>9/17/15</u>	<u>H. Oswald</u>

DPZ SETBACK INFORMATION	
Front:	
Rear:	
Side:	
Side St.:	
All minimum setbacks met?	<input type="checkbox"/> Yes <input type="checkbox"/> No
Is Entrance Permit Required?	<input type="checkbox"/> Yes <input type="checkbox"/> No
Historic District?	<input type="checkbox"/> Yes <input type="checkbox"/> No
Lot Coverage for New Town Zone:	
SDP/Red-line approval date:	


Filing Fee	\$
Permit Fee	\$
Tech Fee	\$
Excise Tax	\$
PSFS	\$
Guaranty Fund	\$
Add'l per Fee	\$
Total Fees	\$
Sub-Total Paid	\$
Balance Due	\$
Check	#

THIS WALL CHECK DRAWING CONTAINS A HORIZONTAL TOLERANCE IN ACCURACY OF 0.1' AND A VERTICAL TOLERANCE IN ACCURACY OF 0.2'

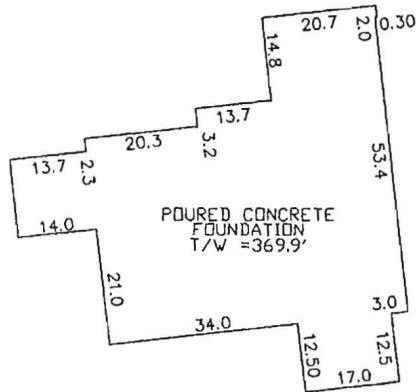

DETAIL

APPROVED
 WALK-THRU BUILDING PERMIT
 BP# _____ A# _____
 APE SAN H. Oswald DATE: 9/17/15
 DESC. OF WORK: Install 20'x40' underground concrete pool.

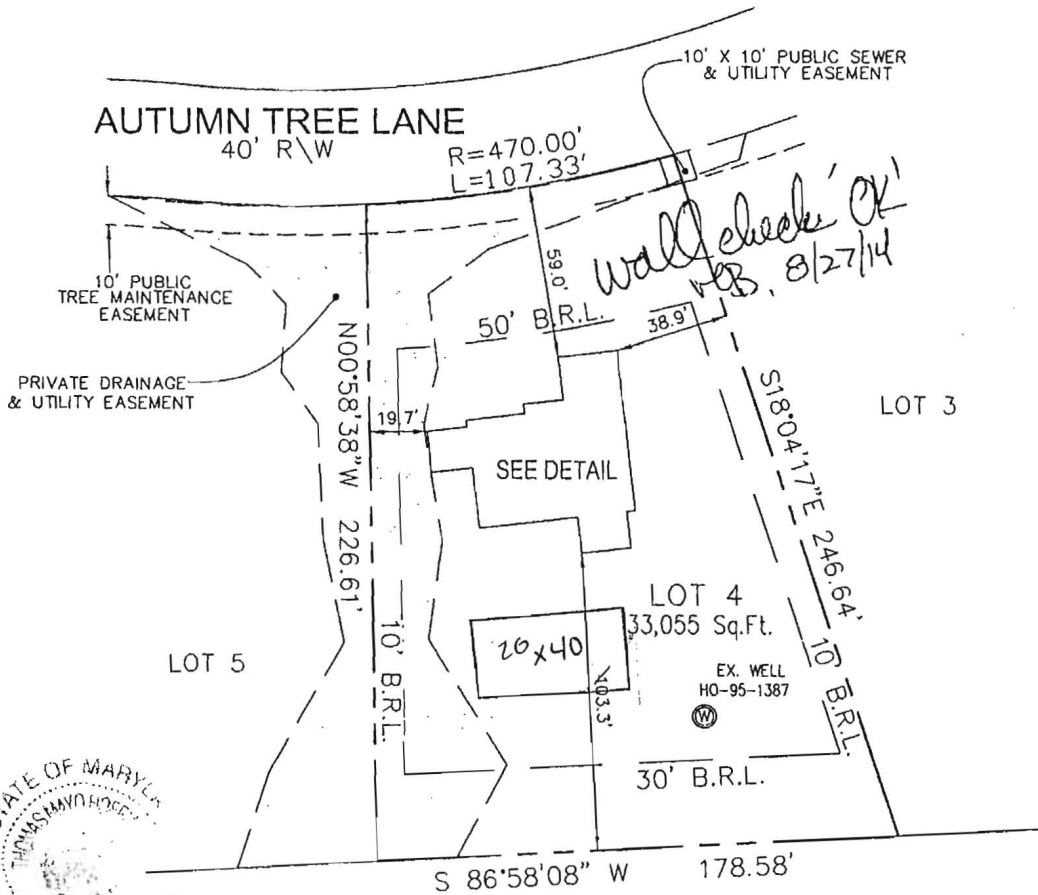

wall check OK
RHS, 8/27/14



I HEREBY CERTIFY TO THE BEST OF MY KNOWLEDGE, INFORMATION AND BELIEF THAT THE IMPROVEMENTS ARE LOCATED AS SHOWN AND THERE ARE NO ENCROACHMENTS EXCEPT AS SHOWN.

Thomas M. Hoffman Jr. **7.31.14**
 THOMAS M. HOFFMAN JR., PROPERTY LINE SURVEYOR #267 DATE

PROFESSIONAL CERTIFICATION: I HEREBY CERTIFY THAT THESE DOCUMENTS WERE PREPARED BY ME OR UNDER MY RESPONSIBLE CHARGE, AND THAT I AM A DULY LICENSED PROPERTY LINE SURVEYOR UNDER THE LAWS OF THE STATE OF MARYLAND, LICENSE NO. 267, EXPIRATION DATE JULY 28, 2014.

BUILDING PERMIT #14001550

SCALE 1" = 50'	DATE 07/30/14
DRAWN BY R.E.D.	CHECKED BY T.M.H.
PLAT NUMBER 20631-20647	JOB NUMBER 13-21.00

ROBERT H. VOGEL ENGINEERING, INC.
 ENGINEERS - SURVEYORS - PLANNERS
 8407 MAIN STREET
 ELLICOTT CITY, MARYLAND 21043
 TEL: 410-461-7666 FAX: 410-461-8961

WALL CHECK DRAWING
 12309 AUTUMN TREE LANE
 LOT 4
 WALNUT CREEK
 PLAT NO. 20632
 FIFTH ELECTION DISTRICT
 HOWARD COUNTY, MARYLAND

**SEUSS
 RESIDENCE
 HOWARD COUNTY**

THIS DOCUMENT AND THE DATA AND DESIGN INFORMATION CONTAINED HEREIN ARE THE PROPERTY OF HERITAGE ELITE, A LANDSCAPE ARCHITECTURE FIRM. IT IS NOT TO BE COPIED AND/OR USED IN WHOLE OR IN PART FOR ANY OTHER PROJECTS WITHOUT THE WRITTEN APPROVAL OF HERITAGE ELITE, LANDSCAPE ARCHITECTURE, INC.

OWNER:
 Seuss
 12309 Autumn Tree Lane
 Clarksville, MD 21209


DIRECTIONS:

REVISION	DATE
Patlo + Landscape	8/18/2015


- GENERAL NOTES**
1. Written dimensions shall prevail over scaled dimensions.
 2. The written approval of any owner shall bind all others.
 3. It is the responsibility of the owner to provide the contractor with adequate access for heavy trucks and construction materials.
 4. The contractor is not responsible for damages which may occur due to equipment moving onto the site.
 5. Heritage guarantees all work, hardcopies and plotted plant material, for a period of one year.
 6. Contractor licensed by the Maryland Home Improvement Commission.

CLIENT SIGNATURE:

DESIGN: TL
 DRAWN: TL
 CHECKED: AH

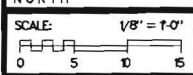

DATE: 8/7/2015

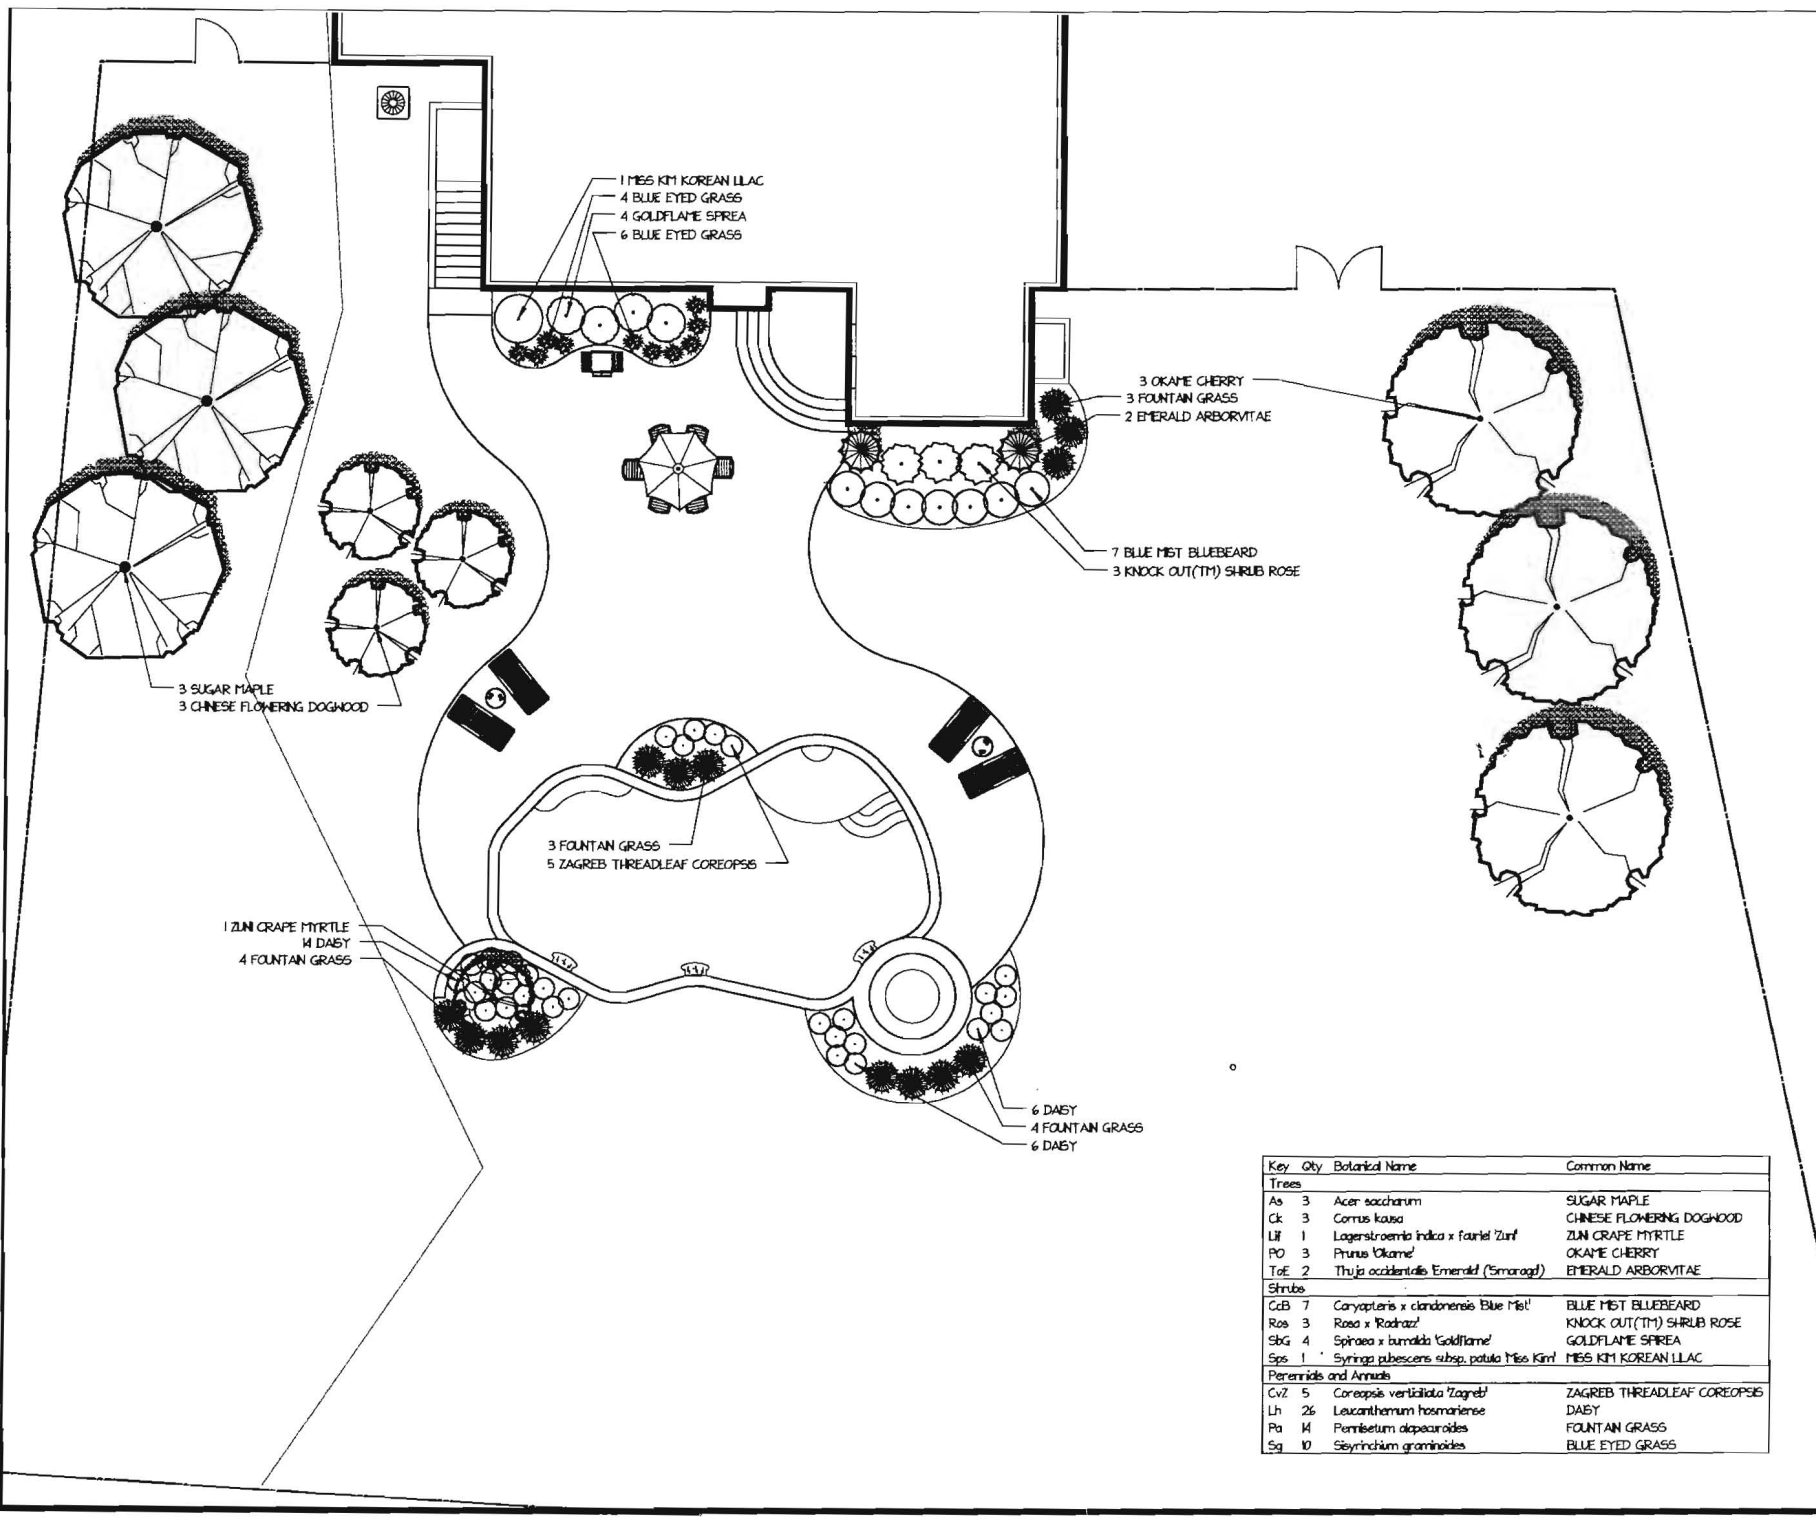

Key	Qty	Botanical Name	Common Name
Trees			
As	3	<i>Acer saccharum</i>	SUGAR MAPLE
Ck	3	<i>Cornus kousa</i>	CHINESE FLOWERING DOGWOOD
Lil	1	<i>Lagerstroemia indica</i> x <i>fauriei</i> 'Zuni'	ZUNI GRAPE MYRTLE
PO	3	<i>Prunus 'Okame'</i>	OKAME CHERRY
TrE	2	<i>Thuja occidentalis</i> 'Emerald' (Emerald)	EMERALD ARBORVITAE
Shrubs			
CoB	7	<i>Corydalis</i> x <i>clandonensis</i> 'Blue Mist'	BLUE MIST BLUEBEARD
Ros	3	<i>Rosa</i> x <i>Rodraz'</i>	KNOCK OUT (TM) SHRUB ROSE
SbG	4	<i>Spiraea</i> x <i>burnaldii</i> 'Goldflame'	GOLDFLAME SPIREA
Sps	1	<i>Syringa pubescens</i> subsp. <i>patula</i> 'Mes Kim'	MES KIM KOREAN LILAC
Perennials and Annuals			
CvZ	5	<i>Coreopsis verticillata</i> 'Zagreb'	ZAGREB THREADLEAF COREOPSIS
Lh	26	<i>Leucanthemum hosmerianse</i>	DAEY
Pa	14	<i>Pennisetum alopecuroides</i>	FOUNTAIN GRASS
Sg	10	<i>Seyrinchium graminoides</i>	BLUE EYED GRASS