

APPLICATION

PERCOLATION TESTING

HOWARD COUNTY HEALTH DEPARTMENT
BUREAU OF ENVIRONMENTAL HEALTH
P.O. BOX 476 ELLICOTT CITY, MARYLAND 21043
TELEPHONE: 461-9933

A 43249 ✓

P _____

DISTRICT 4

DATE 12/9/88

TO: THE COUNTY HEALTH OFFICER
ELLICOTT CITY, MARYLAND

I HEREBY, APPLY FOR THE NECESSARY TEST IN ORDER TO CONSTRUCT (OR RECONSTRUCT) A SEWAGE DISPOSAL SYSTEM.

PROPERTY OWNER Egwood Farm Inc C/O Land Design + Development

ADDRESS 8307 Main St PHONE 461-4600

PROSPECTIVE BUYER N/A

ADDRESS _____ PHONE _____

PROPERTY LOCATION:

SUBDIVISION Clark Syonvale LOT NO. 12 New # 11
Final

ROAD AND DESCRIPTION Roxbury + Dorsey Mill

TAX MAP 21 PARCEL # 6

SIZE OF LOT - 3.4 AC. TYPE BLDG. SFD
(SINGLE FAMILY DWELLING OR COMMERCIAL)

THE SYSTEM INSTALLED UNDER THIS APPLICATION IS ACCEPTABLE ONLY UNTIL PUBLIC FACILITIES BECOME AVAILABLE. I FULLY UNDERSTAND THE

FEE CONNECTED WITH THE FILING OF THIS PERC TEST APPLICATION IS NON-REFUNDABLE UNDER ANY CIRCUMSTANCES. I ALSO AGREE TO COMPLY

WITH ALL M.O.S.H.A. REQUIREMENTS IN TESTING THIS LOT. Mal D. Reil
(SIGNATURE OF APPLICANT)

APPROVED BY _____ FOR _____ DATE _____

REJECTED BY _____ FOR _____ DATE _____

HOLD PENDING FURTHER TESTS _____ DATE _____

REASONS FOR REJECTION OR HOLDING _____

THIS IS NOT A PERMIT

HD-216


A 43249

New # 11

#12

#13

SOIL PROFILE

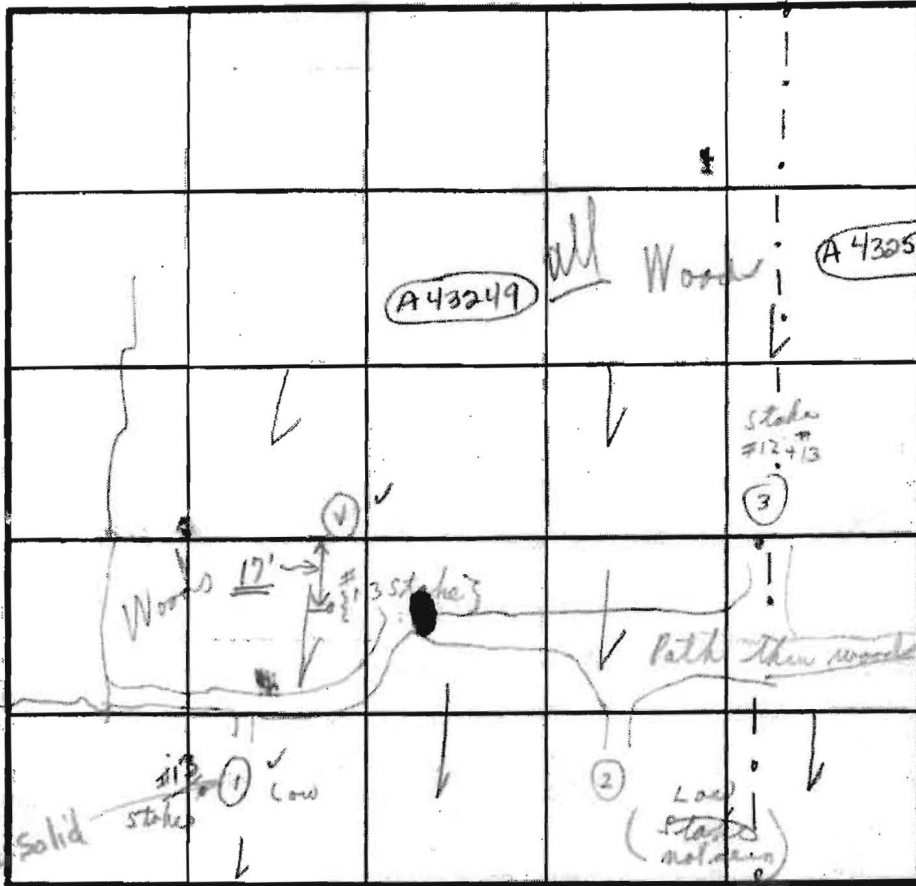

In 4
Bot 6
180' BR

~~Unsettled~~
average 29 min

240-300 ft on
Repairs

INDICATE NORTH - NAME ADJOINING ROADWAY AS BASE LINE.

DATE	TEST NO.	DEPTH	PRE-WET		TEST - 1" DROP		TIME
			START	STOP	START	STOP	
1/10/89	①	0'	2:12	2:20	2:20	2:49	29
Tues	②	10 1/2'			solid		
11"-K ^{1/2} -clay	③	6'	2:43	2:45	2:45	2:48	3 min
Sandy loam 4"-12" 8"	④	12' 8"			Visual light loam		
Sandy loam	⑤	4'	2:27	2:29	2:29	2:32	3 min
Clay to bedrock	⑥	7 1/2'	2:25	2:26	2:26	2:28	2 min
Loam	⑦				Visual 11 1/2'		
(= 23 1/2" clay)	⑧	6 1/2'	2:37	2:38	2:38	2:41	3 min
Sandy loam	⑨	3 1/2' 12'	Loam &		Visual		Visual

Note
Poured
own water
4 parts 20%
small rock
Some surface
rock
Dry to 3'
12"
Dry to
12 1/2'

REMARKS Tests per stake; Tests on heavy woods
TYPE OF SOIL (Note 2 Backhoes + 5 men all day)
TESTED BY C. R. P. ALSO PRESENT { Damers rest of day }