

C 1 3880-  
SEQUENCE NO. (DWR USE ONLY)  
1 P. 2 3 (SEQ. NO.)  
(THIS NUMBER IS TO BE PUNCHED IN COLS. 3-8 ON ALL CARDS)

STATE OF MARYLAND  
WATER RESOURCES ADMINISTRATION  
TAWES STATE OFFICE BLDG., ANNAPOLIS, MD. 21401  
WELL COMPLETION REPORT

THIS REPORT MUST BE SUBMITTED WITHIN 30 DAYS AFTER WELL COMPLETION.  
FILL IN THIS FORM COMPLETELY.  
COUNTY NUMBER

DATE RECEIVED (DWR USE ONLY)  
8-13

DATE WELL COMPLETED  
May 17 1974  
DEPTH OF WELL (TO NEAREST FOOT) 160

PERMIT NO. FROM "PERMIT TO DRILL WELL"  
H-C-73-0545  
DRILLERS IDENTIFICATION NO. 47

OWNER: Taylor, William  
STREET OR RFD: Clarksville  
POST OFFICE

WELL LOG

STATE THE KIND OF FORMATIONS PENETRATED, THEIR COLOR, DEPTH, THICKNESS AND IF WATER BEARING

DESCRIPTION (USE ADDITIONAL SHEETS IF NECESSARY)	FEET		CHECK IF WATER BEARING
	FROM	TO	
Top soil	0	2	
Sandy loam	2	14	
Small Stone	14	70	
Shale	70	160	

WELL DESCRIPTION

GROUTING RECORD

WELL HAS BEEN GROUTED (CIRCLE APPROPRIATE BOX)  Y  N

TYPE OF GROUTING MATERIAL (CIRCLE BOX):  
CEMENT  C  W BENTONITE CLAY  B  C

NO. OF BAGS 5 NO. OF POUNDS 500  
GALLONS OF WATER 30  
DEPTH OF GROUT SEAL (TO NEAREST FOOT)  
FROM 0 FT. TO 19 FT.

CASING RECORD

INSERT APPROPRIATE CODE BELOW  
STEEL  S  T CONCRETE  C  O  
PLASTIC  P  L OTHER  O  T

MAIN CASING TYPE: S T  
NOMINAL DIAMETER TOP (MAIN) CASING (NEAREST INCH): 6  
TOTAL DEPTH OF MAIN CASING (NEAREST FOOT): 20

OTHER CASING (IF USED)  
DIAMETER (INCH) DEPTH (FEET) FROM TO

SCREEN RECORD

INSERT APPROPRIATE CODE BELOW  
STEEL  S  T BRASS OR BRONZE  B  R OPEN HOLE  H  O  
PLASTIC  P  L OTHER  O  T

PUMPING TEST

HOURS PUMPED (TO NEAREST HOUR) 2  
PUMPING RATE (GALLONS PER MINUTE TO NEAREST GALLON) 3  
METHOD USED TO MEASURE PUMPING RATE: hand test  
WATER LEVEL (DISTANCE FROM LAND SURFACE)  
BEFORE PUMPING: 15  
WHEN PUMPING: 160  
TYPE OF PUMP USED (CIRCLE APPROPRIATE BOX)  
AIR  A PISTON  P TURBINE  T  
CENTRIFUGAL  C ROTARY  R OTHER (DESCRIBE BELOW)  O  
JET  J SUBMERSIBLE  S

PUMP INSTALLED

TYPE OF PUMP (WRITE APPROPRIATE LETTER IN BOX - SEE ABOVE: A, C, J, P, R, S, T, O)

DRILLER WILL INSTALL PUMP (CIRCLE APPROPRIATE BOX) YES  Y NO  N

CAPACITY: GALLONS PER MINUTE (TO NEAREST GALLON) 31 38  
PUMP HORSE POWER 37 41  
PUMP COLUMN LENGTH (NEAREST FOOT) 43 47

CASING HEIGHT (CIRCLE APPROPRIATE BOX AND ENTER CASING HEIGHT)  
ABOVE  + BELOW  -  
LAND SURFACE 02 (NEAREST FOOT)

LOCATION OF WELL ON LOT  
SHOW PERMANENT STRUCTURE SUCH AS BUILDINGS, SEPTIC TANKS, AND/OR OTHER LAND MARKS AND INDICATE NOT LESS THAN TWO DISTANCES (MEASUREMENTS TO WELL).

CIRCLE APPROPRIATE BOXES

A WELL WAS ABANDONED AND SEALED WHEN THIS WELL WAS COMPLETED

E ELECTRIC LOG OBTAINED

P TEST WELL CONVERTED TO PRODUCTION WELL

I HEREBY CERTIFY THAT I HAVE COMPLIED WITH ALL CONDITIONS STATED ON THE ABOVE-CAPTIONED "PERMIT TO DRILL WELL", AND THAT INFORMATION CONTAINED IN THIS REPORT IS TRUE, ACCURATE, AND COMPLETE TO THE BEST OF MY KNOWLEDGE, INFORMATION AND BELIEF.

DRILLERS NAME: L.F. Easterday  
SIGNATURE: L.F. Easterday

DEPTH (NEAREST WHOLE FOOT) FROM TO

1 110 20 160  
2 23 24 28 30 32 36  
3 35 39 41 45 47 51


SLOT SIZE 1. 2. 3.


DIAMETER OF SCREEN 36 (NEAREST INCH) FROM TO

GRAVEL PACK

IF WELL DRILLED WAS A FLOWING WELL (CIRCLE BOX)  F

DWR USE ONLY (DO NOT BE FILLED IN BY DRILLER)  
TELESCOPE CASING  70 LOG INDICATOR  72 OTHER DATA AVAILABLE  74  75  76

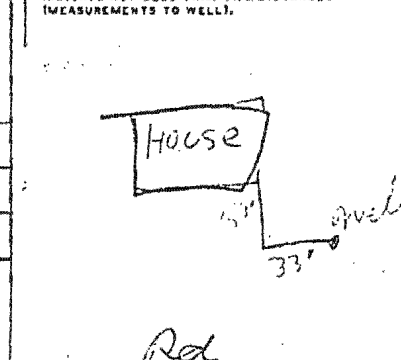

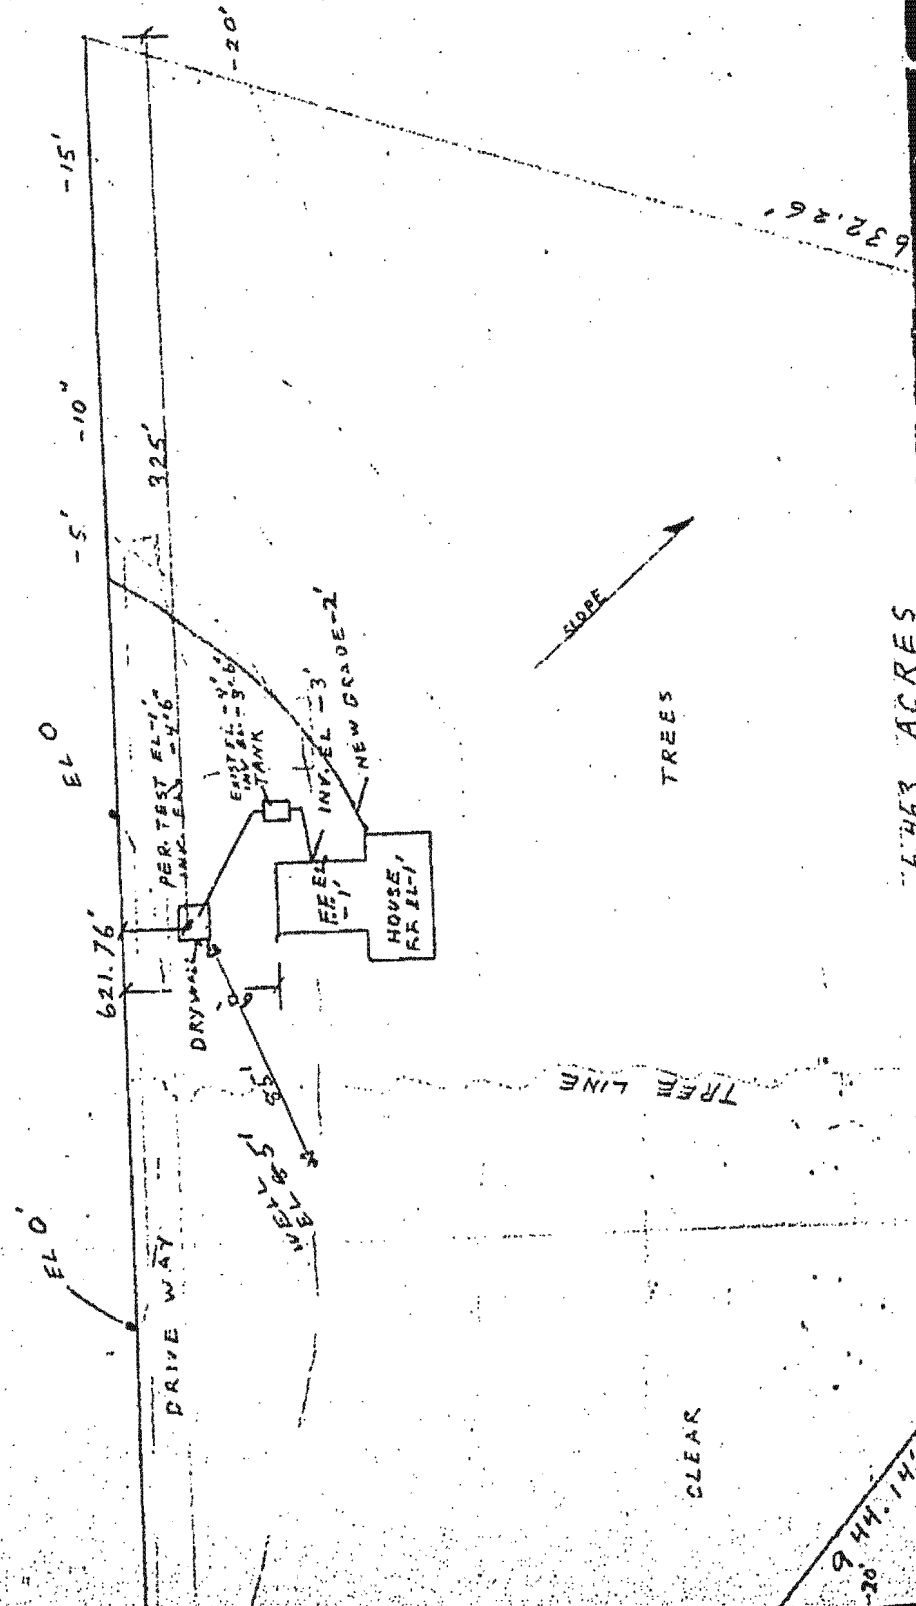

6.463 ACRES