

4/3/74  
final inspection

app. 4-3-74  
19006  
17493

# PERMIT

SEWAGE DISPOSAL SYSTEM

MARYLAND STATE DEPARTMENT OF HEALTH

HOWARD COUNTY

ELLICOTT CITY

## INDEXED

DISTRICT <sup>CDR</sup> 5th

DATE 9/24/73

Tattrie and Levy IS PERMITTED TO INSTALL  ALTER

ADDRESS 7000 Longview Road, Simpsonville, Md. 21150 PHONE 531-5266

A SEWAGE DISPOSAL SYSTEM LOCATED AT

SUBDIVISION ROAD Linden Chapel Road and Broadwater Road LOT Parcel 12

PROPERTY OWNER William M. & Barbara E. Taylor off Rt. 32 just above Rt. 108

ADDRESS

SPECIFICATIONS 3 bedrooms

DRAIN FIELD DEPTH FEET, BOTTOM AREA SQ. FT.

SEEPAGE PITS ABSORBENT SIDE-WALL AREA SQ. FT.

SEPTIC TANK CAPACITY 1000 GALLONS

FOR GARBAGE GRINDER, INCREASE DISPOSAL AREA 22% & TANK CAPACITY 50%.

OTHER DRY WELL - To have 120 sq. ft. effective absorbent sidewall area per bedroom below inlet. Inlet to be 4 ft. below original grade and maximum depth 12 ft. below original grade. Locate dry well 325 ft. from left back corner along left property line and in 25 ft. off left property line when facing lot from Broadwater Lane. Conditions: No basement facilities. Keep well 60 ft. off left line. Put dry well in proper location. Put system in first where directed on test is void, 10/4/73 - C.B.S.

NOTE: ALL PIPE FROM HOUSE TO DRY WELL MUST BE CAST IRON. PERMIT VOID AFTER THREE YEARS.

NOTE: INSTALL STAND PIPE ON SEPTIC TANK AND DRY WELL.


PLANS APPROVED BY Charles B. Stroaker & William Zepp DATE 11/10/72 and 9/18/73

FILL SEPTIC TANK AND DISTRIBUTION BOX WITH WATER BEFORE CALLING FOR AN INSPECTION. COVER NO WORK UNTIL INSPECTED AND APPROVED.

NEITHER THE HOWARD COUNTY COMMISSIONERS NOR THE HEALTH DEPARTMENT IS RESPONSIBLE FOR THE SUCCESSFUL OPERATION OF ANY SYSTEM.

A 17493

INSPECTOR DATE SYSTEM APPROVED

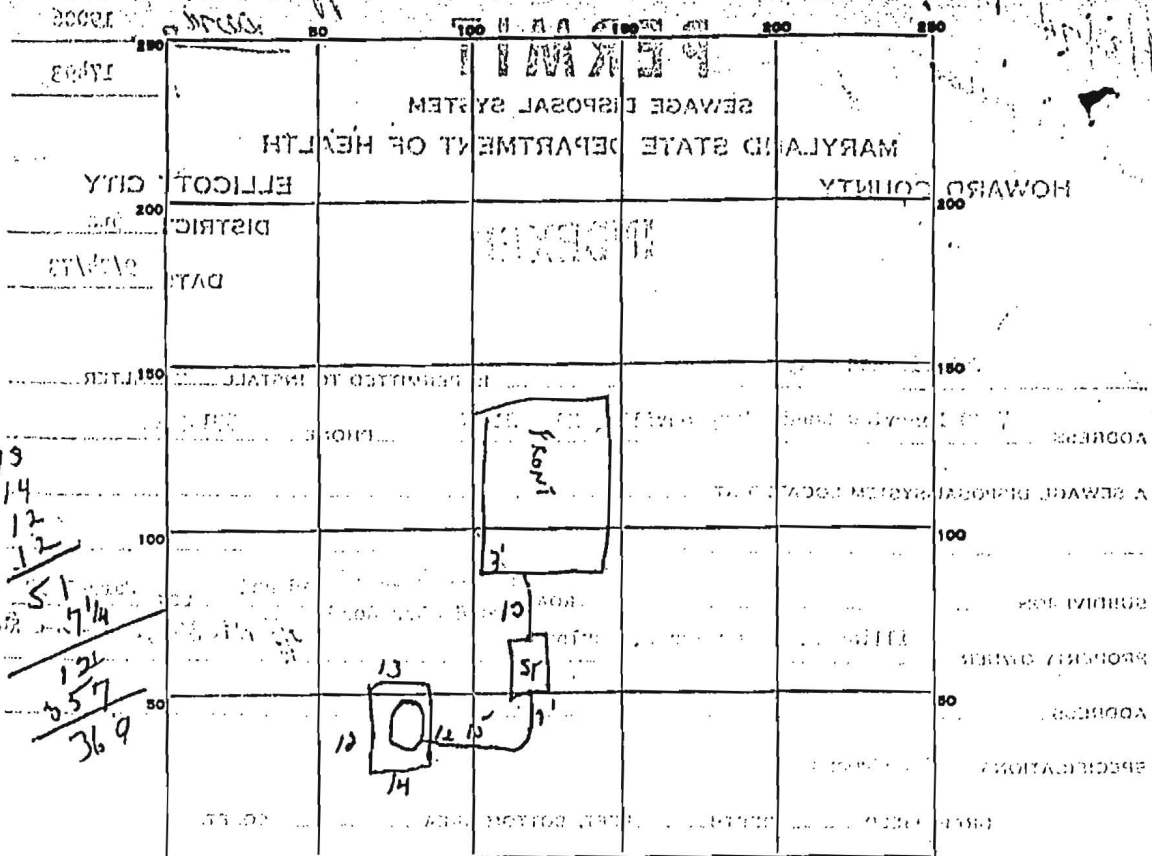

INDICATE NORTH - NAME ADJOINING ROADWAY AS BASE LINE.

PERMIT CARD OK

SEPTIC TANK, LEVEL OK CLEANOUTS OK

DISTRIBUTION BOX, LEVEL \_\_\_\_\_

TILE FIELD, DEPTH \_\_\_\_\_ FT. TRENCH WIDTH \_\_\_\_\_ FT.

GRAVEL DEPTH \_\_\_\_\_ IN. TOTAL LENGTH \_\_\_\_\_ FT.

NUMBER OF TRENCHES \_\_\_\_\_ TOTAL BOTTOM AREA \_\_\_\_\_

SEEPAGE PITS, INSIDE DIAMETER Perimeter 51 FT. DEPTH BELOW INLET 73" FT.

ABSORBENT AREA 369 SQ. FT.

REMARKS \_\_\_\_\_

\_\_\_\_\_

\_\_\_\_\_

\_\_\_\_\_

DATE SYSTEM APPROVED 4-3-74 INSPECTOR D. Mangels & F. Skinner

# APPLICATION

A 17493

## SEWAGE DISPOSAL TESTING

F \_\_\_\_\_

### MARYLAND STATE DEPARTMENT OF HEALTH

HOWARD COUNTY Septic Tank 3 Bedrooms 1000 gallons ELLICOTT CITY

4 Bedrooms 1250 gallons DISTRICT 5th

DATE 9/28/72

Day Well to have 100 sq. ft. effective absorption

side wall area per bedroom below inlet. Inlet to be

4' below original grade and maximum depth 12' below

original grade. Location 32.5' from left back corner

along left property line and in 35' off left

property line. (See sketch) when facing lot from Broadwater

TO: THE COUNTY HEALTH OFFICER  
ELLICOTT CITY, MARYLAND

I, HEREBY, APPLY FOR THE NECESSARY TESTS IN ORDER TO CONSTRUCT (OR RECONSTRUCT) A SEWAGE DISPOSAL SYSTEM.

PROPERTY OWNER Edward Talbott, Trustee

ADDRESS 11 Park Avenue, Gaithersburg, Md. 20760 PHONE 926-3007

PROPERTY LOCATION: \_\_\_\_\_

SUBDIVISION \_\_\_\_\_ LOT NO. \_\_\_\_\_

ROAD AND DESCRIPTION The S.E. corner of Linden Chapel Rd. & Broadwater Rd.

OCCUPANT \_\_\_\_\_ PHONE \_\_\_\_\_

PERSON TO CONSTRUCT SYSTEM \_\_\_\_\_

ADDRESS \_\_\_\_\_ PHONE \_\_\_\_\_

SIZE OF LOT 6.469 acres TYPE BLDG. 3 or 4 bedrooms

NUMBER OF BEDROOMS

IF NOT SINGLE RESIDENCE DESCRIBE \_\_\_\_\_

SIGNATURE OF APPLICANT /s/ Richard Hallowell, Agent - 286-2988

APPROVED BY C. Theaker FOR Day Well DATE 11/10/72

(KIND OF SYSTEM)

REJECTED BY \_\_\_\_\_ FOR \_\_\_\_\_ DATE \_\_\_\_\_

(KIND OF SYSTEM)

HOLD PENDING FURTHER TESTS \_\_\_\_\_ DATE \_\_\_\_\_

REASONS FOR REJECTION OR HOLDING \_\_\_\_\_

① Conditions  
② Keep well 60' off left line  
③ Per Day Well  
**THIS IS NOT A PERMIT** in proper execution

