

# APPLICATION

A 17420

SEWAGE DISPOSAL TESTING

MARYLAND STATE DEPARTMENT OF HEALTH

HOWARD COUNTY

ELLICOTT CITY

DISTRICT 5th

DATE 9/8/73

TO: THE COUNTY HEALTH OFFICER  
ELLICOTT CITY, MARYLAND

I, HEREBY, APPLY FOR THE NECESSARY TESTS IN ORDER TO CONSTRUCT (OR RECONSTRUCT) A SEWAGE DISPOSAL SYSTEM.

PROPERTY OWNER Edward B. Talbot, et al (William M. & Barbara E. Taylor)-contract owners

ADDRESS 11 Park Avenue, Gaithersburg, Md. 20760 PHONE 926-3007

PROPERTY LOCATION:

SUBDIVISION \_\_\_\_\_ LOT NO. \_\_\_\_\_

ROAD AND DESCRIPTION entrance on Broadwater Lane approx. 432' south of Linden Chapel Rd. as per attached plat

OCCUPANT \_\_\_\_\_ PHONE \_\_\_\_\_

PERSON TO CONSTRUCT SYSTEM \_\_\_\_\_

ADDRESS \_\_\_\_\_ PHONE \_\_\_\_\_

SIZE OF LOT 6.469 Acres TYPE BLDG. 3 bedrooms  
NUMBER OF BEDROOMS

IF NOT SINGLE RESIDENCE DESCRIBE \_\_\_\_\_

SIGNATURE OF APPLICANT Richard H. Haltonel agent for owner

APPROVED BY \_\_\_\_\_ FOR \_\_\_\_\_ DATE \_\_\_\_\_  
(KIND OF SYSTEM)

REJECTED BY \_\_\_\_\_ FOR \_\_\_\_\_ DATE \_\_\_\_\_  
(KIND OF SYSTEM)


HOLD PENDING FURTHER TESTS \_\_\_\_\_ DATE \_\_\_\_\_

REASONS FOR REJECTION OR HOLDING \_\_\_\_\_

## THIS IS NOT A PERMIT

02441

APPLICATION

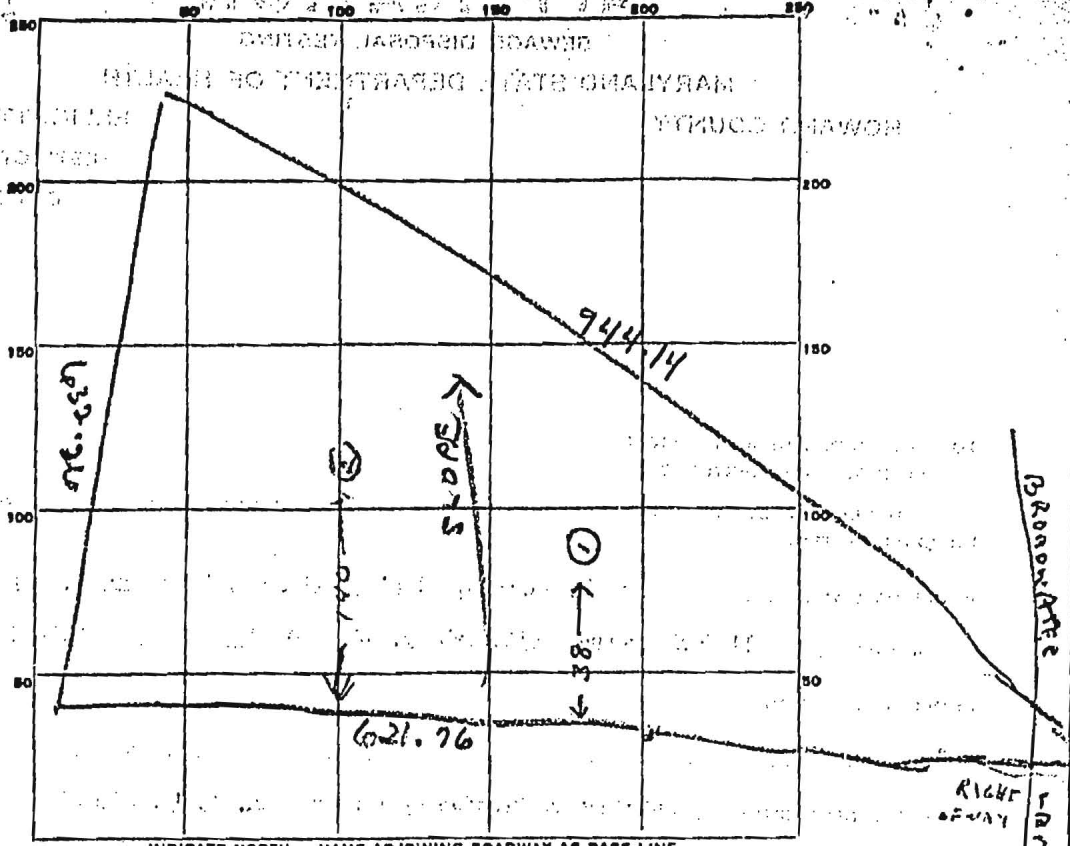


INDICATE NORTH. - NAME ADJOINING ROADWAY AS BASE LINE.

DATE	TEST NO.	DEPTH	PRE-WET		TEST - 1" DROP		TIME
			START	STOP	START	STOP	
9/2/72	1	14 ft	water at 13 ft.		solid clay fine		9 ft.
	2	7 ft	clay				

SOIL AUGER FINDING: Holes on soil into of dirt. need picture later

TESTED BY: R. Tarr

REMARKS:

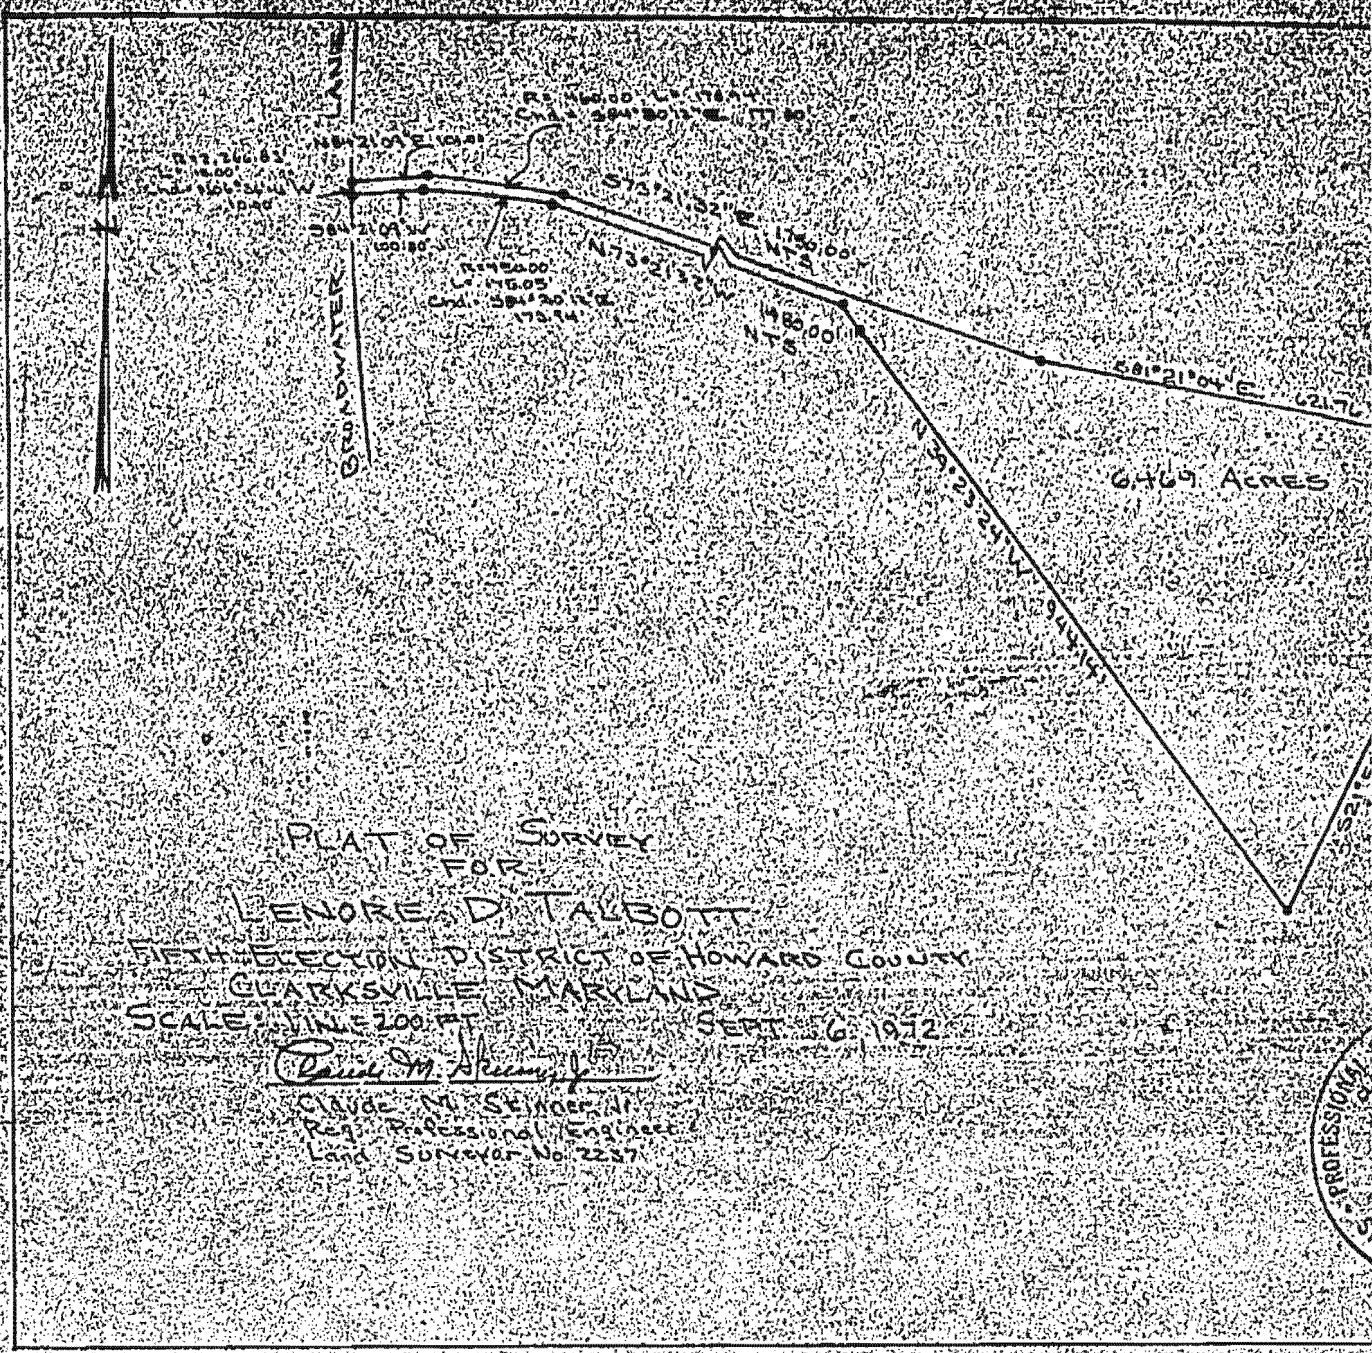

PLAT OF SURVEY  
 FOR  
 LENORE D. TALBOTT  
 FIFTH ELECTION DISTRICT OF HOWARD COUNTY  
 CLARKSVILLE, MARYLAND  
 SCALE: 1 INCH = 200 FT.      SEPT. 16, 1972

*Claude M. Seider, Jr.*  
 Claude M. Seider, Jr.  
 Reg. Professional Engineer  
 Land Surveyor No. 2237

PROFESSIONAL  
 ENGINEER