

DEPARTMENT OF INSPECTIONS,  
 LICENSES & PERMITS  
 3430 COURT HOUSE DRIVE  
 ELLICOTT CITY, MD 21043  
 PERMITS (410) 313-2455  
 INSPECTIONS (410) 313-1850

**HOWARD COUNTY  
 RESIDENTIAL  
 HEATING-VENTILATION-AIR  
 CONDITIONING AND  
 REFRIGERATION PERMIT  
 APPLICATION**

HVACR PERMIT # MM4000723  
 BUILDING PERMIT #

10/24/2014  
O.K. (PB)

BUILDING ADDRESS: SUITE/APT:  
 SUBDIVISION:  
 CENSUS TRACT: SECTION: AREA:  
 LOT: TAX MAP: PARCEL:  
 BLOCK: ZONE:  
 PROPERTY ID: MAP COORDINATES:  
 TYPE OF IMPROVEMENTS: USE:

OWNERS NAME: NICHOLAS TIFFANY  
 ADDRESS: 5329 BROADWATER LANE  
 CITY: CLARKSVILLE  
 STATE: MD ZIP CODE: 21029  
 HOME PHONE: 301-688-0986 ~~CELL~~ WORK PHONE: 404-840-6608

	<u>CHECK ONE</u>	<u>HOW MANY</u>	
SINGLE FAMILY DWELLING	<input checked="" type="checkbox"/>	<u>1</u>	ZONES
SINGLE FAMILY TOWNHOUSE	<input type="checkbox"/>	___	ZONES
MULTI-FAMILY / HOTEL/MOTEL	<input type="checkbox"/>	___	ROOMS
ASSISTED LIVING HOMES (16 OR FEWER RESIDENTS)	<input type="checkbox"/>	___	ROOMS

COMPANY NAME: Ground Loop Heating & Air Cond., Inc.  
 LICENSEE NAME: Michael E. Cullum  
 ADDRESS: 1701 Whiteford Road  
 CITY: Darlington  
 STATE: MD ZIP CODE: 21034  
 PHONE: 410-836-1706 HVACR LICENSE NO: 6539

**New**

- Heating and Air Conditioning
- Heating System Only
- Other Work (Describe):
- Geo Thermal System
- Ductless Mini Splits
- Thru The Wall Systems

**Replacement**

- Heating
- Air Conditioning
- Heating and Air Conditioning

**Additions and Alterations**

- Heating
- Air Conditioning
- Heating and Air Conditioning

VERTICAL CLOSED LOOPS  
WATER FURNACE 4 TON

\*\*\*\*Replacement Geo Thermal Systems are not required; However, if a tax credit is being sought a permit is required\*\*\*\*

Zones	Rooms
Permit Fee = # of Zones x \$40 = <u>40.00</u>	Permit Fee = # of Rooms x \$80 = _____
Technology Fee (10% of Permit Fee) = <u>4.00</u>	Technology Fee (10% of Permit Fee) = _____
Plus Application Fee <u>50.00</u>	Plus Application Fee \$50 <u>50.00</u>
Total Fees Due = <u>94.00</u>	Total Fees Due = _____

I HAVE CAREFULLY EXAMINED AND READ THIS APPLICATION AND KNOW IT IS TRUE AND CORRECT. THE WORK DESCRIBED HEREIN WILL BE PERFORMED BY A STATE HVACR LICENSED PERSON(S), AND ALL WORK WILL BE PERFORMED IN COMPLIANCE WITH APPLICABLE CODES AND STANDARDS OF HOWARD COUNTY THE STATE OF MARYLAND.

Michael Cullum 7-23-14  
 SIGNATURE OF LICENSEE DATE

MICHAEL CULLUM  
 PRINT NAME OF LICENSEE

linda @ ground loop . com  
 Email Address


**Validation**  
 Check Number: 22137  
 Cash: \_\_\_\_\_  
 Receipt Number: 3170505

Make check payable to: DIRECTOR OF FINANCE OF HOWARD COUNTY

WELL & SEPTIC

M14000723

168652

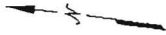

Location Drawing

Scale: 1" = 200'

This plat is of benefit to a consumer only insofar as it is required by a lender or a title insurance company or its agent in connection with contemplated transfer, financing or refinancing. This plat is not to be relied upon for the establishment or location of fences, garages, buildings, dwellings or other existing or future improvements. The accuracy of measured distances is approximately ten feet. This plat does not provide for the accurate identification of property boundary lines, but such identification may not be required for the transfer of title or securing financing or refinancing. The approximate location of the dwelling is shown in relation to the apparent property lines. The undersigned surveyor was in charge of preparing this plat.

5329 Broadwater Lane  
Howard County, Maryland

*William T. Matthews* 11/26/13

**Ruxton Design Corporation**

9475 Deereco Road  
Suite B200

Timonium, Maryland 21093

410-823-5000


410-823-0115 fax

rdc@ruxtondesign.com

www.ruxtondesign.com

13-6607P

Property subject to a  
Transcontinental Gas Pipe Line  
right of way of undefined width as  
mentioned in Deed Liber:8303, Folio:191

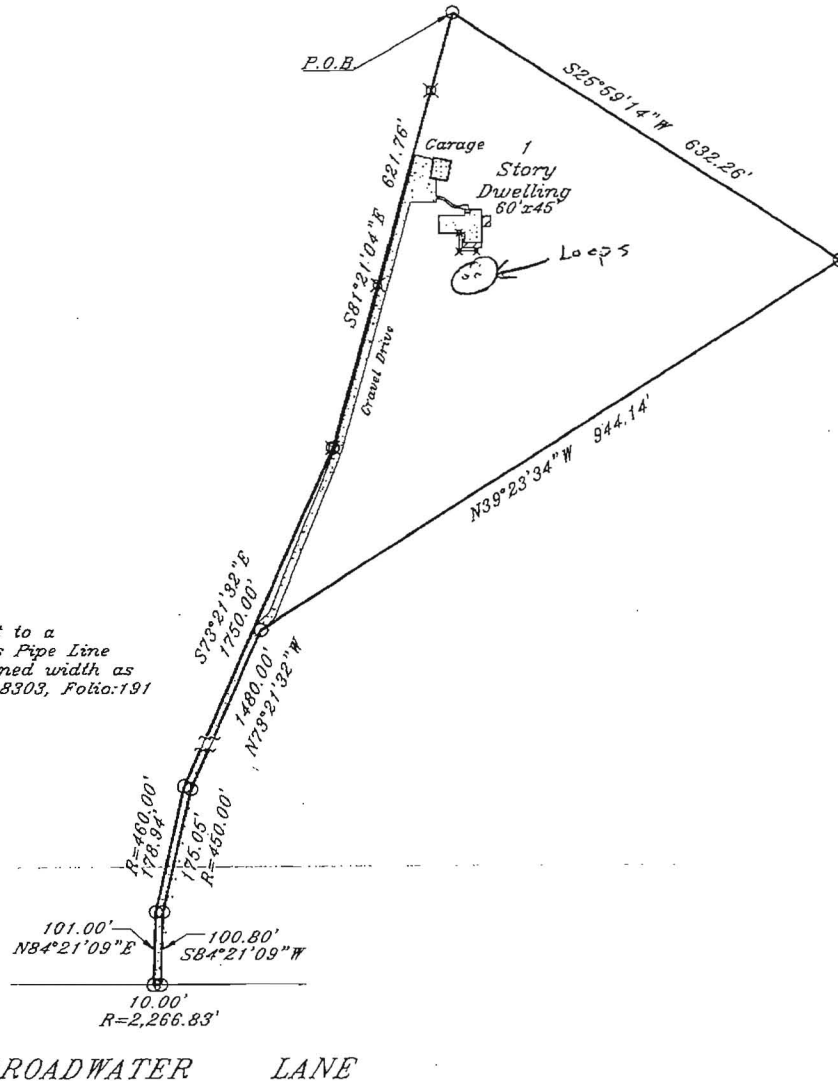

BROADWATER LANE