

PUBLIC SEWER STATUS VERIFIED BY

ISSUE DATE: 12-1-11

PERMIT

P 532989

APPROVAL DATE: _____

A UPGRADE

Septic Repair ON-SITE SEWAGE DISPOSAL SYSTEM HOWARD COUNTY HEALTH DEPARTMENT BUREAU OF ENVIRONMENTAL HEALTH

Garland Brian LLC IS PERMITTED TO INSTALL ALTER

ADDRESS: _____ PHONE NUMBER: 301-370-5432

SUBDIVISION: _____ LOT NUMBER: _____

ADDRESS: 6905 BROOKS ROAD, HIGHLAND, MD 20777 PROPERTY OWNER: DMITRI WASILEWSKI

SEPTIC TANK CAPACITY (GALLONS): 2000

PUMP CHAMBER CAPACITY (GALLONS): N/A

NUMBER OF BEDROOMS: 5

SQUARE FEET OF HOUSE: ~6000

LINEAR FEET OF TRENCH REQUIRED: 270

TRENCHES:	Trenches to be 2 feet wide. Inlet 3 feet below original grade. Bottom maximum depth 6 feet below grade. Effective area begins at 4 feet below original grade with 3 feet of stone below distribution pipe.
LOCATION:	Install Septic Tank immediately downhill of existing tank, per layout. Set Distribution Box at northwest corner of septic reserve. Install 3 x 90' trenches on contour toward east septic reserve boundary (re: toward driveway).
PURPOSE:	FINAL APPROVAL SIGNATURE OF THIS PERMIT TO BE WITHHELD UNTIL FORMER SEPTIC TANK IS PROPERLY ABANDONED.

PLANS APPROVED: Robert Bricker DATE: 11/16/2011

- NOTE: PERMIT VOID AFTER 2 YEARS
- NOTE: CONTRACTOR RESPONSIBLE FOR SCHEDULING A PRE-CONSTRUCTION INSPECTION FOR ALL INSTALLATIONS
- NOTE: WATERTIGHT SEPTIC TANKS REQUIRED
- NOTE: ALL PARTS OF SEPTIC SYSTEM SHALL BE 100 FEET FROM ANY WATER WELL
- NOTE: MANHOLE RISERS REQUIRED ON ALL SEPTIC TANKS AND PUMP CHAMBERS
- NOTE: AN ELECTRICAL PERMIT IS REQUIRED FOR INSTALLATION OF ANY ELECTRICAL COMPONENTS OF THE SYSTEM


NEITHER THE HOWARD COUNTY COUNCIL OR THE HEALTH DEPARTMENT IS RESPONSIBLE FOR THE SUCCESSFUL OPERATION OF ANY SYSTEM PERMITTEE RESPONSIBLE FOR OBTAINING FINAL APPROVAL ON THIS PERMIT CALL 410-313-1771 FOR INSPECTION OF SEPTIC SYSTEM



HO-73-0748

NOT TO SCALE

30

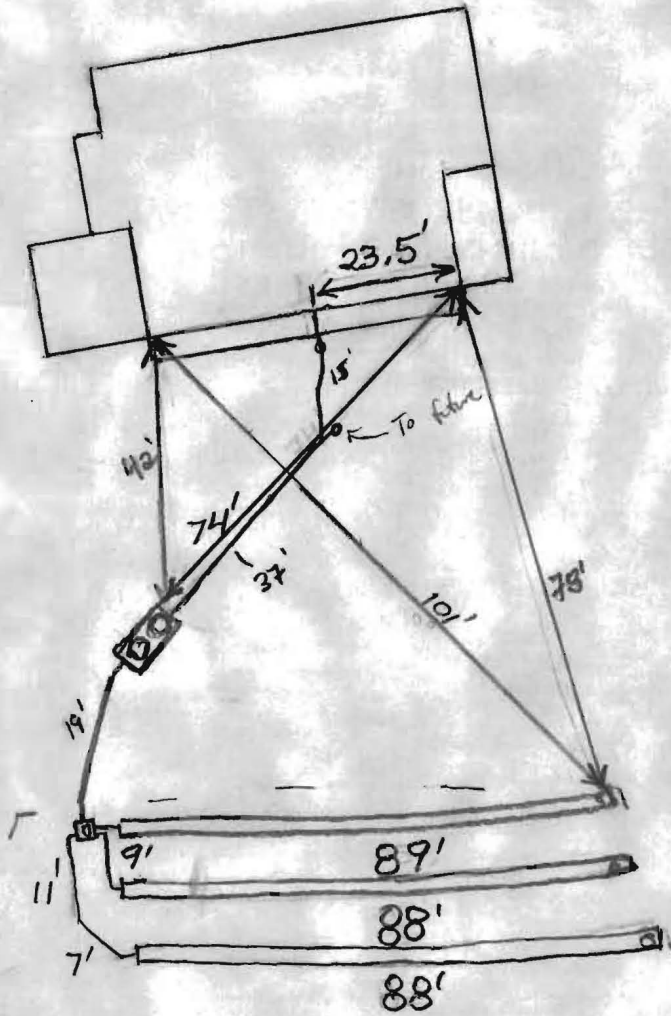

ROAD NAME

TRENCH/DRAINFIELD DATA

WIDTH	INLET	BOTTOM
2'	3'	6'
NUMBER OF TRENCHES 3		
TOTAL LENGTH 266'		
ABSORPTION AREA 532		
DISTRIBUTION BOX LEVEL Levelers		
DISTRIBUTION BOX BAFFLE Yes		
DISTRIBUTION BOX PORT Yes		

SEPTIC TANK DATA

SEPTIC TANK 1 LEVEL	Yes
MANUFACTURER	Mayor Bros
CAPACITY	2000 GAL
SEAM LOC	Top
TANK LID DEPTH	6'-8"
BAFFLES	Rear
BAFFLE FILTER	No
MANHOLE LOC	Front+Rear
6" PORT LOC	None
WATERTIGHT TEST	No
SLOTTED	Yes
DATE ON LID	N/A
PUMP/SEPTIC TANK LEVEL	N/A
MANUFACTURER	
CAPACITY	GAL
SEAM LOC	
TANK LID DEPTH	
BAFFLES	
BAFFLE FILTER	
MANHOLE LOC	
6" PORT LOC	
WATERTIGHT TEST	
SLOTTED	
DATE ON LID	

PRE-CONSTRUCTION:

11/18/2011 Install three 90' trenches on contour downhill of the house. Keep the tank outside of the well radius. (BB)

INSTALLATION: 12/2/11 Top trench completed. Middle trench completed. Soil looks good. Tank set little bit downhill then proposed, due to rock issues. Told contractor will need to get baffles in Dbux. (BB) 12/5/2011 Trenches finished. Dist. box O.K. Need to make house connection and finish septic tank. (BB) 12/6/2011 House connection partially done. Need 6" baffle in front of septic tank. (BB) 12/8/11 SHC made. "Y" added for future connection to adder.

FINAL INSPECTOR

K. Half

DATE OF APPROVAL

12/8/11