

7/23/74
7/23/74
7/24/74
Ready

7/23/74 *7/25/74* *Final*
Partial *P. T.* *20359* *S.F.S.*

PERMIT

SEWAGE DISPOSAL SYSTEM

MARYLAND STATE DEPARTMENT OF HEALTH

HOWARD COUNTY

ELLICOTT CITY

DISTRICT 5th

INDEXED

DATE 7/19/74

Jack Fyock

IS PERMITTED TO INSTALL ALTER

ADDRESS Ten Oaks Road, Glenelg, Maryland PHONE 286-2939

A SEWAGE DISPOSAL SYSTEM LOCATED AT _____

SUBDIVISION _____ ROAD Brooks Road LOT 2

PROPERTY OWNER D. John Pastine

ADDRESS Brooks Road, Highland, Maryland 20777

SPECIFICATIONS 3 bedrooms - Customer requested larger system to be put in.

DRAIN FIELD _____ DEPTH _____ FEET, BOTTOM AREA _____ SQ. FT.

SEEPAGE PITS _____ ABSORBENT SIDE-WALL AREA _____ SQ. FT.

SEPTIC TANK CAPACITY 1500 GALLONS

FOR GARBAGE GRINDER, INCREASE DISPOSAL AREA 22% & TANK CAPACITY 50%.

~~OTHER~~ TRENCH - 80 feet long - 2 feet wide - 8 feet deep with 6 foot of gravel
under pipe. Begin trench 130 to 140 ft. directly behind well and ~~go~~ go straight
back toward rear of lot. Call for inspection of trench before gravel is installed.
Old sewage system must be abandoned and filled in according to State Specs.
Install system first.

NOTE: ALL PIPE FROM HOUSE TO DRY WELL MUST BE CAST IRON.

PERMIT VOID AFTER THREE YEARS.

NOTE: INSTALL STAND PIPE ON SEPTIC TANK AND DRY WELL.


PLANS APPROVED BY Donald W. Monaghan DATE 10/3/72

FILL SEPTIC TANK AND DISTRIBUTION BOX WITH WATER BEFORE CALLING FOR AN INSPECTION. COVER NO WORK UNTIL INSPECTED AND APPROVED.

NEITHER THE HOWARD COUNTY COMMISSIONERS NOR THE HEALTH DEPARTMENT IS RESPONSIBLE FOR THE SUCCESSFUL OPERATION OF ANY SYSTEM.

A 17463

INSPECTOR _____ DATE SYSTEM APPROVED _____

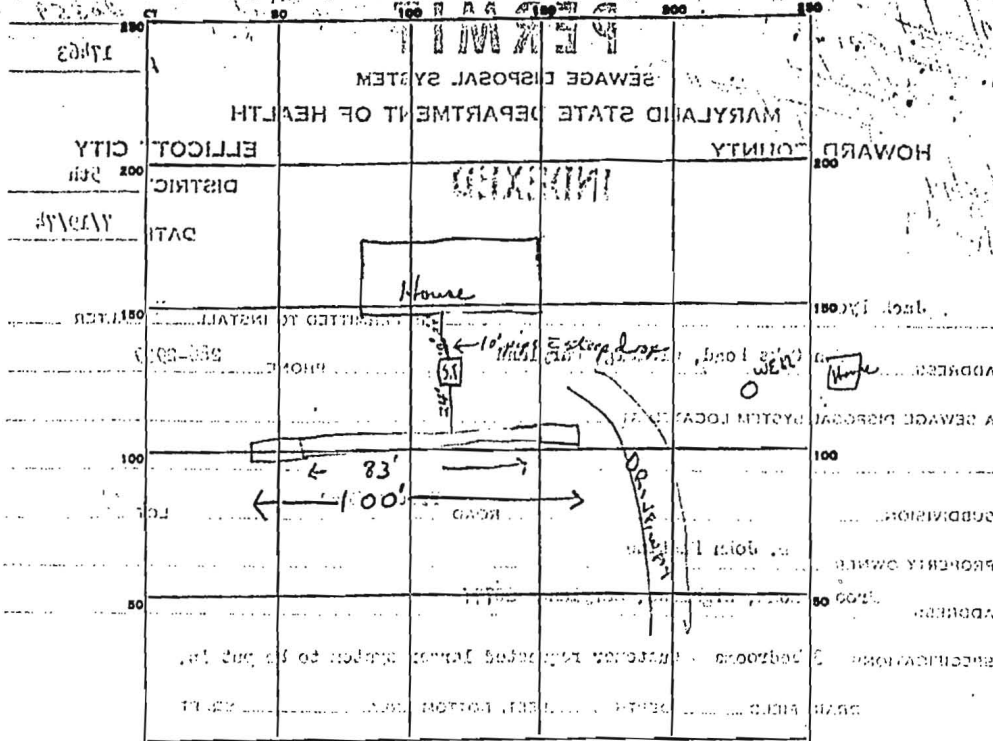

INDICATE NORTH - NAME ADJOINING ROADWAY AS BASE LINE.

As Built

PERMIT CARD 1001

SEPTIC TANK, LEVEL 16500 gal. CLEANOUTS S.I.

DISTRIBUTION BOX, LEVEL 100

TILE FIELD, DEPTH 5 FT. TRENCH WIDTH 2 FT.

GRAVEL DEPTH 5 FT. TOTAL LENGTH 100 FT.

NUMBER OF TRENCHES 1 TOTAL BOTTOM AREA 500 SQ. FT.

SEEPAGE PITS, INSIDE DIAMETER 5 FT. DEPTH BELOW INLET 5 FT.

ABSORBENT AREA 500 SQ. FT.

REMARKS 7/25/74 - Trench 2 ft deep - hitting rock. Dig trench
100 ft long so required sidewalk area can be obtained.
OK to fill with stones.

7/25/74 - Trench is 100 ft long filled to rock gravel; paper needed on
last 35 ft of trench 5'

DATE SYSTEM APPROVED 7/25/74 INSPECTOR Frank Shivers