

8/14/89  
8/15/89 11 AM

# PERMIT

P 44168  
35535  
A 35536

SEWAGE DISPOSAL SYSTEM

MARYLAND STATE DEPARTMENT OF HEALTH DISTRICT 5th

HOWARD COUNTY  
BUREAU OF ENVIRONMENTAL HEALTH  
461-9933

DATE 5/05/89

DATE SYSTEM APPROVED 8-15-89

INSPECTOR SAL

INDEXED  
05-399467

Alan Whitworth IS PERMITTED TO INSTALL  ALTER

ADDRESS 12680 Clarksville Pike, Clarksville, Maryland PHONE 854-2513

SUBDIVISION Buckskin Wood ROAD 4229 Buckskin Wood Drive LOT 12  
~~4242 Buckskin Lake Dr.~~

PROPERTY OWNER Paul Bylis *BUCKSKIN WOOD DRIVE*

ADDRESS \_\_\_\_\_

IF GARBAGE GRINDER IS USED INCREASE SEPTIC TANK CAPACITY BY 50% AND ABSORPTION AREA BY 22%.

GARBAGE GRINDER? YES  NO \_\_\_\_\_

*Addition - Swimming Pool*  
BLDG. PERMIT SIGNED  
AND RETURNED 11-9-95  
Serial # 62513

SEPTIC TANK CAPACITY 2000 GALLONS NUMBER OF BEDROOMS 4

TRENCHES - 220 sq. ft. per bedroom with garbage disposal. Trench to be 3 feet wide Inlet 3.5 feet below original grade. Bottom maximum depth 5 feet below original grade. Effective area begins at 4.0 feet below original grade. 1.5 feet of stone below distribution pipe.

LOCATION - Place the distribution box 110 feet from the back (374.25') lot line and 185 feet from the right (405') lot line as seen when facing the lot from Buckskin Lake Drive. Run trenches on contour toward the left front lot line.

NOTE - No trench to exceed 100 feet in length. Provide 6" - 8" diameter cleanout and cap to grade or above on septic tank. MK/CW

PLANS APPROVED BY Sid Abel *Addition*  
BLDG. PERMIT SIGNED  
AND RETURNED 6-5-96 DATE 2/11/86  
Serial # B00100443

COVER NO WORK UNTIL INSPECTED AND APPROVED

NEITHER THE HOWARD COUNTY COUNCIL NOR THE HEALTH DEPARTMENT IS RESPONSIBLE FOR THE SUCCESSFUL OPERATION OF ANY SYSTEM

NOTE. CLEANOUT REQUIRED EVERY 70 FEET OF SEWER LINE AND/OR AT 90° SWEEPS IN LINES FROM HOUSE TO DRAIN FIELDS

NOTE. ALL PARTS OF SEPTIC SYSTEMS (I.E. TANK, DISTRIBUTION BOX, TRENCHES) TO BE 100 FEET FROM WELL (UNLESS OTHERWISE SPECIFICALLY AUTHORIZED)

NOTE. IF DEEP TRENCHES ARE USED CALL FOR INSPECTION BEFORE AND AFTER PLACING GRAVEL IN TRENCHES) BLDG. PERMIT SIGNED

NOTE. NO DRY WELL SHALL EXCEED 15 FOOT IN DIAMETER NO ABSORPTION TRENCH TO EXCEED 100 FEET IN LENGTH. AND RETURNED 9/3/91

NOTE. ALL PIPE FROM HOUSE TO SEPTIC TANK MUST BE CAST IRON OR SCHEDULE 40 PVC OR ABS

*Serial # 39507 Pouch/1/1/92*

PERMIT VOID AFTER TWO YEARS


NOTE. INSTALL STAND PIPE ON SEPTIC TANK AND DRY WELL. STAND PIPES MUST BE 6 INCHES IN DIAMETER. CAST IRON, CONCRETE OR TERRA COTTA OR PVC OR ABS ACCEPTED. IF TOP OF SEPTIC TANK IS DEEPER THAN 3 FEET, MANHOLE TO GRADE REQUIRED

NOTE. DISTRIBUTION BOXES MUST HAVE BAFFLES

**\*INSTALLER IS RESPONSIBLE FOR OBTAINING FINAL APROVAL ON THIS PERMIT**

\*CALL 461-9933 FOR INSPECTION OF SEPTIC SYSTEMS.

35535

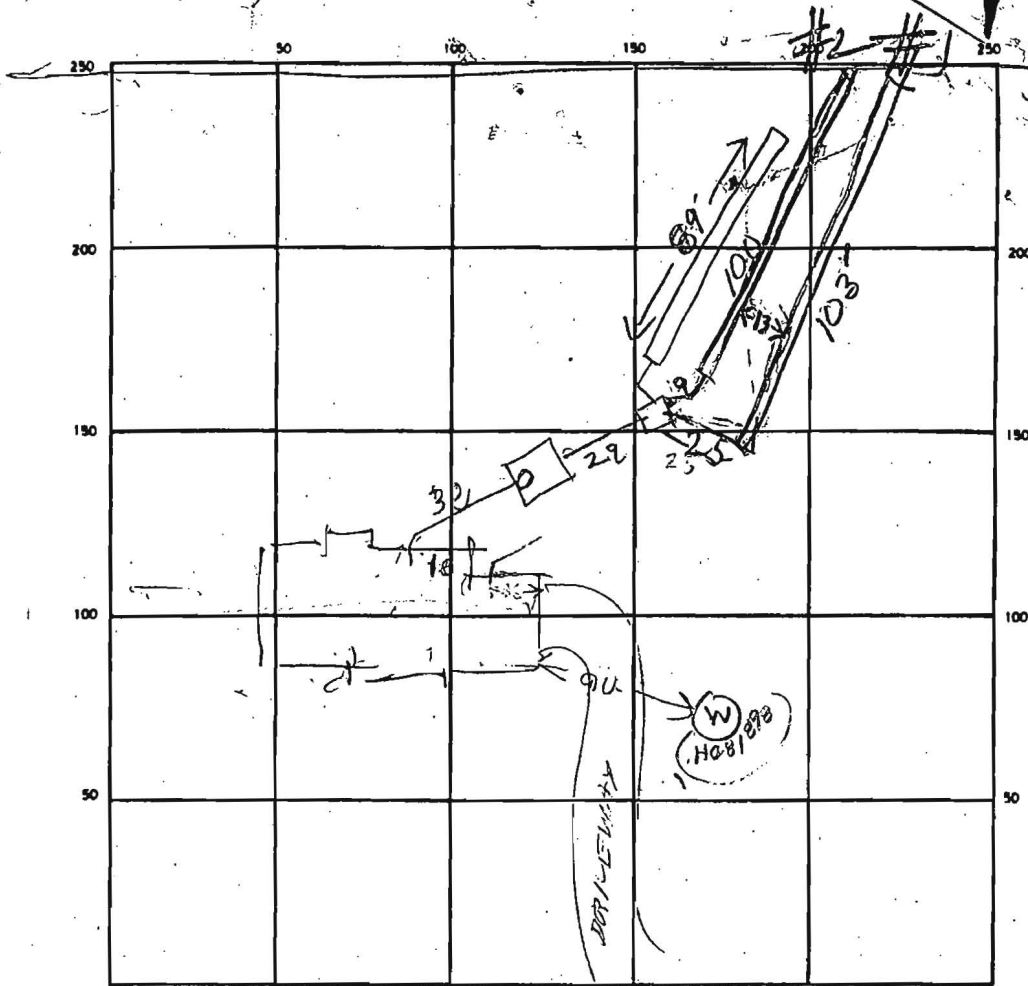

INDICATE NORTH - NAME ADJOINING ROADWAY AS BASE LINE

BULK SKIN WOOD DRIVE

SEPTIC TANK LEVEL OK 2000 CLEANOUTS STU

DISTRIBUTION BOX LEVEL OK near Bulk

DRAIN FIELD/TILE FIELD DEPTH 5-5.5 FT. TRENCH WIDTH 3 FT. INLET DEPTH 3.5 FT.

EFFECTIVE GRAVEL DEPTH 1/5 | 1/5 | 1/5 FT. TOTAL LENGTH 103 | 100 | 89 FT. TLF 29.2

NUMBER OF TRENCHES 3 ONE SIDEWALL BOTTOM AREA 876 SQ. FT.

DRYWELL INSIDE DIAMETER \_\_\_\_\_ FT. EFFECTIVE DEPTH BELOW INLET \_\_\_\_\_ FT.

ABSORBENT AREA 876 SQ. FT. meed 880/ok 880

REMARKS 8/14/89 OK TO START SYSTEM IS FE DOWN HILL FROM DISCRIPTION. SOL  
8/14/89 LOCATION OK TRENCH STARTED TANK SET  
8/14/89 - OK TO COVER TANK & MIDDLE OF TRENCH #1  
DIG TRENCH #3 ADD STONE TO #2 RH

DATE SYSTEM APPROVED 8-15-81 INSPECTOR S. Alue