

TOPOGRAPHY WAS TAKEN OFF OF THE HOWARD COUNTY GSI WEBSITE

# PERC CERTIFICATION PLAN

**PURPOSE STATEMENT:**

Relocation of Septic Reserve Area for Installation of In-ground Swimming Pool & Future Addition

SCALE: 1" = 50' DRAWING DATE: 11-4-2015

I CERTIFY THAT THE INFORMATION SHOWN HEREON IS BASED ON FIELD WORK PERFORMED BY ME OR UNDER MY DIRECT SUPERVISION, AND IS CORRECT TO THE BEST OF MY KNOWLEDGE AND BELIEF


SIGN *Mike Duffy* DATE 11/04/2015

Approved For Private Water & Private Sewerage Systems  
*B. Wilson for Mairee Rossman* 11/18/2015  
 Health Officer, Howard County Health Department *KMD* DATE

ANY CHANGES TO A PRIVATE SEWAGE EASEMENT SHALL REQUIRE A REVISED PERC CERTIFICATION PLAN

THE LOT SHOWN HEREON COMPLIES WITH THE MINIMUM WIDTH & LOT AREA REQUIRED BY THE MARYLAND DEPT OF ENVIRONMENT

MDE sewage easement statement for lots created after March 1972: This area designates a private sewage easement of at least 10,000 sq ft as required by the Maryland Department of Environment for individual sewage disposal. Improvements of any nature in this area are restricted. This easement shall become null and void upon connection to a public sewage system. The county health officer shall have authority to grant adjustments to the private sewage easement. Recordation of a revised sewage easement shall not be necessary.

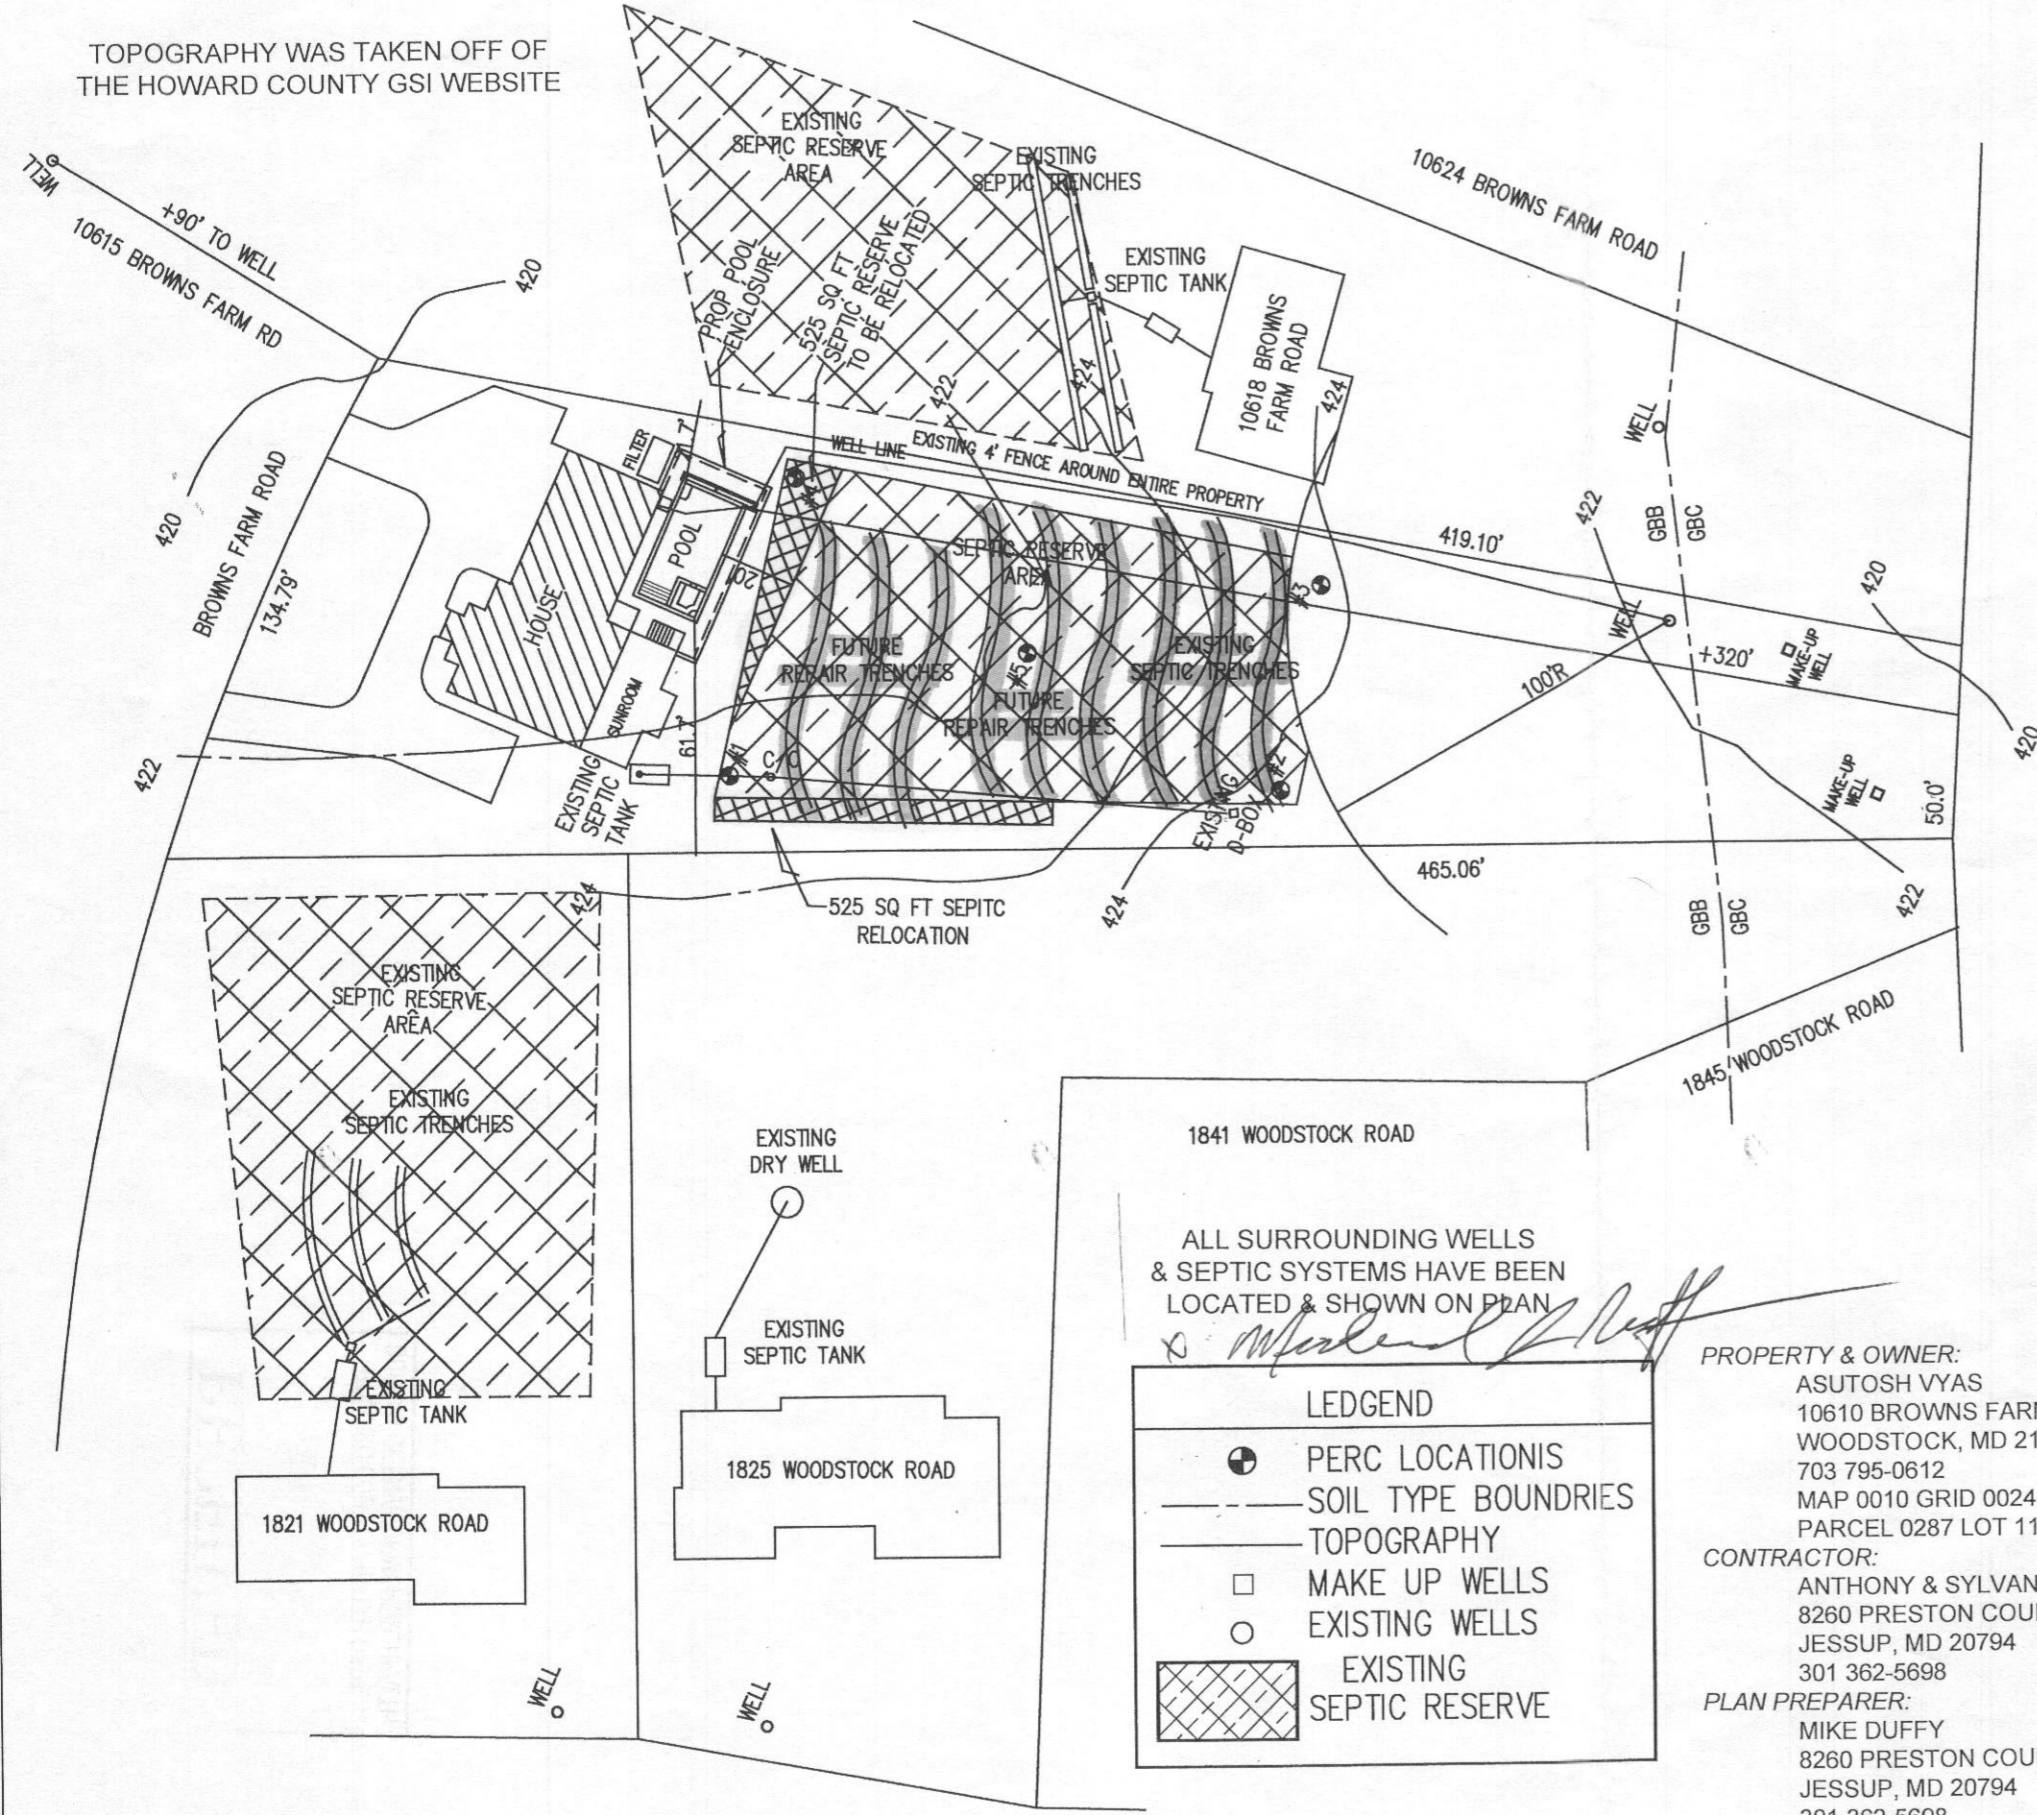

ALL SURROUNDING WELLS & SEPTIC SYSTEMS HAVE BEEN LOCATED & SHOWN ON PLAN


*Mike Duffy*

LEDGEND	
⊕	PERC LOCATIONIS
---	SOIL TYPE BOUNDRIES
—	TOPOGRAPHY
□	MAKE UP WELLS
○	EXISTING WELLS
▨	EXISTING SEPTIC RESERVE

**PROPERTY & OWNER:**  
 ASUTOSH VYAS  
 10610 BROWNS FARM ROAD  
 WOODSTOCK, MD 21163  
 703 795-0612  
 MAP 0010 GRID 0024  
 PARCEL 0287 LOT 11

**CONTRACTOR:**  
 ANTHONY & SYLVAN POOLS  
 8260 PRESTON COURT  
 JESSUP, MD 20794  
 301 362-5698

**PLAN PREPARER:**  
 MIKE DUFFY  
 8260 PRESTON COURT  
 JESSUP, MD 20794  
 301 362-5698

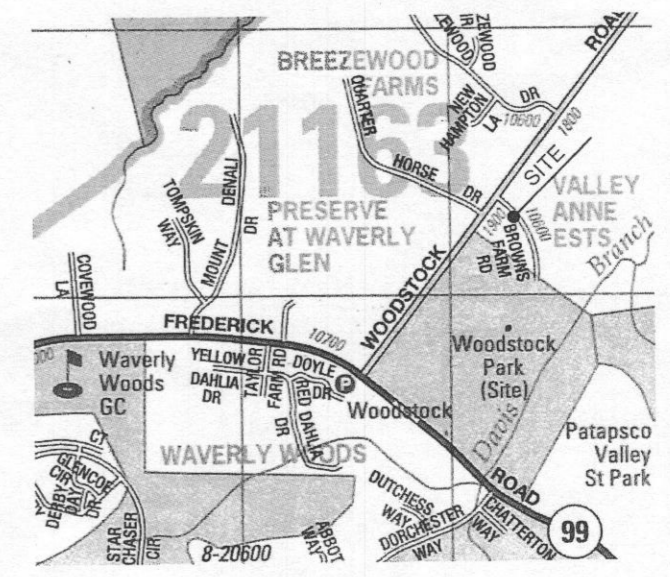

VICINITY MAP