

APPLICATION

SEWAGE DISPOSAL TESTING

STATE OF MARYLAND - DEPARTMENT OF HEALTH AND MENTAL HYGIENE

A 31251

P _____

HOWARD COUNTY HEALTH DEPARTMENT
ENVIRONMENTAL HEALTH SERVICES

P. O. BOX 473 ELLICOTT CITY, MARYLAND 21043
TELEPHONE: 992-2330

DISTRICT 5th

DATE 3/26/81

TO: THE COUNTY HEALTH OFFICER
ELLICOTT CITY, MARYLAND

I, HEREBY, APPLY FOR THE NECESSARY TEST IN ORDER TO CONSTRUCT (OR RECONSTRUCT) A SEWAGE DISPOSAL SYSTEM.

PROPERTY OWNER Earl Barnett

ADDRESS Route 2, Box 38, Laurel, Md. PHONE _____

PROPERTY LOCATION:

SUBDIVISION Highland Acres LOT NO. 4, Sec. 1

ROAD AND DESCRIPTION Brown Bridge Road

SIZE OF LOT 168' x 311' TYPE BLDG. 3 or 4 bedrooms
(NUMBER OF BEDROOMS)

THE SYSTEM INSTALLED UNDER THIS APPLICATION IS ACCEPTABLE ONLY UNTIL PUBLIC FACILITIES BECOME AVAILABLE. I FULLY UNDERSTAND THE FEE CONNECTED WITH THE FILING OF THIS PERC TEST APPLICATION IS NON-REFUNDABLE UNDER ANY CIRCUMSTANCES. I ALSO AGREE TO COMPLY WITH ALL M.O.S.H.A. REQUIREMENTS IN TESTING THIS LOT. /s/ Chuck Smith

(SIGNATURE OF APPLICANT)

APPROVED BY _____ FOR _____ DATE _____


REJECTED BY _____ FOR _____ DATE _____

HOLD PENDING FURTHER TESTS _____ DATE _____

REASONS FOR REJECTION OR HOLDING _____

THIS IS NOT A PERMIT

2 1/2 HIGHLAND
ACRES
Lot 4 part 1

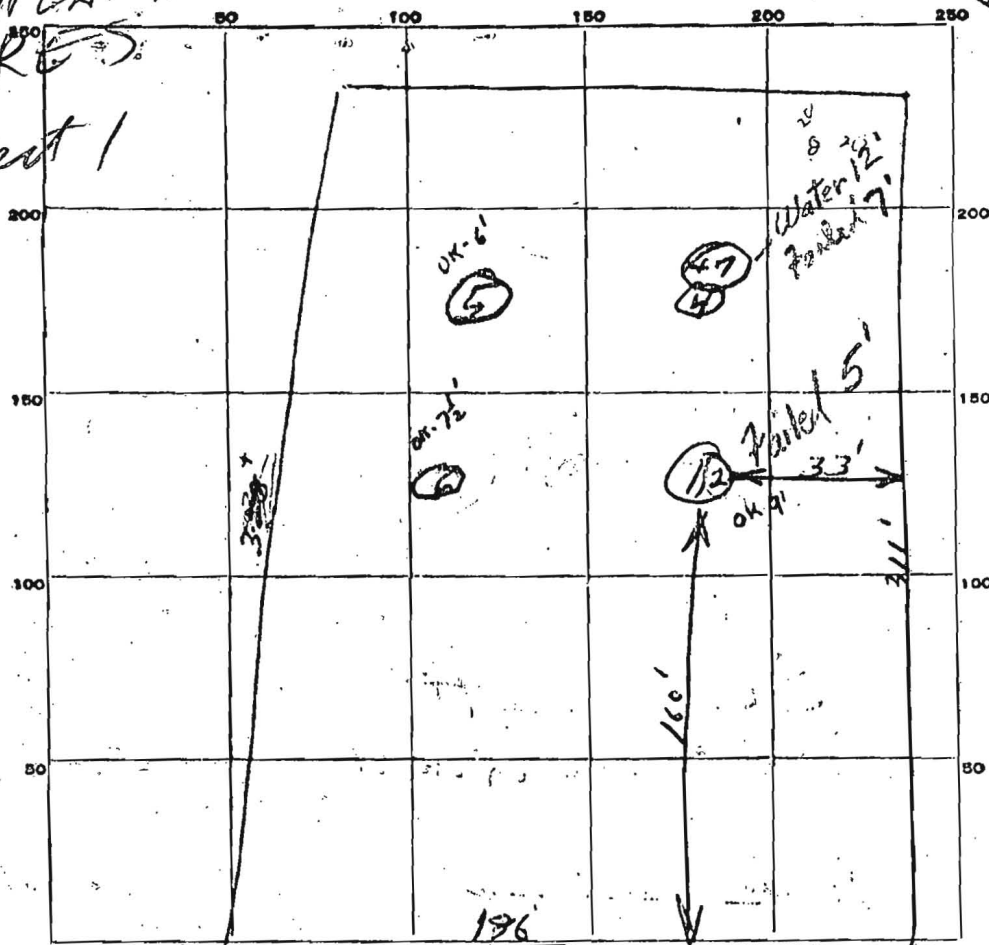

INDICATE NORTH. NAME ADJOINING ROADWAY AS BASE LINE

Brown Bridge Rd.

DATE	TEST NO.	DEPTH	PRE-WET		TEST - 1" DROP		TIME
			START	STOP	START	STOP	
2-7-63	1	9'	10:33	10:34	10:34	10:37	3 min
	2	5'	10:46	slow			Fail
	3 (3)	12'	Hit water				Fail
	4	7'	10:55	slow			Fail
2-21-63	5	6'	10:36	10:43	10:43	10:50	7 min
	6	7 1/2'	10:41	10:42	10:42	10:44	2 min
	7	7 1/2'	10:59	moving - OK			

SOIL AUGER FINDING

TESTED BY *[Signature]*

REMARKS

ALSO PRESENT

LOT NO.

2-21-63
Paul H. Cannon

2-7-63 Paul H. Cannon

4-5-63

XXXXXXXXXXXX

xxx 2330

August 6, 1981

Mr. Charles S. Smith
7606 Brown Bridge Road
Highland, Maryland 20777

RE: Highland Acres, Lot 4, Sec. 1
Brown Bridge Road
Highland, Howard County, Md.

Dear Mr. Smith:

This lot passed the standard percolation test and is considered buildable providing:

- a grading plan is received showing the house sewer can enter the high part of the sewage area (25' from road and 65' from left side) no deeper than 4 ft. below original grade
- the house site is shown 20 ft. or more away from the sewage disposal area - (a line drawn between the two perc holes 60'-65' from the front of the lot)
- the well is located at a higher elevation than the sewage disposal area and 75' to 100' removed - (front right corner of property)
- the well and the septic system are installed, before the building permit is approved by the Health Department.

If you have any questions concerning the above please contact this office at your convenience.

Very truly yours,

Fred Frommelt

FF:hs