

APPLICATION

A 06-322

P _____

SEWAGE DISPOSAL TESTING

MARYLAND STATE DEPARTMENT OF HEALTH

HOWARD COUNTY

ELLICOTT CITY

DISTRICT 5

DATE 2-7-63

Handwritten notes:
 1. Property bed 20 ft. long by 18 ft.
 2. width located 160 ft. from the front
 3. property line of 30 ft. on the right side
 4. property line on left side which facing to
 5. front Brown Bridge road 2 ft. 7 1/2 ft.
 6. from top originally ground
 7. 750 gal septic tank.

TO: THE COUNTY HEALTH OFFICER
ELLICOTT CITY, MARYLAND

I, HEREBY, APPLY FOR THE NECESSARY TESTS IN ORDER TO CONSTRUCT (OR RECONSTRUCT) A SEWAGE DISPOSAL SYSTEM.

PROPERTY OWNER

Earl Barnett

ADDRESS

Rt 2 Box 38 Laurel

PHONE

EU 4-6626

PROPERTY LOCATION:

SUBDIVISION

Highland Acres

LOT NO.

4, Sec 1

ROAD AND DESCRIPTION

Brown Bridge Rd.

OCCUPANT

PHONE

PERSON TO CONSTRUCT SYSTEM

ADDRESS

PHONE

SIZE OF LOT

168' x 311'

TYPE BLDG.

3

NUMBER OF BEDROOMS

IF NOT SINGLE RESIDENCE DESCRIBE

SIGNATURE OF APPLICANT

Earl Barnett

APPROVED BY

FOR

(KIND OF SYSTEM)

DATE

REJECTED BY

FOR

(KIND OF SYSTEM)

DATE

HOLD PENDING FURTHER TESTS


DATE

REASONS FOR REJECTION OR HOLDING

2-6-63 To test for leach bed 7 or 8 ft. Hit water at 12 ft.

THIS IS NOT A PERMIT

Highland Acres
lot #4

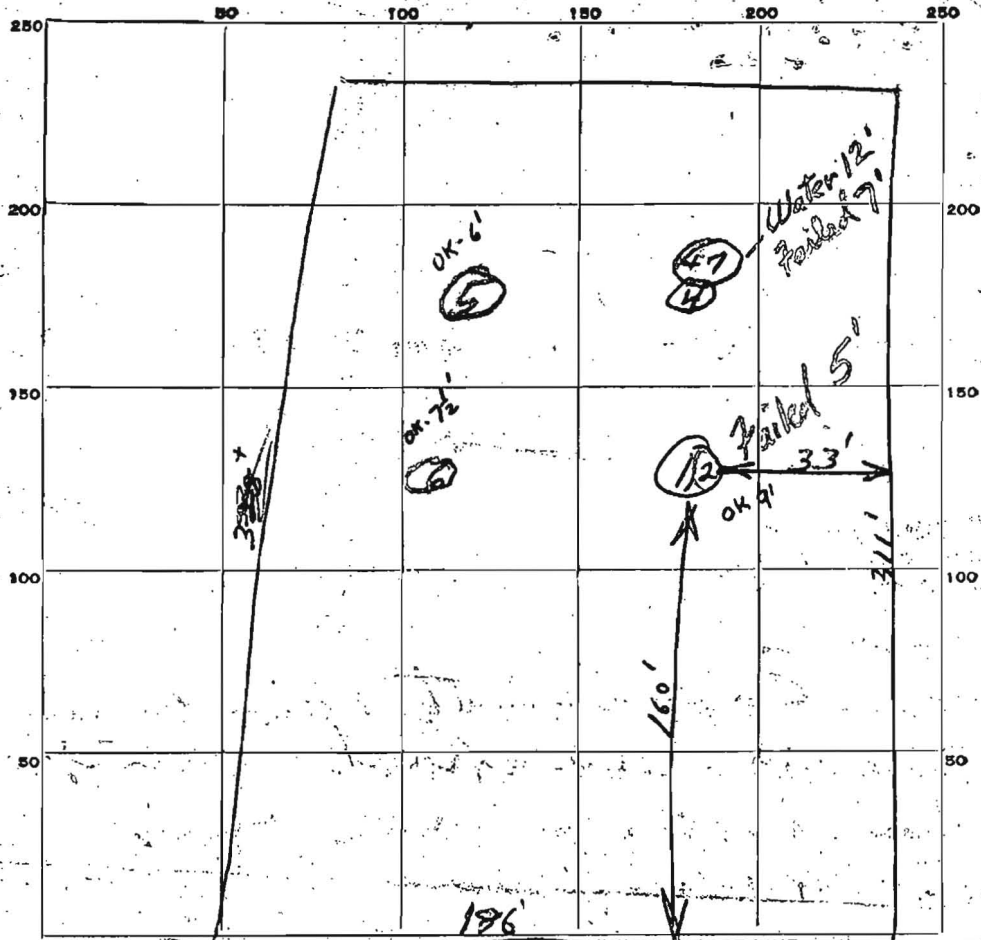

DATE	TEST NO.	DEPTH	PRE-WET		TEST - 1" DROP		TIME
			START	STOP	START	STOP	
2-7-63	1	9'	10:33	10:34	10:34	10:37	3 min
	2	5'	10:46	slow			Fail
	3	12'	Hit water				Fail
	4	7'	10:35	slow			Fail
2-21-63	5	6'	10:36	10:43	10:43	10:50	7 min
	6	7 1/2'	10:41	10:42	10:42	10:44	2 min
	7	7 1/2'	10:59	marring - OK			

SOIL AUGER FINDING

TESTED BY *[Signature]*

REMARKS


ALSO PRESENT

LOT NO.

2-21-63
Carl H. Barnett

2-7-63 Carl H. Barnett

4-Sec 1

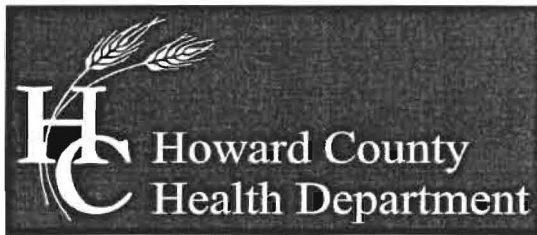

Bureau of Environmental Health

7178 Columbia Gateway Drive, Columbia, MD 21046-2147

Main: 410-313-1771 | Fax: 410-313-2648

TDD 410-313-2323 | Toll Free 1-866-313-6300

www.hchealth.org

Facebook: www.facebook.com/hocohealth

Twitter: HowardCoHealthDep

Peter L. Beilenson, M.D., M.P.H., Health Officer

August 21, 2012

Mr. & Mrs. Thomas E. Mock
7527 Browns Bridge Road
Highland, MD 20777

RE: **Waiver Approval**
7527 Browns Bridge Road
Highland, MD 20777

Dear Sir and Madam,

The Health Department has received your waiver request dated August 8, 2012 for the above referenced property. The request to waive a perc certification plan has been approved due to the failing perc results in the area of the proposed pole barn. The amount of repair area for future repair of the on-site sewage disposal system will not be affected by the barn.

Approval of a building permit will be granted by this Department provided that the site plan submitted with the building permit application is consistent with this waiver approval. Any deviations from the approval will be subject to further review by this Department.

Any questions regarding this decision may be directed to the Well and Septic Program of the Howard County Health Department.

Respectfully,

A handwritten signature in cursive script that reads 'Michael J. Davis'.

Michael J. Davis, R.S.

Assistant Director

Bureau of Environmental Health