

APPLICATION

SEWAGE DISPOSAL TESTING

STATE OF MARYLAND - DEPARTMENT OF HEALTH AND MENTAL HYGIENE

HOWARD COUNTY HEALTH DEPARTMENT
ENVIRONMENTAL HEALTH SERVICES

P. O. BOX 476 ELLICOTT CITY, MARYLAND 21043
TELEPHONE: 992-2330

A 33230

P _____

DISTRICT 5th

DATE Oct. 25, 1983

TO: THE COUNTY HEALTH OFFICER
ELLICOTT CITY, MARYLAND

I, HEREBY, APPLY FOR THE NECESSARY TEST IN ORDER TO CONSTRUCT (OR RECONSTRUCT) A SEWAGE DISPOSAL SYSTEM.

PROPERTY OWNER Elizabeth R. Tharin FRANK BAKER

ADDRESS _____ PHONE _____

PROPERTY LOCATION:

SUBDIVISION HERITAGE WOODS LOT NO. 4-A

ROAD AND DESCRIPTION 7299 Brown Bridge Road near RT 216

taxmap 40, parcel 474

SIZE OF LOT _____ TYPE BLDG. _____ (NUMBER OF BEDROOMS)

THE SYSTEM INSTALLED UNDER THIS APPLICATION IS ACCEPTABLE ONLY UNTIL PUBLIC FACILITIES BECOME AVAILABLE. I FULLY UNDERSTAND THE FEE CONNECTED WITH THE FILING OF THIS PERC TEST APPLICATION IS NON-REFUNDABLE UNDER ANY CIRCUMSTANCES. I ALSO AGREE TO COMPLY

WITH ALL M.O.S.H.A. REQUIREMENTS IN TESTING THIS LOT. /s/ Don Reuwer/ Williams & Hanson
(SIGNATURE OF APPLICANT)

APPROVED BY Raymond W. Berger FOR Trench or physical DATE 12/13/83

REJECTED BY _____ FOR _____ DATE _____

HOLD PENDING FURTHER TESTS Y DATE _____

REASONS FOR REJECTION OR HOLDING 11/9/83 Perc OK Hold for Perc Cert Plat RH
12/13/83 Spec written RH

BLDG. PERMIT SIGNED
AND RETURNED 5/11/87

THIS IS NOT A PERMIT

BP # 11751
JAH

SOIL PROFILE

0'

INDICATE NORTH - NAME ADJOINING ROADWAY AS BASE LINE.

DATE	TEST NO.	DEPTH	PRE-WET		TEST - 1" DROP		TIME
			START	STOP	START	STOP	

REMARKS _____

TYPE OF SOIL _____

TESTED BY _____ ALSO PRESENT _____

EH-12-1079

APPLICATION

SEWAGE DISPOSAL TESTING

STATE OF MARYLAND - DEPARTMENT OF HEALTH AND MENTAL HYGIENE

A 33230


P _____

HOWARD COUNTY HEALTH DEPARTMENT
ENVIRONMENTAL HEALTH SERVICES

P. O. BOX 476 ELLICOTT CITY, MARYLAND 21043
TELEPHONE: 992-2330

DISTRICT 5th

DATE Oct. 25, 1983

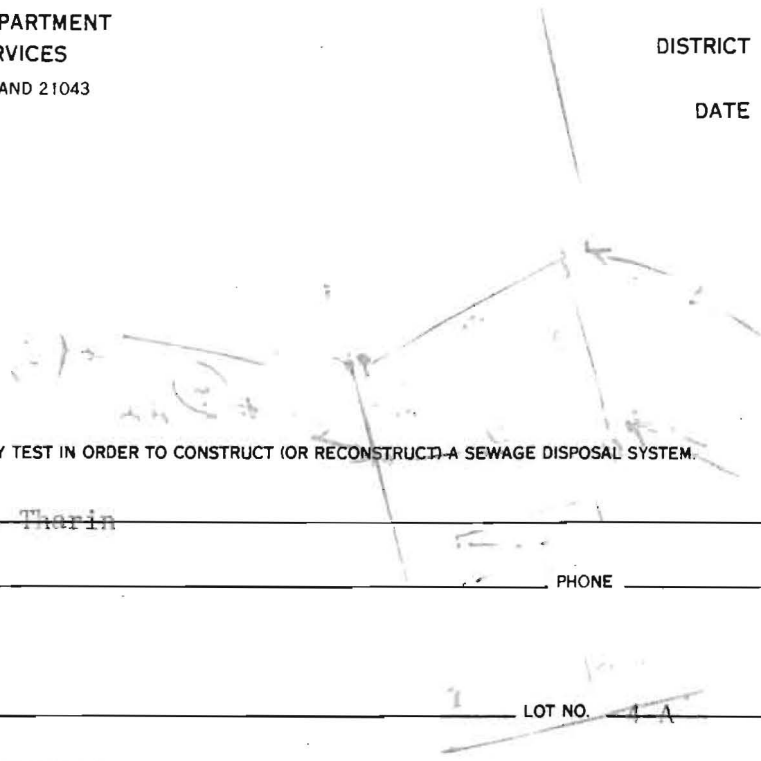

TO: THE COUNTY HEALTH OFFICER
ELLICOTT CITY, MARYLAND

I, HEREBY, APPLY FOR THE NECESSARY TEST IN ORDER TO CONSTRUCT (OR RECONSTRUCT) A SEWAGE DISPOSAL SYSTEM.

PROPERTY OWNER Elizabeth P. Tharin

ADDRESS _____ PHONE _____

PROPERTY LOCATION:

SUBDIVISION _____ LOT NO. 1 A

ROAD AND DESCRIPTION Brown Bridge Road

SIZE OF LOT _____ TYPE BLDG. _____ (NUMBER OF BEDROOMS)

THE SYSTEM INSTALLED UNDER THIS APPLICATION IS ACCEPTABLE ONLY UNTIL PUBLIC FACILITIES BECOME AVAILABLE. I FULLY UNDERSTAND THE FEE CONNECTED WITH THE FILING OF THIS PERC TEST APPLICATION IS NON-REFUNDABLE UNDER ANY CIRCUMSTANCES. I ALSO AGREE TO COMPLY WITH ALL M.O.S.H.A. REQUIREMENTS IN TESTING THIS LOT.

/s/ Don Reuwer/ Williams & Hanson
(SIGNATURE OF APPLICANT)

APPROVED BY _____ FOR _____ DATE _____



REJECTED BY _____ FOR _____ DATE _____

HOLD PENDING FURTHER TESTS _____ DATE _____

REASONS FOR REJECTION OR HOLDING _____

THIS IS NOT A PERMIT

4A

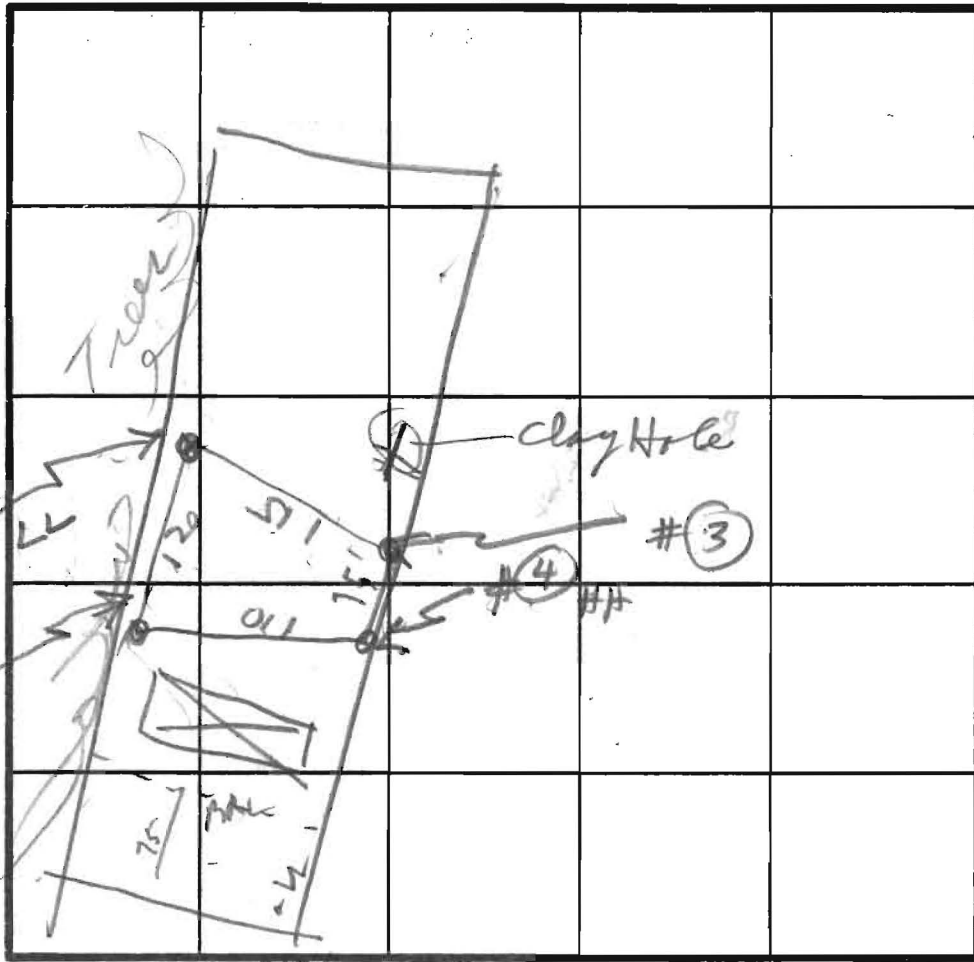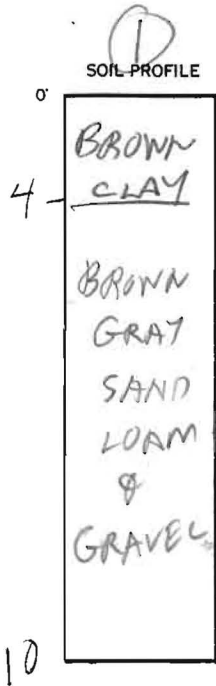

INDICATE NORTH - NAME ADJOINING ROADWAY AS BASE LINE.



HOLE ELEV
① = HIGH
② = LOW

DATE	TEST NO.	DEPTH	PRE-WET		TEST - 1" DROP		TIME
			START	STOP	START	STOP	
11/4	1V	10	LOOKS OK	BELOW	4 FT		
11/4	2V	13	LOOKS OK	BELOW	5-6 FT		
	3	ON LINE HOLE		SEE RESULTS FOR LOT 4B			
	4	ON LINE HOLE		SEE RESULTS FOR LOT 4B			
	1S	5	152	153	153	155	2
11/9	2S	6 1/2	202	208	208	220	12
					76		

REMARKS EP SAID OK TO USE ONLINE HOLES FOR BOTH Lot 4A & 4B

TYPE OF SOIL _____
TESTED BY BH ALSO PRESENT R HODGES

EH-12-1079