

LAYOUT 4-26-12 INSP 4 _____
INSP 2 4-27-12 INSP 5 _____
INSP 3 _____ INSP 6 _____

ISSUE DATE: 4-10-12

PERMIT

P 536798

APPROVAL DATE: 4-27-12

A UPGRADE

Tax ID # 1405343682

**ON-SITE SEWAGE DISPOSAL SYSTEM
TANK REPLACEMENT
HOWARD COUNTY HEALTH DEPARTMENT
BUREAU OF ENVIRONMENTAL HEALTH**

South Carroll Backhoe, Inc.

IS PERMITTED TO

INSTALL ALTER

ADDRESS: 4410 Salem Bottom Rd Westminster 21157 PHONE NUMBER: 410-875-4197

SUBDIVISION: Thompson Property LOT NUMBER: 5

ADDRESS: 7968 Browns Bridge Road PROPERTY OWNER: Sam Adamczyk

SEPTIC TANK CAPACITY (GALLONS): 1,500 OUTLET BAFFLE FILTER REQUIRED

PUMP CHAMBER CAPACITY (GALLONS): N/A COMPARTMENTED TANK REQUIRED

NUMBER OF BEDROOMS: 4

SQUARE FOOTAGE OF HOUSE: ~3,400


NOTES:	Do not order the septic tank until after layout inspection and Sanitarian approval. Layout inspection required prior to tank installation. Original septic tank must be properly abandoned before new tank installation. A written variance request is required for tanks deeper than 3 feet. A traffic bearing lid is required for tanks deeper than 4 feet.
--------	--

PLANS APPROVED: HS/KW DATE: 3/16/2012

- NOTE: PERMIT VOID AFTER 2 YEARS
- NOTE: CONTRACTOR RESPONSIBLE FOR SCHEDULING A PRE-CONSTRUCTION INSPECTION FOR ALL INSTALLATIONS
- NOTE: WATERTIGHT SEPTIC TANKS REQUIRED
- NOTE: ALL PARTS OF SEPTIC SYSTEM SHALL BE 100 FEET FROM ANY WATER WELL
- NOTE: MANHOLE RISERS REQUIRED ON ALL SEPTIC TANKS AND PUMP CHAMBERS
- NOTE: AN ELECTRICAL PERMIT IS REQUIRED FOR INSTALLATION OF ANY ELECTRICAL COMPONENTS OF THE SYSTEM

**NEITHER THE HOWARD COUNTY COUNCIL OR THE HEALTH DEPARTMENT IS
RESPONSIBLE FOR THE SUCCESSFUL OPERATION OF ANY SYSTEM
PERMITTEE RESPONSIBLE FOR OBTAINING FINAL APPROVAL ON THIS PERMIT
CALL 410-313-1771 FOR INSPECTION OF SEPTIC SYSTEM**

NOT TO SCALE

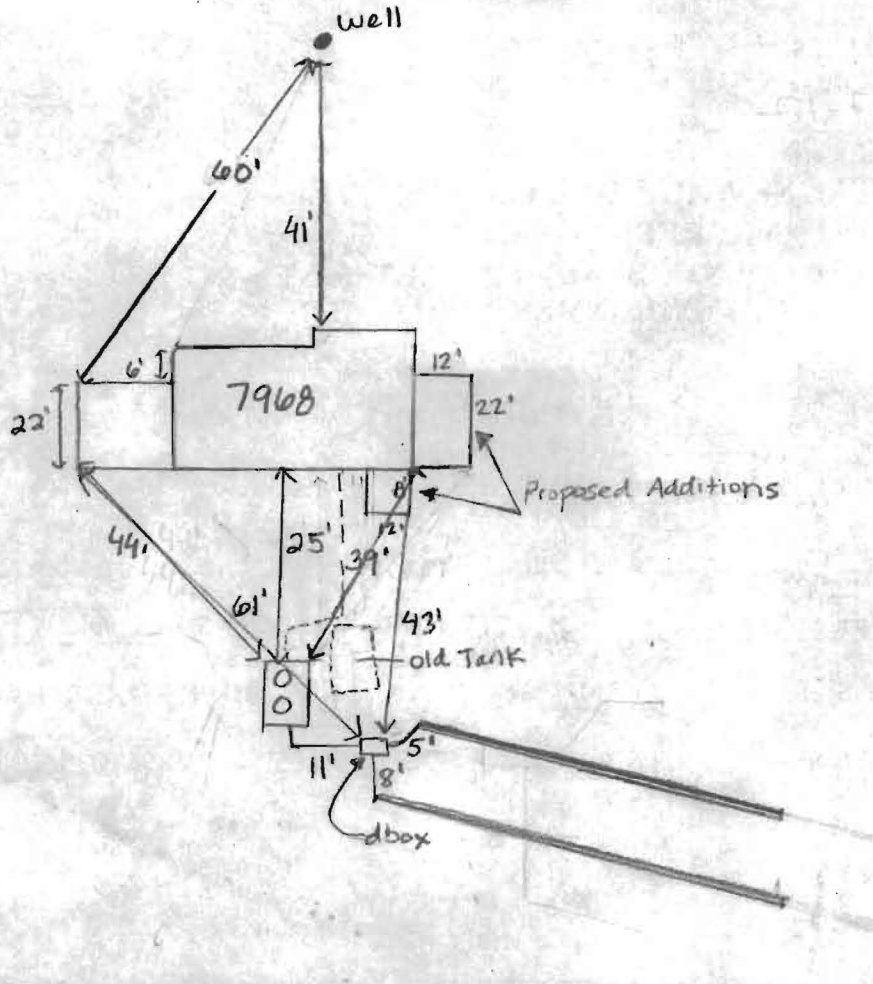

TRENCH/DRAINFIELD DATA

WIDTH _____ INLET _____ BOTTOM _____
existing trenches
 NUMBER OF TRENCHES 2
 TOTAL LENGTH 148'
 ABSORPTION AREA _____
 DISTRIBUTION BOX LEVEL OK
 DISTRIBUTION BOX BAFFLE OK
 DISTRIBUTION BOX PORT OK

SEPTIC TANK DATA

SEPTIC TANK I LEVEL _____
 MANUFACTURER Babylon
 CAPACITY 1500 GAL
 SEAM LOC yes
 TANK LID DEPTH 6"
 BAFFLES OK
 BAFFLE FILTER _____
 MANHOLE LOC front & rear
 6" PORT LOC _____
 WATERTIGHT TEST _____
 SLOTTED yes
 DATE ON LID 3-6-12
 PUMP/SEPTIC TANK LEVEL _____
 MANUFACTURER _____
 CAPACITY _____ GAL
 SEAM LOC _____
 TANK LID DEPTH _____
 BAFFLES _____
 BAFFLE FILTER _____
 MANHOLE LOC _____
 6" PORT LOC _____
 WATERTIGHT TEST _____
 SLOTTED _____
 DATE ON LID _____

ROAD NAME

PRE-CONSTRUCTION:

4/26/12 Keep new S.T. 20' from proposed addition and 100' from existing well. Pump & collapse old tank. Tank will be made slightly downhill to make fall back to trenches. New Dbox will have to be installed. obs. pipes to be installed @ end of ex. tank. (CW)

INSTALLATION:

4/26/12 (pm) New tank is set. old tank was pumped and crushed. New piping to tank done. Tank is operating. 4-27-12
 Connection to dbox not done yet. New dbox installed. D. Drilled.
4-27-12 - New dbox installed and leveled. Dbox moved slightly to make fall to trenches. Risers installed on tank.
 OK to backfill HS

FINAL INSPECTOR

HS

DATE OF APPROVAL

4-27-12

12-19-85
ASAP

APPROVED
12-19-85
RH
36328

PERMIT

SEWAGE DISPOSAL SYSTEM

MARYLAND STATE DEPARTMENT OF HEALTH

P. _____
A. 26975

HOWARD COUNTY
BUREAU OF ENVIRONMENTAL HEALTH
982-2833
461-9933

05-343682

ELLICOTT CITY
DISTRICT 5th
DATE 12/13/85

INDEXED

Bouley Enterprises

IS PERMITTED TO INSTALL ALTER

ADDRESS 12626 Lime Kiln Road, Fulton, Maryland 20759 PHONE 953-9076

SUBDIVISION Thompson Property ROAD 7948 Brown Bridge Rd LOT 5

PROPERTY OWNER Bouley Enterprises *1st driveway part*

ADDRESS Lime Kiln Valley Subdivision

IF GARBAGE GRINDER IS USED INCREASE SEPTIC TANK CAPACITY BY 50% AND ABSORPTION AREA BY 22%.

GARBAGE GRINDER? YES NO

3 BR & NO
GARBAGE
GRINDER

SEPTIC TANK CAPACITY 1250 ~~1000~~ GALLONS NUMBER OF BEDROOMS 3

TRENCHES - 200 sq. ft. per bedroom. Trench to be 2 feet wide. Inlet 4 feet below original grade. Bottom maximum depth 8 feet below original grade. Effective area begins at 4 feet below original grade. 4 feet of stone below distribution pipe.

LOCATION: Place the distribution box 205 feet from the rear (115') lot line and 60 feet from the left lot line as seen when facing the property from the right-of-way line.

NOTE: No trench to exceed 100 feet in length. If more than one trench used, a distribution box is required. Trenches to be installed on level ground. Call for inspection of trench(s) before and after gravel is installed. Provide 6" - 8" diameter cleanout and cap to grade or above on septic tank.

RH
Changed it to 19 ft after inspection of well

PLANS APPROVED BY C. Williams DATE 12/12/85

COVER NO WORK UNTIL INSPECTED AND APPROVED.

NEITHER THE HOWARD COUNTY COUNCIL NOR THE HEALTH DEPARTMENT IS RESPONSIBLE FOR THE SUCCESSFUL OPERATION OF ANY SYSTEM.

- NOTE: IF TRENCH IS USED CALL FOR INSPECTION BEFORE AND AFTER PLACING GRAVEL IN TRENCH.
 - NOTE: NO DRY WELL SHALL EXCEED 15 FOOT IN DIAMETER. NO ABSORPTION TRENCH TO EXCEED 100 FEET IN LENGTH.
 - NOTE: ALL PIPE FROM HOUSE TO SEPTIC TANK MUST BE CAST IRON OR SCHEDULE 40 PVC OR ABS.
- PERMIT VOID AFTER THREE YEARS.


NOTE: INSTALL STAND PIPE ON SEPTIC TANK AND DRY WELL. STAND PIPES MUST BE 6 INCHES IN DIAMETER. CAST IRON, CONCRETE OR TERRA COTTA, OR PVC OR ABS ACCEPTED. IF TOP OF SEPTIC TANK IS DEEPER THAN 3 FEET MANHOLE TO GRADE REQUIRED.

***INSTALLER IS RESPONSIBLE FOR OBTAINING FINAL APPROVAL ON THIS PERMIT**

*CALL 992-2330 FOR INSPECTION OF SEPTIC SYSTEMS.

EH - 2-1082

A 26975

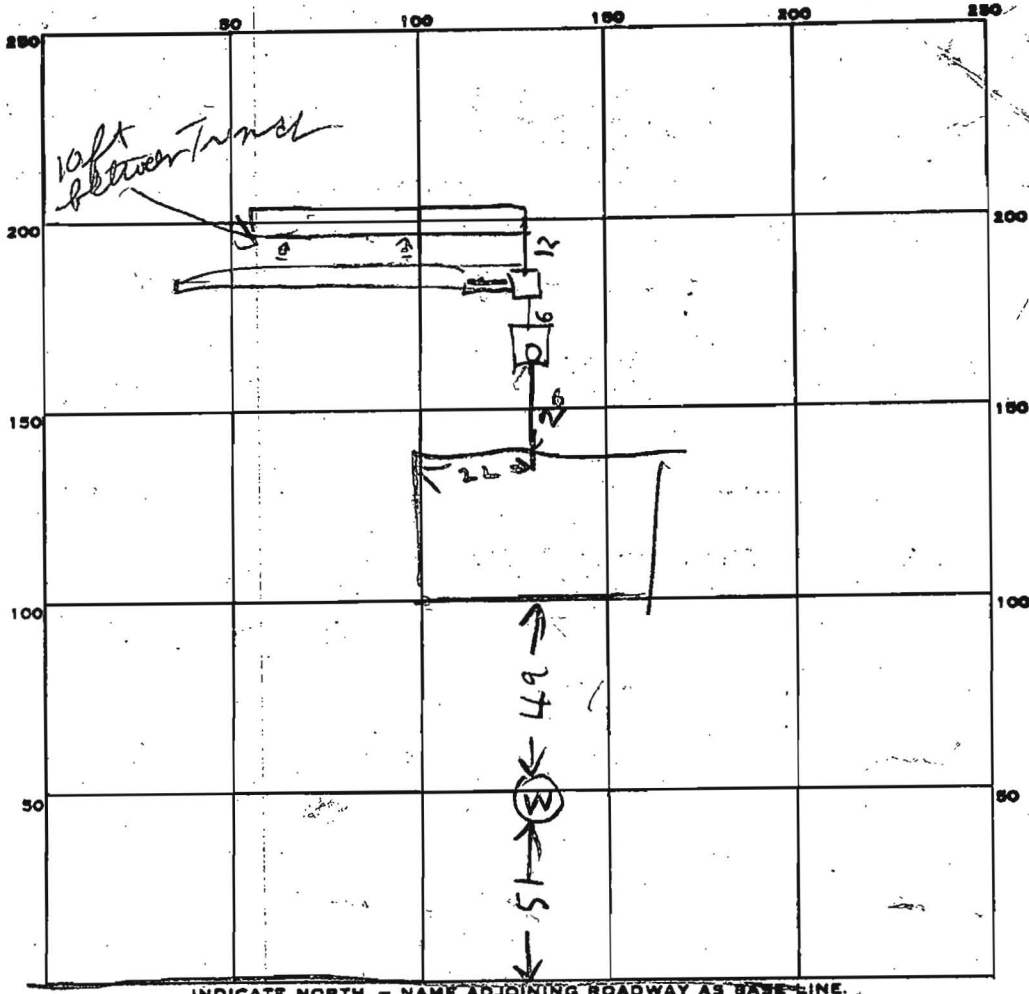

PERMIT CARD _____

SEPTIC TANK, LEVEL OK 1000

CLEANOUTS ST
NO ✓

DISTRIBUTION BOX, LEVEL OK

#1	#2	#1	#2
7	8-9	2	2

TILE FIELD, DEPTH _____ FT. TRENCH WIDTH _____ FT.

#1	#2	#1	#2
3	4.5	6.7	7.7

GRAVEL DEPTH _____ IN. TOTAL LENGTH _____ FT.

2	283	346	559 TOTAL
---	-----	-----	-----------


NUMBER OF TRENCHES _____ TOTAL BOTTOM AREA _____

SEEPAGE PITS, INSIDE DIAMETER _____ FT. DEPTH BELOW INLET _____ FT.

ABSORBENT AREA _____ SQ. FT.

REMARKS 12/16/85 DIG 1st TRENCH LONGER 9. ADD STONE
DIG 2nd TRENCH 12/16/85 PM - TRENCH #1 DUG LONGER 7 FT
12/16/85 4:00 PM - OK TO COVER TRENCH #1 FINISH DIGGING
TRENCH #2 OK TO COVER HOUSE SEWER. ADD STONE TO TRENCH
#2 BUT LEAVE FAREND OPEN R/H 12/19/85 Trench #2 DUG
PUT PAPER ON STONE CONNECT TO BOX & COVER

DATE SYSTEM APPROVED 12/19/85 INSPECTOR Raymond Hodler

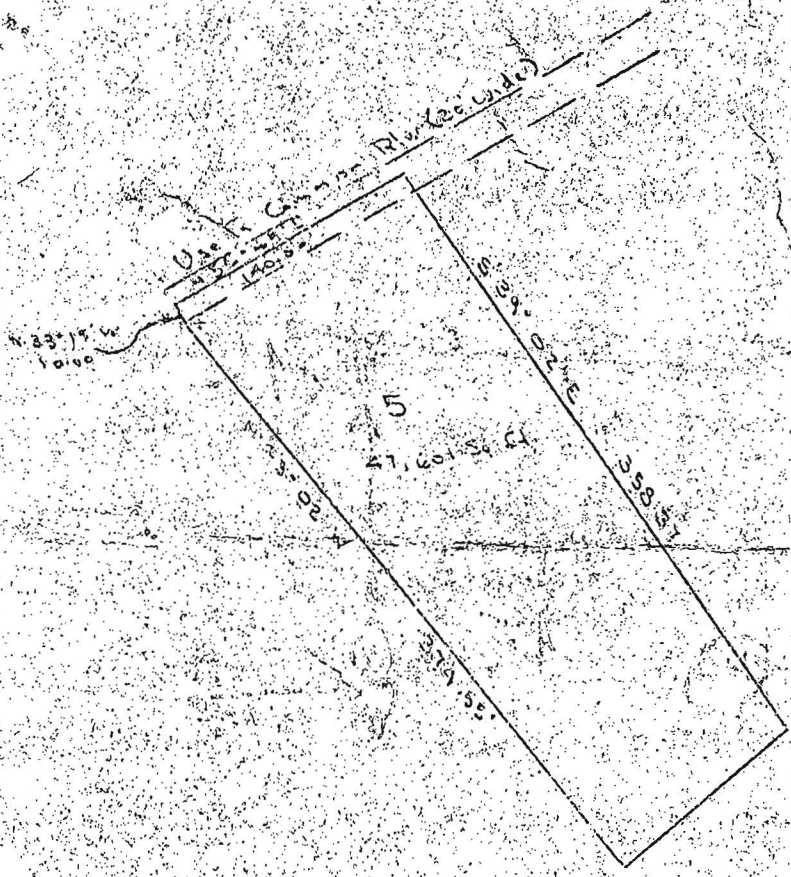


Approved for record by the Board of Public Works

Done and signed by the Clerk of the Board of Public Works

PLAT OF SURVEY
 FOR
 FIVE (5) LOTS
 WITH ELECTION DISTRICT OF MOUNTAIN VIEW CITY
 MOUNTAIN VIEW, MARYLAND
 SCALE 1" = 100 FT.

Witness my hand and seal of the County of Prince George's, Maryland, this 10th day of August, 1968.

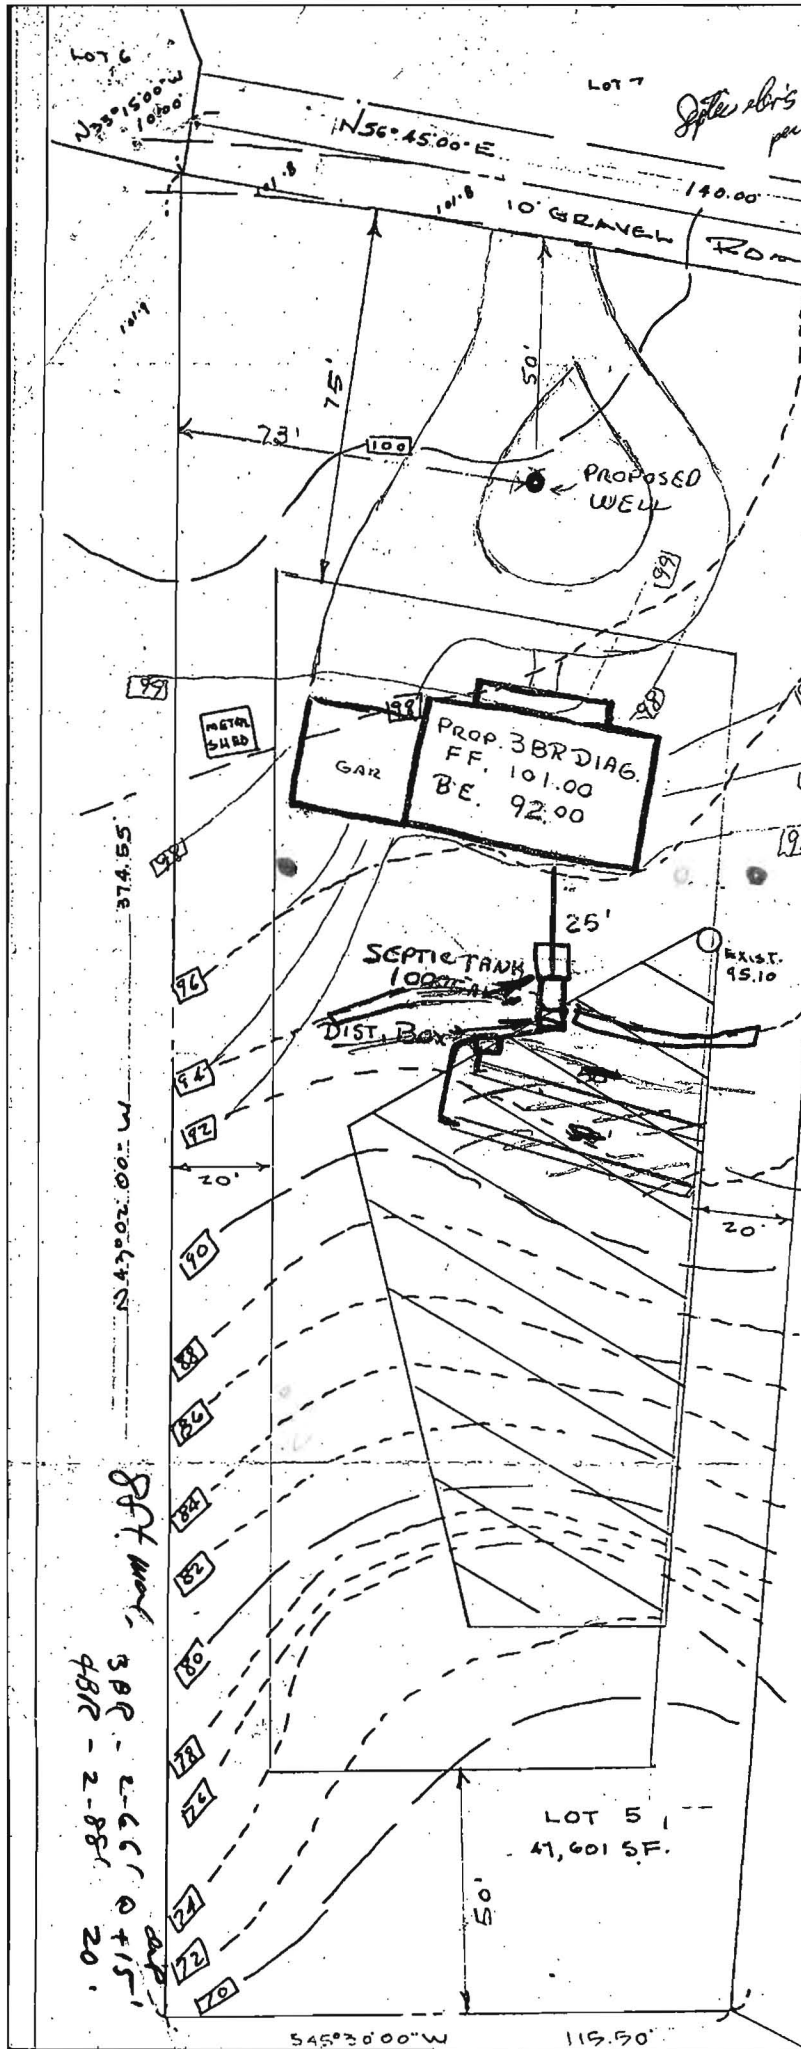

B.P. 66997

Septic slab's location perhaps ft 9.30.85.

SEPTIC SYSTEM DATA:
 LOT 5
 INV. @ HOUSE 91.25
 SEPTIC TANK (1000 GAL.)
 EX GR. 91.75
 FIN GR. 91.75
 INV. IN 88.25 90.85
 INV. OUT 88.00 90.60
 DISTRIBUTION BOX
 EX GR. 91.50
 FIN GR. 91.50
 INV. IN 87.75 90.40
 INV. OUT 87.50 90.30
 TRENCH #1 (50'x2'x5' BELOW INLET)
 EX GR 91.50 94.0
 FIN GR 91.50 94.0
 TOP OF STONE 87.50 90.7
 INV. IN 87.00 90.3
 BOTTOM OF STONE 82.50 86.0
 TRENCH #2 (50'x2'x5' BELOW INLET)
 EX GR 91.00 92.0
 FIN GR 91.00 92.0
 TOP OF STONE 87.00 88.3
 INV. IN 86.50 88.0
 BOTTOM OF STONE 82.00 84.0

adjusted next page

SITE PLAN
 LOT 5 THOMPSON PROPERTY
 5TH ELECTION DISTRICT
 HIGHLAND, MD
 HOWARD COUNTY, MD
 SCALE 1"=30' OCT. 2001
 TAX MAP 40 P. 270



FIELD RUN TOPOGRAPHY BY
 HUDKINS ASSOCIATES
 231 JOSEPH SQUARE
 COLUMBIA, MD 21042

Part work 3BR - 2661 @ +15' 4BR - 2-88' 20'

LOT 5
 41,601 SF.

545°30'00"W 115.50'