

8/5/63

Choot

PERMIT

SEWAGE DISPOSAL SYSTEM

approx 5/4/63
2-27003
2-27056

MARYLAND STATE DEPARTMENT OF HEALTH

HOWARD COUNTY

ELLICOTT CITY

DISTRICT _____

DATE 7/2/63

INDEXED

INDEXED

Frank Elias & Sons

IS PERMITTED TO INSTALL X ALTER _____

ADDRESS _____

PHONE _____

A SEWAGE DISPOSAL SYSTEM LOCATED AT Burnt Woods Rd. - approx. 1/2 mile from No. 32

SUBDIVISION BERRY

ROAD _____

LOT _____

PROPERTY OWNER _____

Jackson, Samuel Raymond

ADDRESS _____

SPECIFICATIONS

DRAIN FIELD X DEPTH _____ FEET, BOTTOM AREA 300 SQ. FT.

OR

SEEPAGE PITS X ABSORBENT SIDE-WALL AREA 300 SQ. FT. below inlet

SEPTIC TANK CAPACITY 750 GALLONS

FOR GARBAGE GRINDER, INCREASE DISPOSAL AREA 25% & TANK CAPACITY 50%.

OTHER Flags system 200 ft. to 260 ft. from edge of Burnt Woods Rd and 280 to 340 ft. from edge of woods which is located near the left side of lot as seen when facing lot from Burnt Woods Rd.

PLANS APPROVED BY Raymond Hodgen

DATE 6/26/63


FILL SEPTIC TANK AND DISTRIBUTION BOX WITH WATER BEFORE CALLING FOR AN INSPECTION. COVER NO WORK UNTIL INSPECTED AND APPROVED.

NEITHER THE HOWARD COUNTY COMMISSIONERS NOR THE HEALTH DEPARTMENT IS RESPONSIBLE FOR THE SUCCESSFUL OPERATION OF ANY SYSTEM.

21010

27
27
2

81
29
110

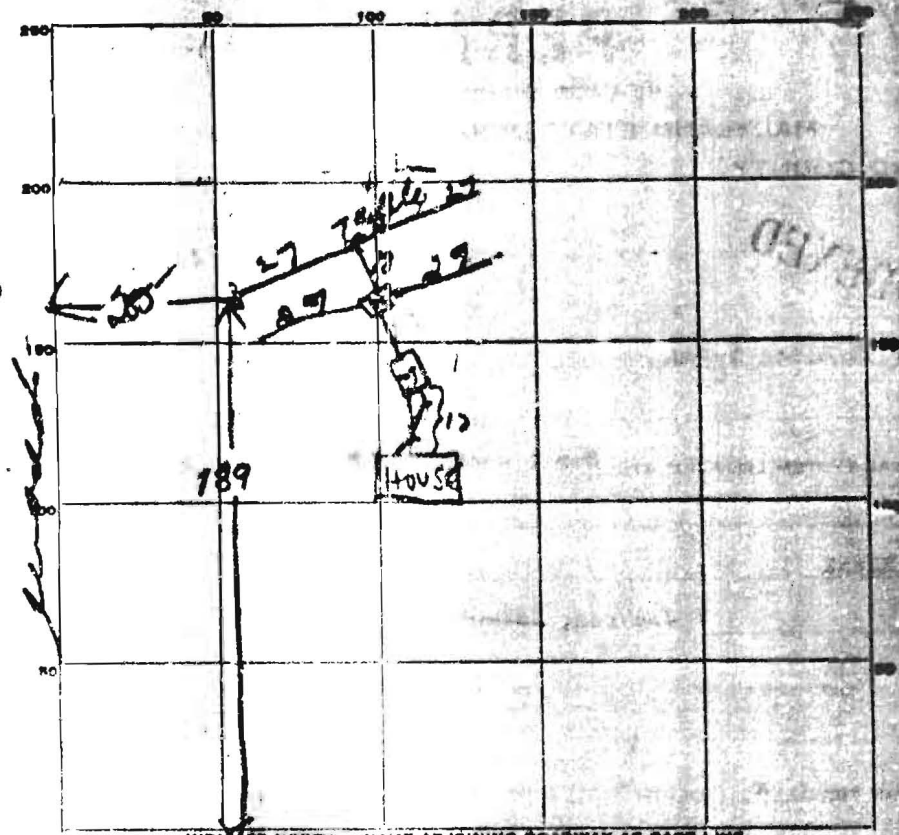

INDICATE NORTH - NAME ADJOINING ROADWAY AS BASE LINE.

PERMIT CARD OK Burnt Woods Road

SEPTIC TANK, LEVEL 750 CLEANOUTS OK

DISTRIBUTION BOX, LEVEL OK

TILE FIELD, DEPTH 345 FT. TRENCH WIDTH 3 FT.

GRAVEL DEPTH 15" IN. TOTAL LENGTH 110 FT.

NUMBER OF TRENCHES 4 TOTAL BOTTOM AREA 334 sq ft

SEEPAGE PITS, INSIDE DIAMETER _____ FT. DEPTH BELOW INLET _____ FT.

ABSORBENT AREA _____ SQ. FT.

REMARKS _____

DATE SYSTEM APPROVED 8/6/60 INSPECTOR Dev Thompson

8/5/63

Clear

PERMIT

SEWAGE DISPOSAL SYSTEM

approved 8/1/63
sum

07013

P 07096

MARYLAND STATE DEPARTMENT OF HEALTH

HOWARD COUNTY

ELLICOTT CITY

DISTRICT 4

DATE 7/2/63

INDEXED

INDEXED

Frank Klien & Sons IS PERMITTED TO INSTALL ALTER

ADDRESS _____ PHONE _____

A SEWAGE DISPOSAL SYSTEM LOCATED AT Burnt Woods Rd. - approx. 1/2 mile from Rt. 32

SUBDIVISION ~~XXXX~~ 13780 BURNTWOODS RD ROAD _____ LOT _____

PROPERTY OWNER Jackson, Samuel Raymond

ADDRESS _____

SPECIFICATIONS

DRAIN FIELD DEPTH _____ FEET. BOTTOM AREA 300 SQ. FT.

OR

SEEPAGE PITS ABSORBENT SIDE-WALL AREA 300 SQ. FT. below inlet

SEPTIC TANK CAPACITY 750 GALLONS

FOR GARBAGE GRINDER, INCREASE DISPOSAL AREA 22% & TANK CAPACITY 50%.

OTHER Place system 200 ft. to 260 ft. from edge of Burnt Woods Rd and 280 to 340 ft. from edge of woods which is located near the left side of lot as seen when facing lot from Burnt woods Rd.


PLANS APPROVED BY Raymond Hodges DATE 6/26/63

FILL SEPTIC TANK AND DISTRIBUTION BOX WITH WATER BEFORE CALLING FOR AN INSPECTION. COVER NO WORK UNTIL INSPECTED AND APPROVED.

NEITHER THE HOWARD COUNTY COMMISSIONERS NOR THE HEALTH DEPARTMENT IS RESPONSIBLE FOR THE SUCCESSFUL OPERATION OF ANY SYSTEM.

A 07013

A# 07013

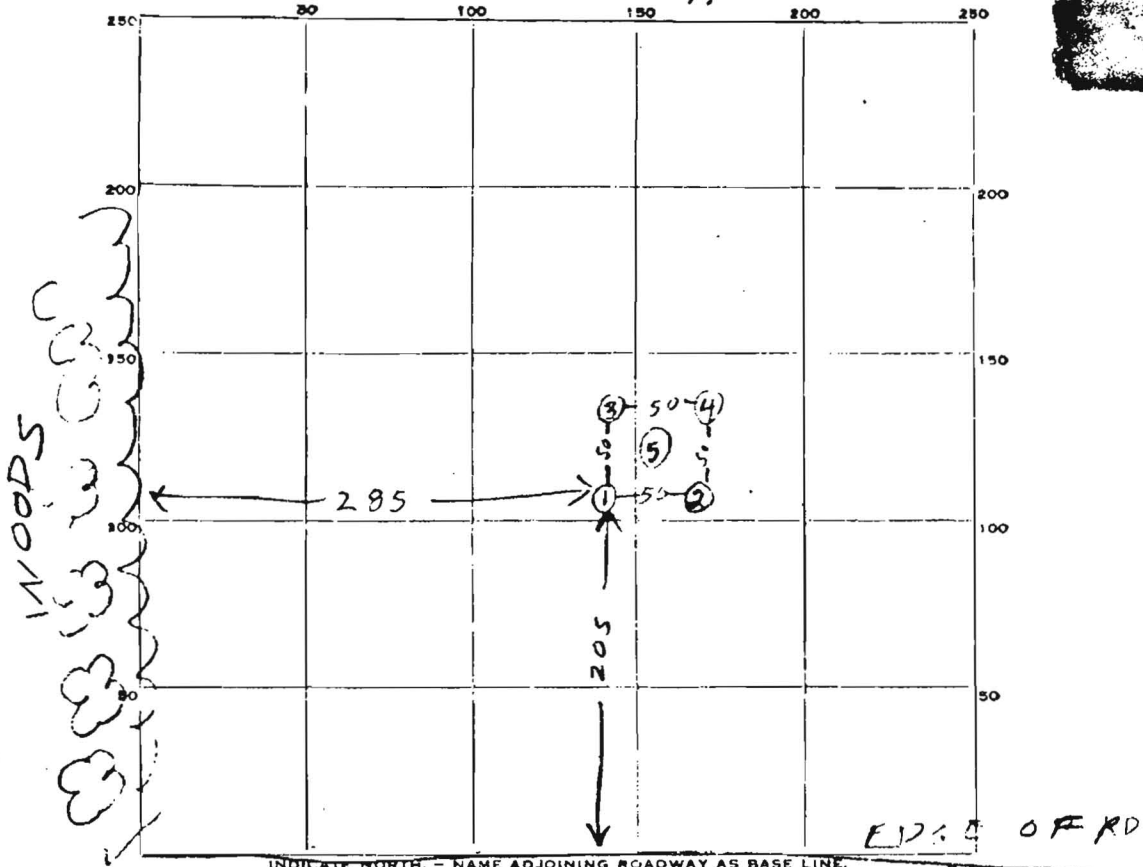

INDICATE NORTH - NAME ADJOINING ROADWAY AS BASE LINE.
 BURNING WOODS RD TORT 32

DATE	TEST NO.	DEPTH	PRE-WET		TEST - 1" DROP		TIME
			START	STOP	START	STOP	
6-26-63	1	4	943	944	944	946	2 min
"	2	4	947	949	943	951	2 min
"	3	4 1/2	951	954	954	957	3 min
"	4	4 1/2	953	955	955	953	3 min
"	5	9	1001	1003	1003	1006	3 min

SOIL AUGER FINDING _____
 TESTED BY Raymond Hedges
 REMARKS _____
 ALSO PRESENT Robert A. ... LOT NO _____