

6/22/98
a.m. 20.
8:40-98
house conn
anytime

9/18/98 WPT
LATE

PERMIT

SEWAGE DISPOSAL SYSTEM

DEPARTMENT OF HEALTH AND MENTAL HYGIENE

04-359097

P 510194

A 49644-B

DISTRICT 4th

DATE 6-10-98

DATE SYSTEM APPROVED 8-4-98

INSPECTOR KM

HOWARD COUNTY HEALTH DEPARTMENT

BUREAU OF ENVIRONMENTAL HEALTH

~~XXXXXXXX~~ 410-313-2640

INDEXED

Fogle's septic Clean, Inc.

IS PERMITTED TO INSTALL X ALTER

ADDRESS 558 Obrecht Road, Sykesville, Maryland 21784

PHONE 410-795-5674

SUBDIVISION Cattail Woods, Section II LOT 8 ROAD 1705 Cattail Meadows Drive

PROPERTY OWNER Pulte Home Corporation David Hausler

ADDRESS

BUILDING PERMIT SIGNED

AND RETURNED

7-22-03 800143106-HOT TUB

SEPTIC TANK CAPACITY 1250 GALLONS

NUMBER OF BEDROOMS 4

210 SQUARE FEET PER BEDROOM

LINEAR FEET OF TRENCH REQUIRED 280

TRENCHES - Trench to be 3 feet wide. Inlet 1.5 feet below original grade. Bottom maximum depth 3.0 feet below original grade. Effective area begins at 1.5 feet below original grade. 2 feet of stone below distribution pipe.

LOCATION - Begin trenches 100 feet up the 365.98' lot line and 35 feet off that same lot line. Run trenches on contour toward Cattail Meadows Drive.

NOTES - No trench to exceed 100 feet in length. Provide 6" - 8" diameter cleanout and cap to grade or above on septic tank.

OK KM 6-9-98

6/10/98 House location raised - moved toward front of lot 7' - septic permit raised & Approved

PLANS APPROVED BY Amy McMillen/

DATE 6/05/98

COVER NO WORK UNTIL INSPECTED AND APPROVED

NEITHER THE HOWARD COUNTY COUNCIL NOR THE HEALTH DEPARTMENT IS RESPONSIBLE FOR THE SUCCESSFUL OPERATION OF ANY SYSTEM

NOTE: CLEANOUT REQUIRED EVERY 70 FEET OF SEWER LINE AND/OR AT 90° SWEEPS IN LINES FROM HOUSE TO DRAIN FIELDS, 90° ELBOWS NOT ACCEPTABLE.

NOTE: ALL PARTS OF SEPTIC SYSTEMS (I.E. TANK, DISTRIBUTION BOX TRENCHES) TO BE 100 FEET FROM WELL (UNLESS OTHERWISE SPECIFICALLY AUTHORIZED)

NOTE: IF DEEP TRENCH(ES) ARE USED CALL FOR INSPECTION BEFORE AND AFTER PLACING GRAVEL IN TRENCH(ES)

NOTE: NO DRY WELL SHALL EXCEED 15 FOOT IN DIAMETER NO ABSORPTION TRENCH TO EXCEED 100 FEET IN LENGTH

NOTE: ALL PIPE FROM HOUSE TO SEPTIC TANK MUST BE CAST IRON OR SCHEDULE 35/40 PVC OR ABS

PERMIT VOID AFTER TWO YEARS

NOTE: INSTALL STAND PIPE ON SEPTIC TANK AND DRY WELL STAND PIPES MUST BE 6 INCHES IN DIAMETER CAST IRON, CONCRETE OR TERRA COTTA OR PVA OR ABS ACCEPTED. IF TOP OF SEPTIC TANK IS DEEPER THAN 3 FEET. MANHOLE TO GRADE REQUIRED.

NOTE: DISTRIBUTION BOXES MUST HAVE BAFFLES

***INSTALLER IS RESPONSIBLE FOR OBTAINING FINAL APPROVAL ON THIS PERMIT**


HD-260(6-90)

*CALL 461-9933 FOR INSPECTION OF SEPTIC SYSTEM.

~~BLDG PERMIT SIGNED~~
~~AND RETURNED~~ 4/11/01
800129545-pool
BLDG PERMIT SIGNED
AND RETURNED 4-22-99
Serial # 20117988
deck & surround porch

A 199644 B

Ho 940365

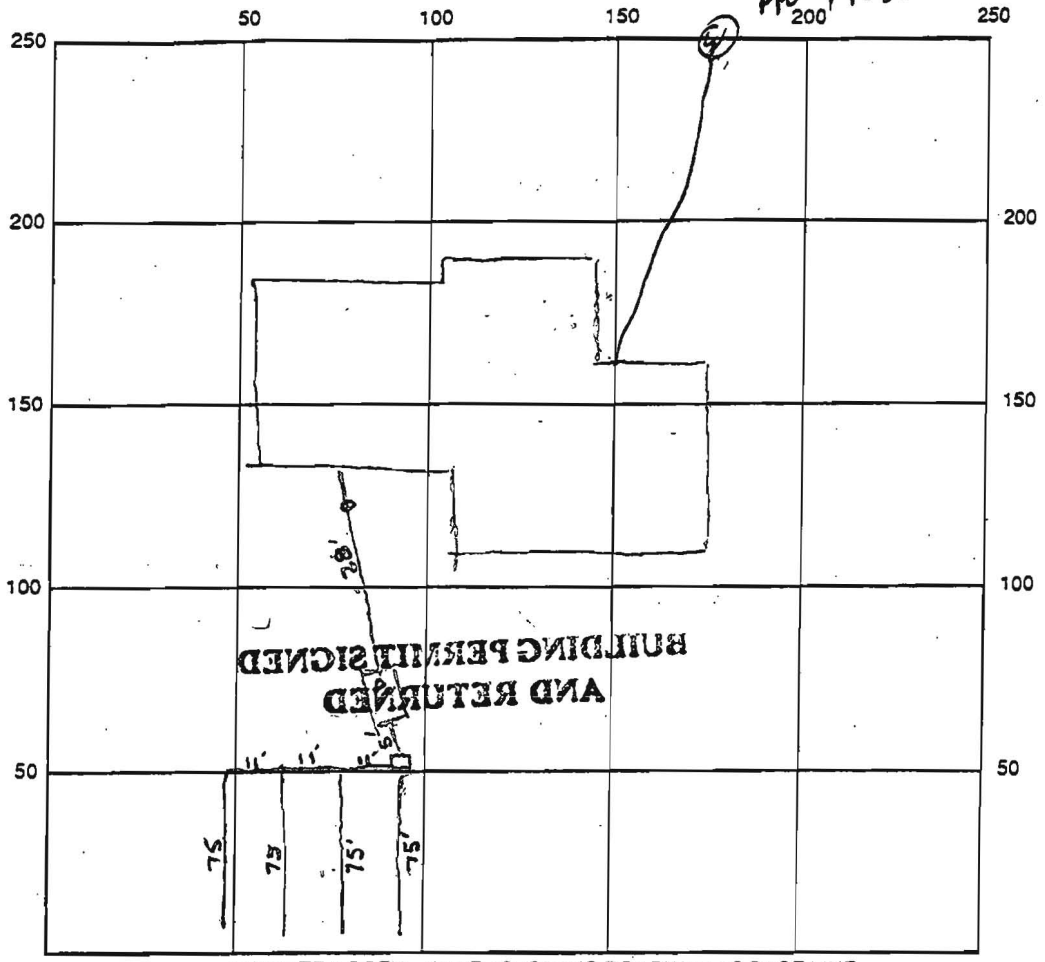

INDICATE NORTH - NAME ADJOINING ROADWAY AS BASE LINE
CATTAIL MEADOWS DRIVE

SEPTIC TANK LEVEL OK, 1250 gal CLEANOUTS 1 at septic tank, 1 at house

DISTRIBUTION BOX LEVEL OK

DRAIN FIELD/TITLE DEPTH 3 FT. TRENCH WIDTH 3 FT. INLET DEPTH 1 1/2 FT.

EFFECTIVE GRAVEL DEPTH 1 1/2 FT. TOTAL LENGTH 300 FT.

NUMBER OF TRENCHES 4 ONE SIDEWALL/BOTTOM AREA 900 SQ. FT.

DRYWALL INSIDE DIAMETER FT. EFFECTIVE DEPTH BELOW INLET 1 1/2 FT.

ABSORBENT AREA SQ. FT.

REMARKS: 6/18/98 Contractor reports plumbing coming out under the footer (3' too deep)
builder agreed to change plumbing to a hung sewer (per contractor & I)
6/23/98 No house connection, OK to cover up to house connection
8.4.98 has house conn, ok to cover Km
9/21/98 WPT, ROPE FOR PUMP TO BE HUNG INSIDE CASING, WELL LINE AT PITERS ADAPTER
TO PERSONAL SUPPORT PRIOR TO BACK ETLW. (Done) ok to cover

DATE SYSTEM APPROVED 8.4.98 INSPECTOR Jim [Signature]

9-21-98
 WPT OK
 INSTALLER IS ATTACHING ROPE
 FOR MOTOR INSIDE OF CASING
 AS SOON AS EYE BOLT IS INSTALLED

HOWARD COUNTY HEALTH DEPARTMENT
 Bureau of Environmental Health
 3525-H Ellicott Mills Drive
 Ellicott City, MD 21043
 461-9933

APPLICATION FOR PITLESS ADAPTER, WELL PUMP AND PRESSURE TANK INSTALLATION

New Installation X
 Replacement _____

Receipt # _____
 Date 9/21/98

Name of Installer R. W. R. PLUMBING

Telephone 410 531 2982

License Number _____
 Certified Well Pump Installer _____ Well Driller _____ Registered Plumber

Name of Property Owner PULTE HOME CORP. Telephone _____
 Subdivision CATYAL WOODS II Lot # 8 Well Tag # HO-94-0365
 Site Address 1705 CATYAL MEADOWS DR

Pump	Motor	Pitless Adapter
1. Type	1. Horsepower <u>3/4</u>	1. Make <u>CAMPBELL</u>
a. Deep well jet _____	2. RPM <u>3450</u>	2. Model # <u>B-300X</u>
b. Shallow well jet _____	3. Voltage <u>230</u>	3. Depth <u>36"</u>
c. Submersible _____	a. 110 _____	
2. Make <u>JACOZZI</u>	b. 220 _____	
3. Model # <u>T7541011A-52</u>		
4. Capacity _____ GPM		
5. Pump exceeds well capacity Yes _____ No _____		
6. If Yes, is low pressure cutoff switch installed? Yes _____ No _____		
7. What methods are used to protect the pump and electrical wiring from vibrations? Torque arrestors _____ Cable guards _____ Other _____		

Tank	Piping	Well data
1. Capacity _____	1. Type _____	1. Depth _____ ft.
2. Pressure relief valve? _____	2. Size _____	2. Yield _____ GPM
	3. NSF and/or BOCA Code approved _____	3. Static water level _____ ft.
	4. Depth of supply line _____	4. Will water supply be disinfected by installer? _____

I understand that it is my responsibility to notify the Howard County Health Department when the installation is ready for inspection (otherwise this permit is null and void).

All information given above is true to the best of my knowledge.

Signature of Applicant: Frederick Moore

Date: 21/9/98

Note: A sticker indicating approval/status of the installation will be placed on the well casing at the time of the inspection.


Approved Septic System Plan
Howard County Health Department

John M. Miller
Signature
Date 4/5/77

Septic Elevations

Inv. @ house	585.0
Inv. into tank	583.8
Inv. out of tank	583.5
Inv. into dis. box	583.0
Ex. @ dis. box	584.5

total linear feet of trench required 280 feet
width of trench(es) 3.0 feet
depth of trench(es) 3.0 feet
depth of stone required below distribution pipe 1.5 feet

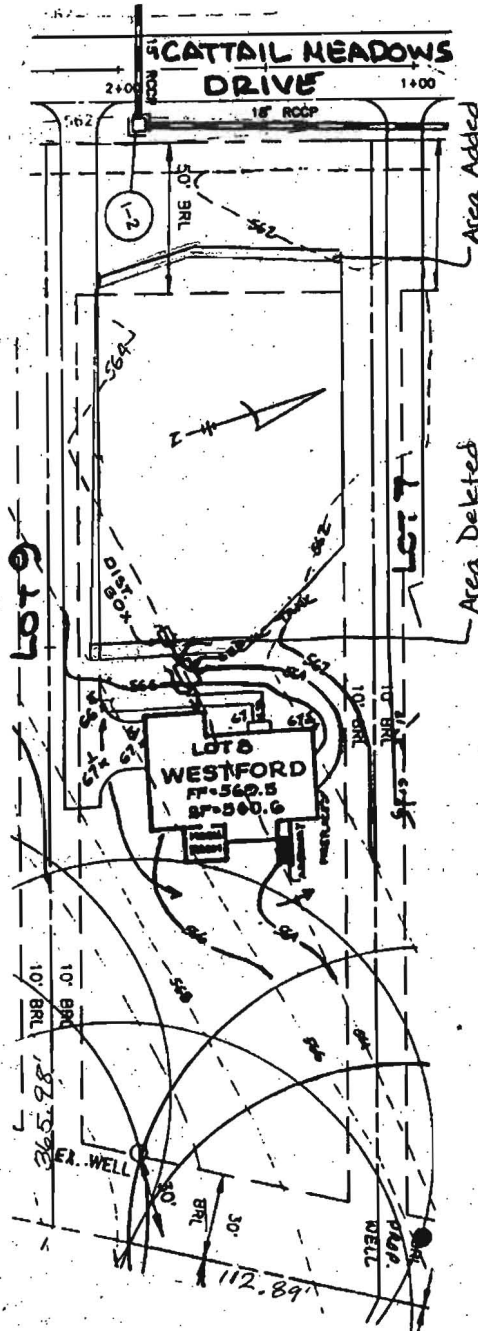

By copy of this plan, the Health Department accepts this modification to the recorded sewage disposal easement.

FF=569.5
BF=560.6

NOTE:

FOR SEDIMENT CONTROL FEATURES SEE APPROVED GRADING PLAN GP-97-130.

PLOT PLAN
CATTAIL WOODS

LOT 8
SECTION TWO, PARCEL 5

TAX MAP NO. 7 PARCEL 137
PLAT NOS. 12500-12502

4TH ELECTION DISTRICT OF HOWARD COUNTY, MARYLAND

SCALE: 1"=50' DATE: OCT. 20, 1997

T S A GROUP INC.
8480 BALTIMORE NATIONAL PIKE, SUITE 418
ELLCOTT CITY, MARYLAND 21043
(410) 465 - 6105