

check out - 10/10/61 - P.M.

# PERMIT *indent*

P 04318  
A 04060

SEWAGE DISPOSAL SYSTEM

MARYLAND STATE DEPARTMENT OF HEALTH  
HOWARD COUNTY

ELLICOTT CITY  
DISTRICT 5  
DATE 10-3-61

## INDEXED

John E. Ruth Co. IS PERMITTED TO INSTALL  ALTER

ADDRESS 400 Overbrook Rd. Baltimore 28 PHONE \_\_\_\_\_

A SEWAGE DISPOSAL SYSTEM LOCATED AT 2 miles off of Rt. 29 on the left hand side of the road Lot is on Cedar Lane a Short distance from Owen Brown Rd. between Rt. 32 and Owen Brown Road

SUBDIVISION \_\_\_\_\_ ROAD \_\_\_\_\_ LOT \_\_\_\_\_

PROPERTY OWNER Thomas Peters

ADDRESS Simpsonville, Maryland

### SPECIFICATIONS

DRAIN FIELD \_\_\_\_\_ DEPTH \_\_\_\_\_ FEET, BOTTOM AREA \_\_\_\_\_ SQ. FT.

SEEPAGE PITS  ABSORBENT SIDE-WALL AREA \_\_\_\_\_ SQ. FT. 10 ft. in diameter by 11 ft. deep below the inlet.  
SEPTIC TANK CAPACITY 1000 GALLONS

FOR GARBAGE GRINDER, INCREASE DISPOSAL AREA 22% & TANK CAPACITY 50%.

OTHER Place the Dry well about 40 ft. to 60 ft. from Cedar Lane and about 110 ft. to 130 ft. from the East side line of the lot; that is the sideline 668 ft. long


This lot is also satisfactory for Tile Fields.

PLANS APPROVED BY Raymond Hodges DATE 8-1-61

FILL SEPTIC TANK AND DISTRIBUTION BOX WITH WATER BEFORE CALLING FOR AN INSPECTION. COVER NO WORK UNTIL INSPECTED AND APPROVED.

NEITHER THE HOWARD COUNTY COMMISSIONERS NOR THE HEALTH DEPARTMENT IS RESPONSIBLE FOR THE SUCCESSFUL OPERATION OF ANY SYSTEM.

A  
04060

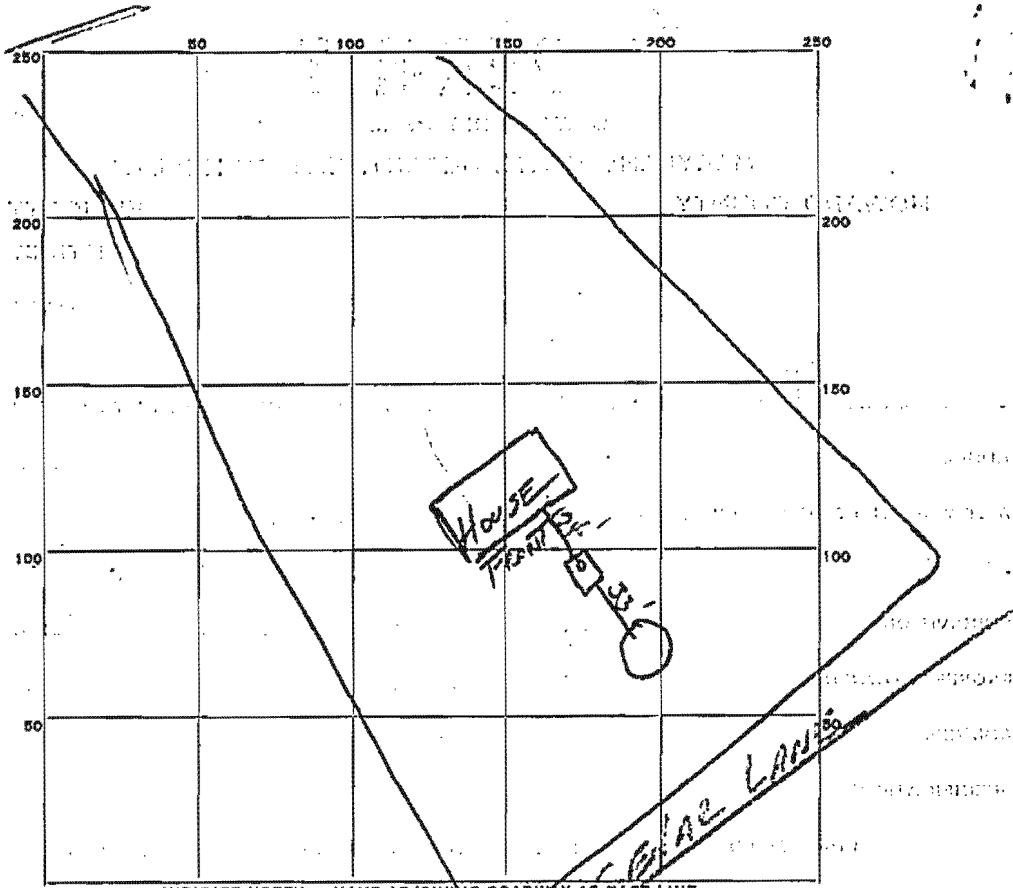

INDICATE NORTH - NAME ADJOINING ROADWAY AS BASE LINE.

PERMIT CARD \_\_\_\_\_  
 SEPTIC TANK, LEVEL 2000 gal metal CLEANOUTS stand pipe  
 DISTRIBUTION BOX, LEVEL None

3.14  
 10  
 3.145  
 3.145  
 345.50

TILE FIELD, DEPTH \_\_\_\_\_ FT. TRENCH WIDTH \_\_\_\_\_ FT.  
 GRAVEL DEPTH \_\_\_\_\_ IN. TOTAL LENGTH \_\_\_\_\_ FT.  
 NUMBER OF TRENCHES \_\_\_\_\_ TOTAL BOTTOM AREA \_\_\_\_\_  
 SEEPAGE PITS, INSIDE DIAMETER 11 FT. DEPTH BELOW INLET 7 FT.  
 ABSORBENT AREA 241 SQ. FT.

31.4  
 3.14  
 345.5  
 241.78  
 3.14  
 345.5

REMARKS Short 101 sq FT 345 No stone in dry well  
241  
101  
Told worker in house buy (rough for building)  
to put 1 1/2 ft of stone around dry well to compensate  
for shortage of 94

DATE SYSTEM APPROVED NA INSPECTOR JUM