

3/26/87
2 Sweeps
(AM + final)

05-399483

P 0523153
P 37937
A 35537
DISTRICT 5th
DATE 3/17/87
DATE SYSTEM APPROVED 3/26/87
INSPECTOR (BN)

PERMIT

SEWAGE DISPOSAL SYSTEM

MARYLAND STATE DEPARTMENT OF HEALTH

HOWARD COUNTY
BUREAU OF ENVIRONMENTAL HEALTH
461-9933

INDEXED

Arnold Backhoe & Septic Services, Inc. IS PERMITTED TO INSTALL X ALTER

ADDRESS P. O. Box 15, Woodbine, Maryland 21797 PHONE 795-7873

SUBDIVISION Buckskin Lake ROAD 4254 Buckskin Lake Dr. LOT 14

PROPERTY OWNER Alex Pagnotta

ADDRESS _____

IF GARBAGE GRINDER IS USED INCREASE SEPTIC TANK CAPACITY BY 50% AND ABSORPTION AREA BY 22%.

GARBAGE GRINDER? YES X NO _____

OK TO INSTALL 4 BR SYSTEM
PER OWNERS ATTACHED LETTER 3/26/87
CW

SEPTIC TANK CAPACITY 2000
2250 GALLONS NUMBER OF BEDROOMS 5 4

TRENCHES - 193 sq. ft. per bedroom with garbage disposal. Trench to be 2 feet wide. Inlet 3.5 feet below original grade. Bottom maximum depth 8.5 feet below original grade. Effective area begins at 3.5 feet below original grade. 5 feet of stone below distribution pipe.

LOCATION - Place the distribution box 340 feet from the front (215.16') lot line and 50 feet from the right (600') lot line as seen when facing the lot from Buckskin Lake Drive. Run trenches on contour toward the back lot line. First trench not to exceed 80 feet in length.

NOTE - No trench to exceed 100 feet in length. Provide 6" - 8" diameter cleanout and cap to grade or above on septic tank. OK/CW

PLANS APPROVED BY S. Abel DATE 3/16/87

COVER NO WORK UNTIL INSPECTED AND APPROVED.

BUILDING PERMIT SIGNED AND RETURNED

NEITHER THE HOWARD COUNTY COUNCIL NOR THE HEALTH DEPARTMENT IS RESPONSIBLE FOR THE SUCCESSFUL OPERATION OF ANY SYSTEM.

NOTE: CLEANOUT REQUIRED EVERY 70 FEET OF SEWER LINE AND/OR AT 90° SWEEPS IN LINES FROM HOUSE TO DRAIN FIELD.

1/23/03 B00140054 UG PROPANE TANK

NOTE: ALL PARTS OF SEPTIC SYSTEMS (I.E., TANK, DISTRIBUTION BOX, TRENCHES) TO BE 100 FEET FROM WELL (UNLESS OTHERWISE SPECIFICALLY AUTHORIZED)

NOTE: IF DEEP TRENCH(ES) ARE USED CALL FOR INSPECTION BEFORE AND AFTER PLACING GRAVEL IN TRENCH(ES).

NOTE: NO DRY WELL SHALL EXCEED 15 FOOT IN DIAMETER. NO ABSORPTION TRENCH TO EXCEED 100 FEET IN LENGTH.

NOTE: ALL PIPE FROM HOUSE TO SEPTIC TANK MUST BE CAST IRON OR SCHEDULE 40 PVC OR ABS.


PERMIT VOID AFTER TWO YEARS.

NOTE: INSTALL STAND PIPE ON SEPTIC TANK AND DRY WELL. STAND PIPES MUST BE 6 INCHES IN DIAMETER. CAST IRON, CONCRETE OR TERRA COTTA OR PVC OR ABS ACCEPTED. IF TOP OF SEPTIC TANK IS DEEPER THAN 3 FEET, MANHOLE TO GRADE REQUIRED.

NOTE: DISTRIBUTION BOXES MUST HAVE BAFFLES.

***INSTALLER IS RESPONSIBLE FOR OBTAINING FINAL APROVAL ON THIS PERMIT**

*CALL 461-9933 FOR INSPECTION OF SEPTIC SYSTEMS.

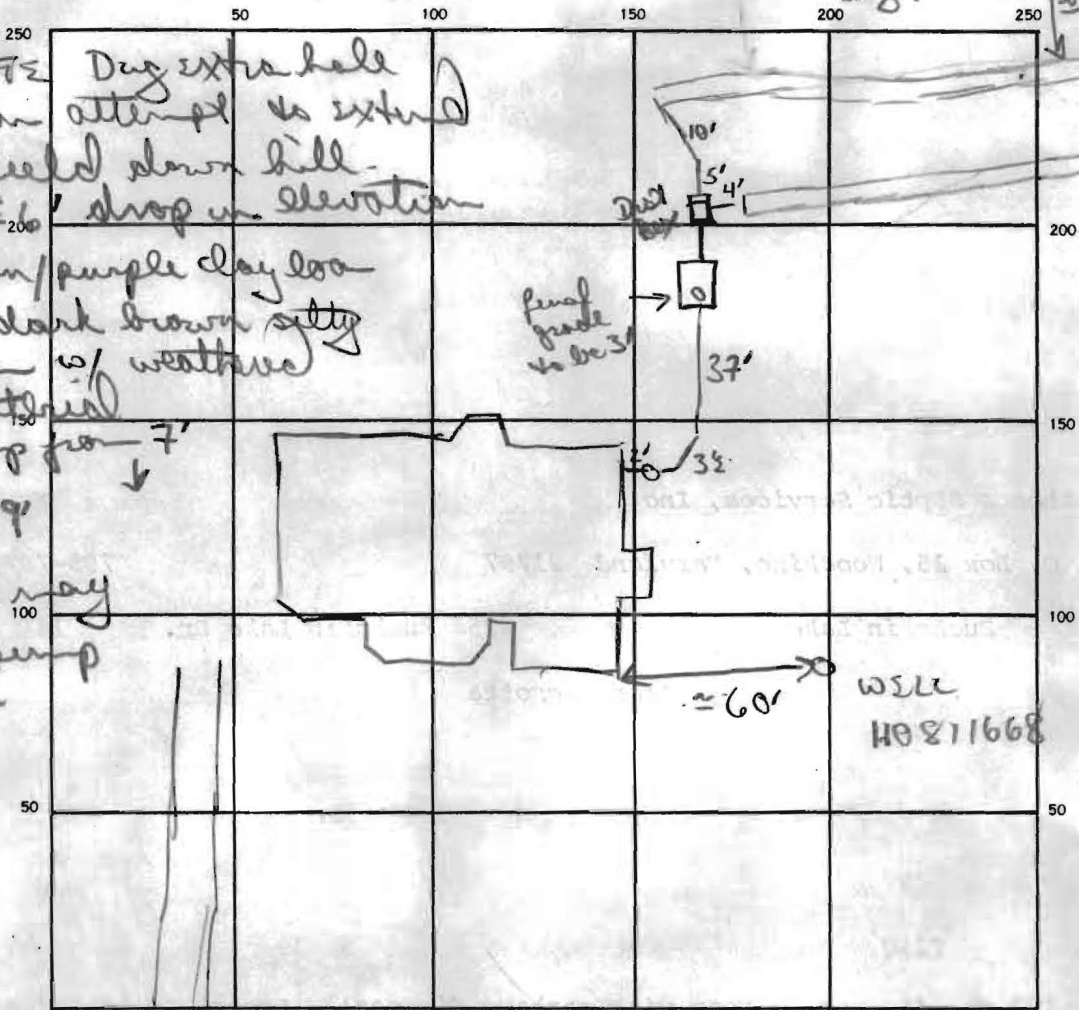

INDICATE NORTH — NAME ADJOINING ROADWAY AS BASE LINE

BUCKSKIN LAKE DRIVE

SEPTIC TANK. LEVEL 2000 gal CLEANOUTS 1 Down line 1 5 ft.

DISTRIBUTION BOX. LEVEL ✓

DRAIN FIELD/TILE FIELD. DEPTH 8 1/2 8 1/2 FT. TRENCH WIDTH 2+2 FT. INLET DEPTH 4 3 1/2 FT.

EFFECTIVE GRAVEL DEPTH 4 5 FT. TOTAL LENGTH 111 + 111 FT.

NUMBER OF TRENCHES 2 ONE SIDEWALL/BOTTOM AREA 444 555 SQ. FT.

DRYWELL INSIDE DIAMETER _____ FT. EFFECTIVE DEPTH BELOW INLET _____ FT.


ABSORBENT AREA =1000 SQ. FT.

REMARKS 3/26/87 part of perc field lost due to inaccurate topog + house location. Adjusted inlet on top to get contour OK to cover from house to tank OK to add stone pipe paper to both trenches, OK to continue covering.

3/26/87 All work finished + covered

D16524

NOTES: This plat is a preliminary plat and is not guaranteed by the State of Maryland. It is subject to the provisions of the Subdivision Control Act, Chapter 29, of the Code of Maryland Annotated, and to the provisions of the Subdivision Control Act, Chapter 29, of the Code of Maryland Annotated, and to the provisions of the Subdivision Control Act, Chapter 29, of the Code of Maryland Annotated.

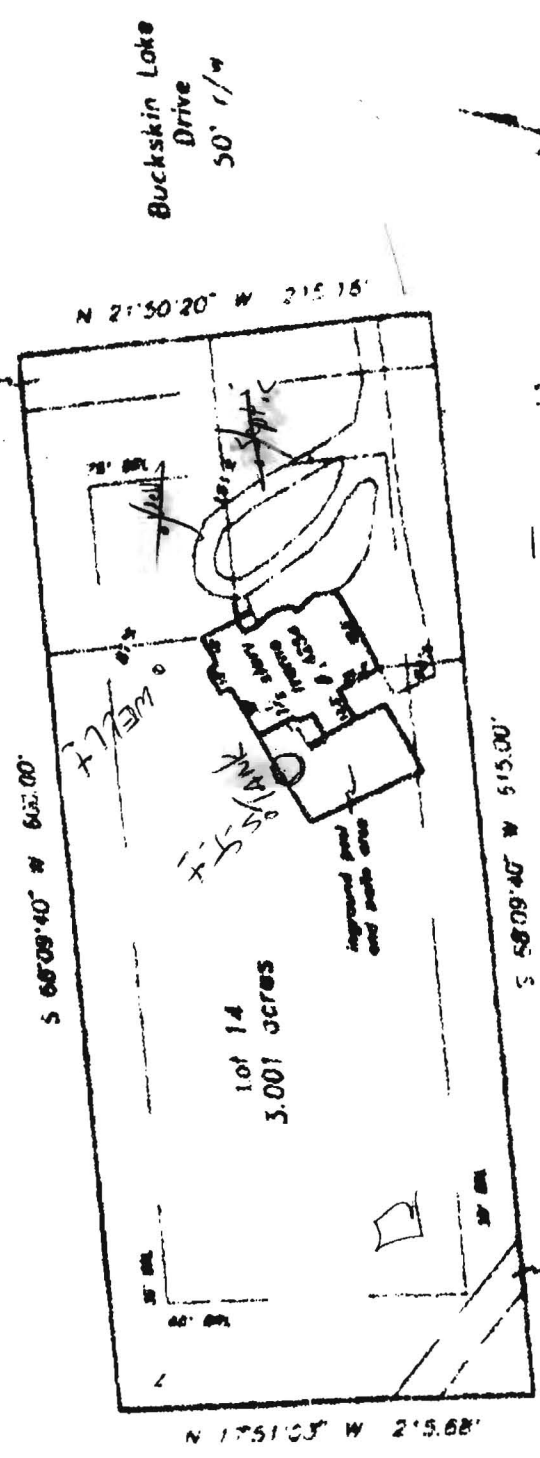

1-23-03
prop. tank
locat.
Okay
KN

Subject property is shown in Long C on the National Flood Insurance Program Flood Insurance Map No. 1704 of Howard County, Maryland, Panel 27 of 45 Community Panel # 2-0044-087; a Effective Date: November 5, 1986.

This is in certify that I have surveyed the property shown hereon, being shown as Lot 14 4254 Buckskin Lake Drive recorded in the Long Records of Howard County, Maryland in Plat Bk 8896 Liber Folio for the purpose of locating the improvements thereon

This plat is of benefit to the consumer only insofar as it is required by a lender or a title insurance company or its agent in connection with contemplated transfer, financing or refinancing purposes. This plat is not to be relied upon for the establishment of location of fences, garages, buildings or other existing or future structures. This plat does not provide for the accurate delineation of property boundary lines but such delineation may not be required for the purposes of this or for structures financing or refinancing.



LOCATION DRAWING
4254 Buckskin Lake Drive
Buckskin Woods
5th election district
HOWARD COUNTY, MARYLAND

Scale	1" = 100'
Date:	June 26, 1999
Field by	JLM
Drawn by	JLM
Checked by	JLM

NTT Associates, Inc.
16205 Old Frederick Road
Mt. Airy, Maryland 21771
Ph (410) 442-2031
Fax (410) 442-1315