

2/25/73 - 1st hole needed

Harry Beach

APPLICATION

A-03307

1/16/74
2 PM

SEWAGE DISPOSAL TESTING

P

MARYLAND STATE DEPARTMENT OF HEALTH

HOWARD COUNTY

ELLICOTT CITY

Single Bed Room 1000
1000 sq ft
1000 sq ft

DISTRICT

DATE 2/19/74

Drilled 10' deep, no bottom - 10' pipe of bottom. Could be
to no depth than 4' below surface. That depth 11 ft.

TO: THE COUNTY HEALTH OFFICER
ELLICOTT CITY, MARYLAND

I, HEREBY, APPLY FOR THE NECESSARY TESTS IN ORDER TO CONSTRUCT OR RECONSTRUCT A SEWAGE
DISPOSAL SYSTEM.

PROPERTY OWNER Durant Wood Development Co., Inc.

ADDRESS 212 Greenwood Road, E. Co., Md.

PHONE HO 5-1345

PROPERTY LOCATION:

SUBDIVISION: Durant Wood LOT NO. 11, Blk. B, Sec. 2

ROAD AND DESCRIPTION: Greenwood Road

OCCUPANT: owner - Harry J. Beach, Jr.

PERSON TO CONSTRUCT SYSTEM: Department of Health

ADDRESS: 9330 Edmonston Road

SIZE OF LOT: 155' x 285' x 125' TYPE BLDG: 1st flr, 1st floor

IF NOT SINGLE RESIDENCE DESCRIBE

SIGNATURE OF APPLICANT: John D. Winkler, Jr.


APPROVED BY: [Signature] FOR [Signature] DATE: 2/19/74

REJECTED BY: _____ FOR _____ DATE _____

HOLD PENDING FURTHER TESTS _____ DATE _____

REASONS FOR REJECTION OR HOLDING _____

THIS IS NOT A PERMIT

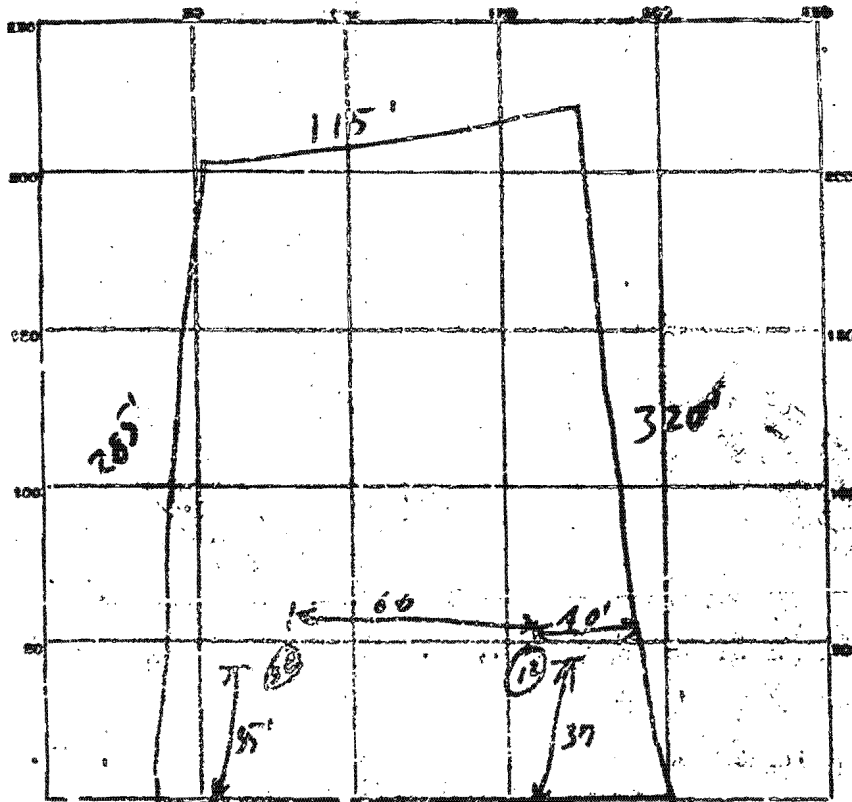

INDICATE NORTH - NAME ADJOINING ROADWAY AS BASE LINE.

Start 155

DATE	TEST NO.	DEPTH	P.P.E. WBY		TEST - 1" DROP		TIME
			START	STOP	START	STOP	
7/16/64	1	11 ft	1000	1002	1002	1016	4 min
	2	6 ft	1001	1002	1002	1006	5 min
	3	11 ft	1003	1004	1004	1010	6 min
	4	6 ft	1004	1006	1006	1010	4 min

SOIL AUGER FINDING

TESTED BY R.E.F. 7/16/64

REMARKS

ALSO PRESENT

LOT NO. 11 B - Sec. 2 - 3 part 1