

19/77

# PERMIT

P 25882  
A 18815

SEWAGE DISPOSAL SYSTEM

MARYLAND STATE DEPARTMENT OF HEALTH

HOWARD COUNTY

ELLICOTT CITY

DISTRICT 5th

DATE 5/17/77

INDEXED

Floyd Seiss

IS PERMITTED TO INSTALL ALTER

ADDRESS

PHONE

A SEWAGE DISPOSAL SYSTEM LOCATED AT

SUBDIVISION ROAD 12938 Brighton Dam Road LOT 1

PROPERTY OWNER Robert Glazier

ADDRESS 12412 Halls Shop Road, Fulton, Md. 210 20759 Phone: 506-5641

SPECIFICATIONS 3 bedrooms

DRAIN FIELD \_\_\_\_\_ DEPTH \_\_\_\_\_ FEET, BOTTOM AREA \_\_\_\_\_ SQ. FT.

SEEPAGE PITS \_\_\_\_\_ ABSORBENT SIDE-WALL AREA \_\_\_\_\_ SQ. FT.

SEPTIC TANK CAPACITY 1000 GALLONS

FOR GARBAGE GRINDER, INCREASE DISPOSAL AREA 22% & TANK CAPACITY 50%.

OTHER DRY WELL - To have 125 sq. ft. effective absorbent sidewall area per bedroom below inlet. Inlet to be 4 ft. below original grade and maximum depth 11 1/2 ft. below original grade. Locate of dry well 120 ft. from right side line and 150 ft. from back property line as seen when facing lot from Brighton Dam Road.

NOTE: IN NO CASE IS ANY DRY WELL TO EXCEED 15 FOOT IN DIAMETER.

NOTE: ALL PIPE FROM HOUSE TO DISPOSAL AREA MUST BE CAST IRON.

PERMIT VOID AFTER THREE YEARS.

NOTE: INSTALL STAND PIPE ON SEPTIC TANK AND DRY WELL. STAND PIPES MUST BE 6 INCHES IN DIAMETER. CAST IRON, CONCRETE OR TERRA COTTA ACCEPTED.

PLANS APPROVED BY Charles B. Streaker DATE 9/21/73


FILL SEPTIC TANK AND DISTRIBUTION BOX WITH WATER BEFORE CALLING FOR AN INSPECTION. COVER NO WORK UNTIL INSPECTED AND APPROVED.

NEITHER THE HOWARD COUNTY COMMISSIONERS NOR THE HEALTH DEPARTMENT IS RESPONSIBLE FOR THE SUCCESSFUL OPERATION OF ANY SYSTEM.

18815

INSPECTOR DATE SYSTEM APPROVED

14

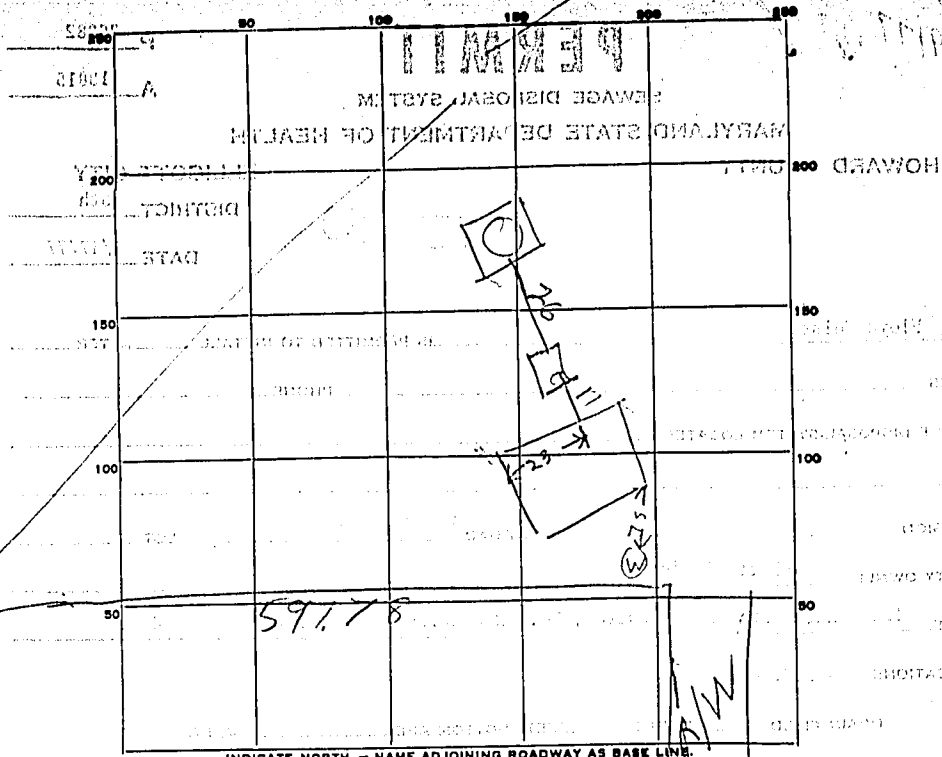

INDICATE NORTH - NAME ADJOINING ROADWAY AS BASE LINE

PERMIT CARD \_\_\_\_\_

SEPTIC TANK, LEVEL 1000 CLEANOUTS O/K

DISTRIBUTION BOX, LEVEL Top 2 ft below grade

TILE FIELD, DEPTH \_\_\_\_\_ FT. TRENCH WIDTH \_\_\_\_\_ FT.

GRAVEL DEPTH \_\_\_\_\_ IN. TOTAL LENGTH \_\_\_\_\_ FT.

NUMBER OF TRENCHES \_\_\_\_\_ TOTAL BOTTOM AREA \_\_\_\_\_

SEEPAGE PITS, INSIDE DIAMETER PERIMETER 56 FT. DEPTH BELOW INLET 7 1/2 FT.

ABSORBENT AREA 420 SQ. FT.

REMARKS 6/9/77 - DW inlet 3 ft below grade location  
of DW OK 3 BR 375 sq ft area used  
well location O/K

DATE SYSTEM APPROVED 6/9/77 INSPECTOR Raymond H. Hertz

