

APPLICATION

A 13389

P _____

SEWAGE DISPOSAL TESTING

MARYLAND STATE DEPARTMENT OF HEALTH

HOWARD COUNTY

ELLICOTT CITY

DISTRICT 3

DATE 12-8-67

TO: THE COUNTY HEALTH OFFICER
ELLICOTT CITY, MARYLAND

I, HEREBY, APPLY FOR THE NECESSARY TESTS IN ORDER TO CONSTRUCT (OR RECONSTRUCT) A SEWAGE DISPOSAL SYSTEM.

PROPERTY OWNER James W. King, Sr.

ADDRESS 304 Freetown Road, Simpsonville PHONE 286-2757

PROPERTY LOCATION:

SUBDIVISION Kingston LOT NO. 6 B sec

ROAD AND DESCRIPTION Triadelphia Road

Glenelg, Maryland

OCCUPANT _____ PHONE _____

PERSON TO CONSTRUCT SYSTEM _____

ADDRESS _____ PHONE _____

SIZE OF LOT 1 Acre (305' x 130') TYPE BLDG. 3

NUMBER OF BEARINGS

IF NOT SINGLE RESIDENCE DESCRIBE _____

SIGNATURE OF APPLICANT James W. King, Sr. /s/

APPROVED BY _____ FOR _____ DATE _____

(KIND OF SYSTEM)


REJECTED BY _____ FOR _____ DATE _____

(KIND OF SYSTEM)

HOLD PENDING FURTHER TESTS _____ DATE _____

REASONS FOR REJECTION OR HOLDING _____

THIS IS NOT A PERMIT

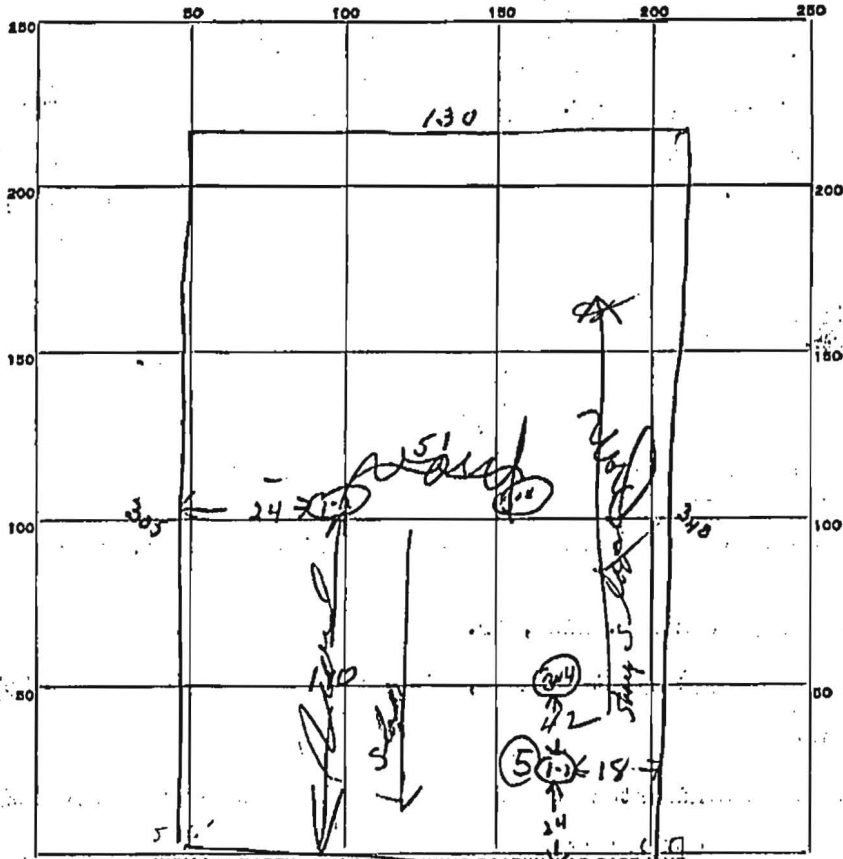

INDICATE NORTH. - NAME ADJOINING ROADWAY AS BASE LINE.
Road.

DATE	TEST NO.	DEPTH	PRE-WET		TEST - 1" DROP		TIME
			START	STOP	START	STOP	
4/4/8	1	4 1/2	3 58	4 16	4 16	4 45	29 min
	2	10 ft	3 58	4 00	4 16	4 02	3 min
	3	4 1/2	4 12	4 12	4 12	4 28	16 min
	4	9 ft	4 12	4 12	4 12	4 18	6 min
4/18/8	1	4 1/2	3 18	3 20	3 20	3 25	5 min Low
	2	10 ft	3 21	3 23	3 23	3 30	7 min 5 min low
	3	4 1/2	4 14	4 13	4 13	4 19	6 min High
	4	10 1/2	4 12	4 12	4 12	4 15	2 min
	5	13	TO SANDY				

SOIL AUGER FINDING

TESTED BY

REMARKS

DUM
 Pit for system (wide shallow Dry Well)
 Lot 6