

4/8/76 file
p.m. [unclear]

PERMIT

SEWAGE DISPOSAL SYSTEM

MARYLAND STATE DEPARTMENT OF HEALTH

HOWARD COUNTY

P 23263

A 23043

ELLICOTT CITY

DISTRICT 3

DATE 5/13/76

INDEXED

James Brittingham IS PERMITTED TO INSTALL ALTER

ADDRESS 3004 N. Rogers Avenue, Ellicott City, Md. PHONE 461-1870

A SEWAGE DISPOSAL SYSTEM LOCATED AT _____

SUBDIVISION Kingston ROAD Conchita Dr. LOT 7, Blk. B,

Sec. 2

PROPERTY OWNER Floyd Grayson

ADDRESS _____

SPECIFICATIONS - 3 bedrooms

DRAIN FIELD _____ DEPTH _____ FEET, BOTTOM AREA _____ SQ. FT.

SEEPAGE PITS _____ ABSORBENT SIDE-WALL AREA _____ SQ. FT.

SEPTIC TANK CAPACITY 1,000 GALLONS *1500*

FOR GARBAGE GRINDER, INCREASE DISPOSAL AREA 22% & TANK CAPACITY 50%.

OTHER Dry well - 400 sq. ft. sidewall area below top 3 1/2 ft. of clay. Dry well

inlet to be 2 1/2 ft. deep and bottom of dry well to be 12 1/2 ft. deep. Depths refer to grade at

time of perc test. To locate dry well site measure along the left side of the lot as seen when

facing the lot from Conchita Drive for a distance of 145 ft., then measure in from this

line 60 ft.

PERMIT VOID AFTER THREE YEARS.

NOTE: ALL PIPE FROM HOUSE TO DISPOSAL AREA MUST BE CAST IRON.

PLANS APPROVED BY Raymond Hodges DATE 4/5/76

FILL SEPTIC TANK AND DISTRIBUTION BOX WITH WATER BEFORE CALLING FOR AN INSPECTION. COVER NO WORK UNTIL INSPECTED AND APPROVED.


NOTE: INSTALL STAND PIPE ON SEPTIC TANK AND DRY WELL. STAND PIPE MUST BE 6" IN DIA.,

NEITHER THE HOWARD COUNTY COMMISSIONERS NOR THE HEALTH DEPARTMENT IS RESPONSIBLE FOR THE SUCCESSFUL OPERATION OF ANY SYSTEM.

CAST IRON, CONCRETE OR TERRA COTTA ACCEPTED.

BLDG. PERMIT SIGNED
AND RETURNED *4/24/76*
Serial # 10998
Quinn

23043

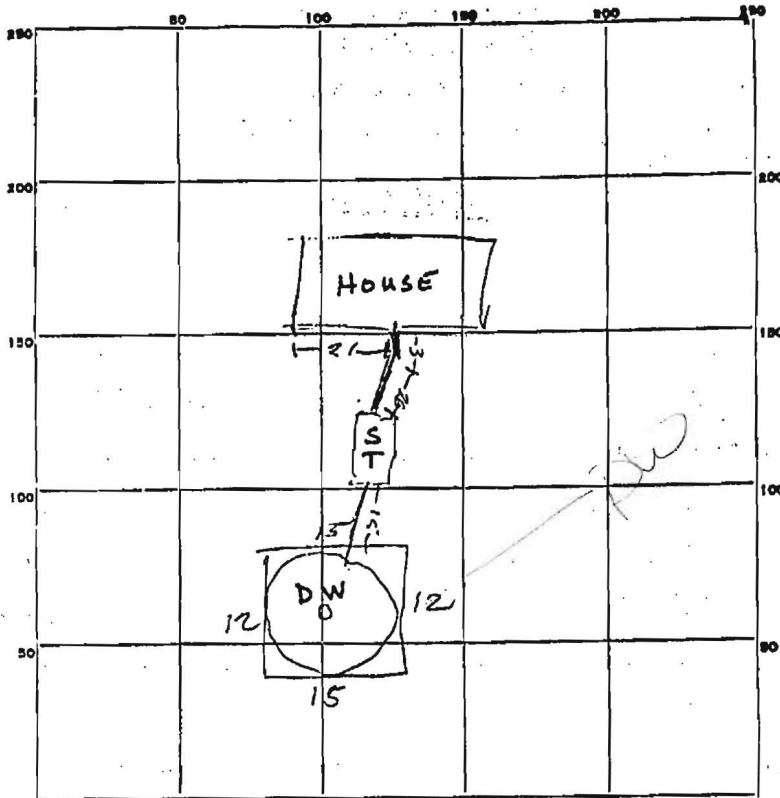

INDICATE NORTH. - NAME ADJOINING ROADWAY AS BASE LINE.

Conchitas DR

PERMIT CARD _____

SEPTIC TANK, LEVEL

CLEANOUTS

DISTRIBUTION BOX, LEVEL _____

~~INLET~~, DEPTH _____ FT. TRENCH WIDTH _____ FT.

GRAVEL DEPTH _____ IN. TOTAL LENGTH _____ FT.

NUMBER OF TRENCHES _____ TOTAL BOTTOM AREA _____

SEEPAGE PITS, INSIDE DIAMETER outside perimeter 54 FT. DEPTH BELOW INLET 8 FT.

ABSORBENT AREA 432 SQ. FT.

REMARKS 6/8/76 System OK to cover. Location as per specs. WWZ

DATE SYSTEM APPROVED 6/8/76

INSPECTOR R. B. Coop

