


APPLICATION

233

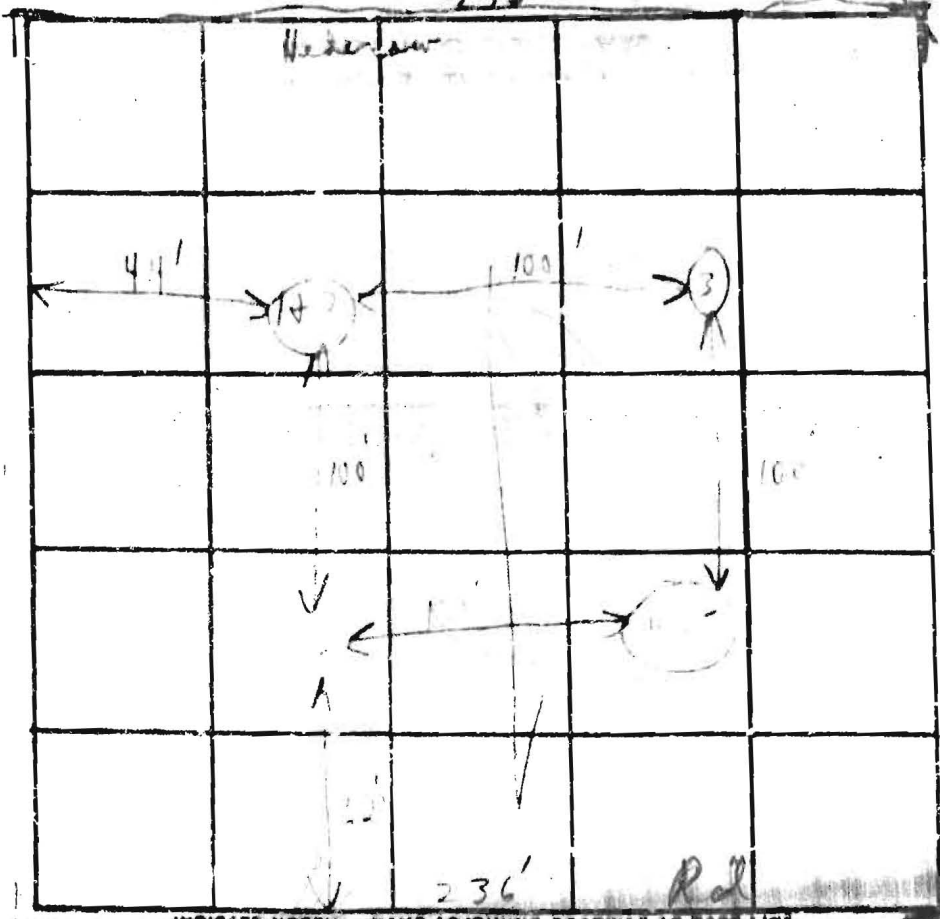


PA. 108

DATE	TEST NO.	DEPTH	PRE-WET		TEST - DROP		TIME
			START	STOP	START	STOP	
10/22	1	4 1/2'	10:00	10:02	10:02	10:05	3 m
	2	1 1/2'	9:58	10:01	10:01	10:05	2 m
	3	12 1/2'	Visual similar		Z 14		2
	4	5' 5"	10:10	10:13	10:13	10:17	4 m
		12:00	10:10	10:12	10:12	10:16	4 m
		12'	Visual similar		Z 4-5		12:52
						4 1/3	4 1/2

REMARKS _____

TYPE OF SOIL _____

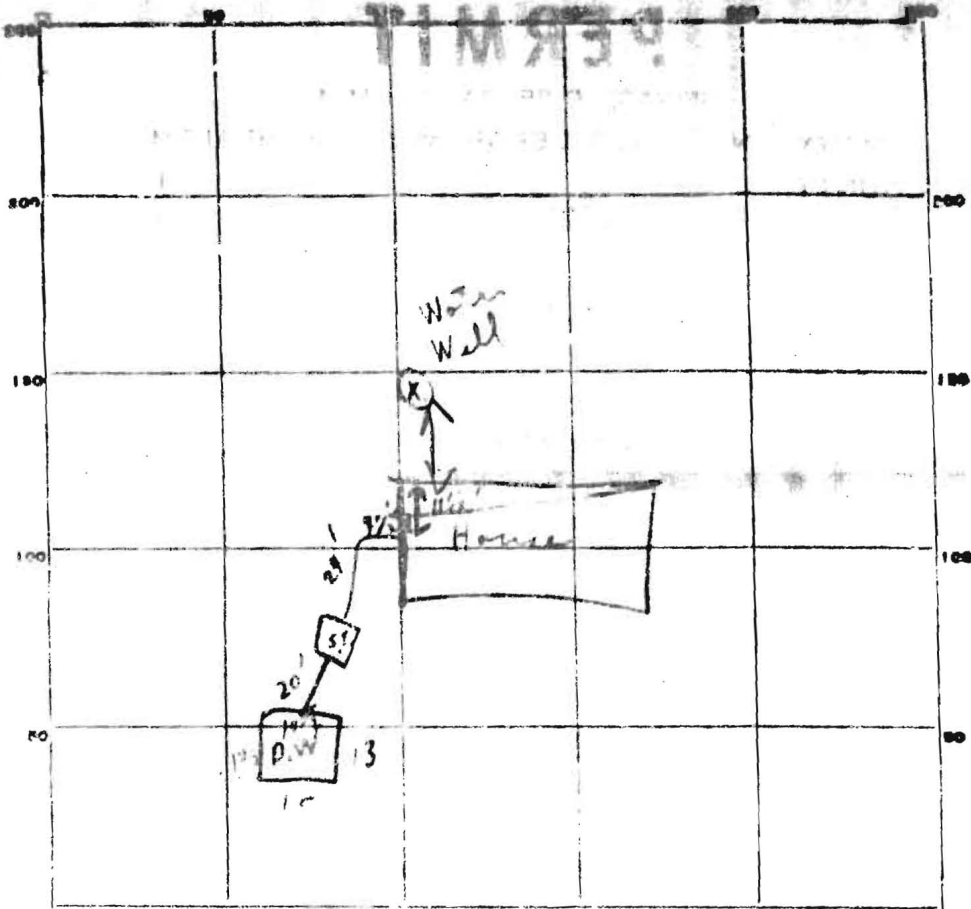

INDICATE NORTH - NAME ADJOINING ROADWAY AS BASE LINE.

RT 108

AND NOT seen D.W.
 INK, LEVEL OK CLEANOUTS OK / OK
 TION BOX, LEVEL _____
 2. DEPTH _____ FT. TRENCH WIDTH _____ FT.
 GRAVEL DEPTH _____ IN. TOTAL LENGTH _____ FT.
 NUMBER OF TRENCHES _____ TOTAL BOTTOM AREA _____
 SITS, INSIDE DIAMETER 57 = FT. DEPTH BELOW INLET 2' = FT.
 ABSORBENT AREA 456 = SQ. FT.

See Section 1011 on page 10 well on right location

APPROVED 4/22/17 INSPECTOR C. Shuck