

4/30/71  
by 10 if possible J.F.  
Affair of case in

Final OK  
5/5/71  
R.T.

Rel. Pat.

File

# INDEXED PERMIT

P 15919

A 15891

SEWAGE DISPOSAL SYSTEM

MARYLAND STATE DEPARTMENT OF HEALTH

HOWARD COUNTY

ELLICOTT CITY

DISTRICT 2

DATE 4/30/71

Hook's Plumbing & Heating IS PERMITTED TO INSTALL X ALTER  
ADDRESS 8332 Main St., Ellicott City, Md. PHONE 465-0975

A SEWAGE DISPOSAL SYSTEM LOCATED AT \_\_\_\_\_

SUBDIVISION \_\_\_\_\_ ROAD 3585 Church Rd. LOT \_\_\_\_\_

PROPERTY OWNER John Knight

ADDRESS \_\_\_\_\_

SPECIFICATIONS - 3 bedrooms

DRAIN FIELD \_\_\_\_\_ DEPTH \_\_\_\_\_ FEET. BOTTOM AREA \_\_\_\_\_ SQ. FT.

SEEPAGE PITS \_\_\_\_\_ ABSORBENT SIDE-WALL AREA \_\_\_\_\_ SQ. FT.

SEPTIC TANK CAPACITY 1,000 GALLONS

FOR GARBAGE GRINDER, INCREASE DISPOSAL AREA 22% & TANK CAPACITY 50%.

OTHER Deep trench - 60 ft. long, 12 ft. deep with 8 ft. of stone below pipe.

Locate trench 120 ft. in back of house. Dig trench with countour of ground. Call for inspection before and after gravel is installed. Call Health Dept., if confronted with problem while digging trench because of rock.


NOTE: ALL PIPE FROM HOUSE TO SEPTIC TANK MUST BE CAST IRON.  
PERMIT VOID AFTER THREE YEARS.

PLANS APPROVED BY Robertt V. Torre DATE 4/27/71

FILL SEPTIC TANK AND DISTRIBUTION BOX WITH WATER BEFORE CALLING FOR AN INSPECTION. COVER NO WORK UNTIL INSPECTED AND APPROVED.

NEITHER THE HOWARD COUNTY COMMISSIONERS NOR THE HEALTH DEPARTMENT IS RESPONSIBLE FOR THE SUCCESSFUL OPERATION OF ANY SYSTEM.

A 15891

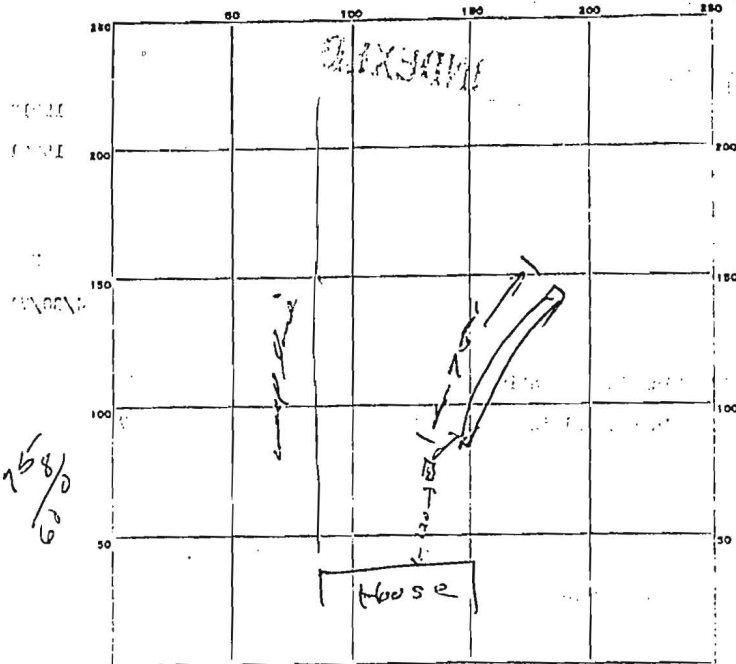

INDICATE NORTH - NAME ADJOINING ROADWAY AS BASE LINE.

PERMIT CARD \_\_\_\_\_ road

SEPTIC TANK, LEVEL 100 gal CLEANOUTS OK

DISTRIBUTION BOX, LEVEL \_\_\_\_\_

TRENCH, DEPTH 12 FT. TRENCH WIDTH 2 FT.

GRAVEL DEPTH 8 ft TOTAL LENGTH 75 FT.

NUMBER OF TRENCHES 1 TOTAL BOTTOM AREA 1200 sq. ft.

SEEPAGE PITS: INSIDE DIAMETER \_\_\_\_\_ FT. DEPTH BELOW INLET \_\_\_\_\_ FT.

ABSORBENT AREA \_\_\_\_\_ SQ. FT.

REMARKS

4-30-71 Partial ok. F.

4-30-71 Stone installed. S.T.

5-3-71 NOT COMPLETED R.T.

DATE SYSTEM APPROVED 5/5/71 INSPECTOR R. Tonne

## Fogle's Septic Clean Inc.

Fogle's Portable Toilets • Fogle's Well Drilling LLC • Fogle's Excavating, LLC



Howard County Health Department  
Bureau of Environmental Health  
Attn: Dana  
7178 Columbia Gateway Dr  
Columbia, Md 21046

February 20, 2009

To whom it may concern,

Fogle's Septic Clean Inc has pumped and abandoned the septic located at 3585 Church Rd, Ellicott City. If you have any questions or concerns please contact us at 410-795-5670.

Sincerely,

A handwritten signature in black ink, appearing to read "Dale H. Fogle", is written over the typed name.

Dale H. Fogle