

APPLICATION

SEWAGE DISPOSAL TESTING

A 15891

P _____

MARYLAND STATE DEPARTMENT OF HEALTH

HOWARD COUNTY Septic Tank - 1000 gal

ELLICOTT CITY

Deep Trench - 6.0 ft long 12 ft deep with 8 ft of stone below ~~at~~ pipes. Locate trench 120 ft. on back of house. Dig trench with contour of ground. Call for inspection before and after gravel is installed. Call Health Dept if confronted with problem while digging trench, presence of rock

DISTRICT 2

DATE 4/21/71

TO: THE COUNTY HEALTH OFFICER
ELLICOTT CITY, MARYLAND.

I, HEREBY, APPLY FOR THE NECESSARY TESTS IN ORDER TO CONSTRUCT (OR RECONSTRUCT) A SEWAGE DISPOSAL SYSTEM.

PROPERTY OWNER John Knight

ADDRESS _____ PHONE _____

PROPERTY LOCATION:

SUBDIVISION _____ LOT NO. _____

ROAD AND DESCRIPTION _____

1,200 ft. from public sewer

OCCUPANT _____ PHONE _____

PERSON TO CONSTRUCT SYSTEM _____

ADDRESS _____ PHONE _____

SIZE OF LOT approx. 5 acres TYPE BLDG. Existing house over 100 yrs.

NUMBER OF BEDROOMS _____

IF NOT SINGLE RESIDENCE DESCRIBE _____

SIGNATURE OF APPLICANT Howard J. Kaplan

APPROVED BY Robert V. Turner FOR Deep Trench DATE 4/27/71

(KIND OF SYSTEM)


REJECTED BY _____ FOR _____ DATE _____

(KIND OF SYSTEM)

HOLD PENDING FURTHER TESTS _____ DATE _____

REASONS FOR REJECTION OR HOLDING _____

THIS IS NOT A PERMIT

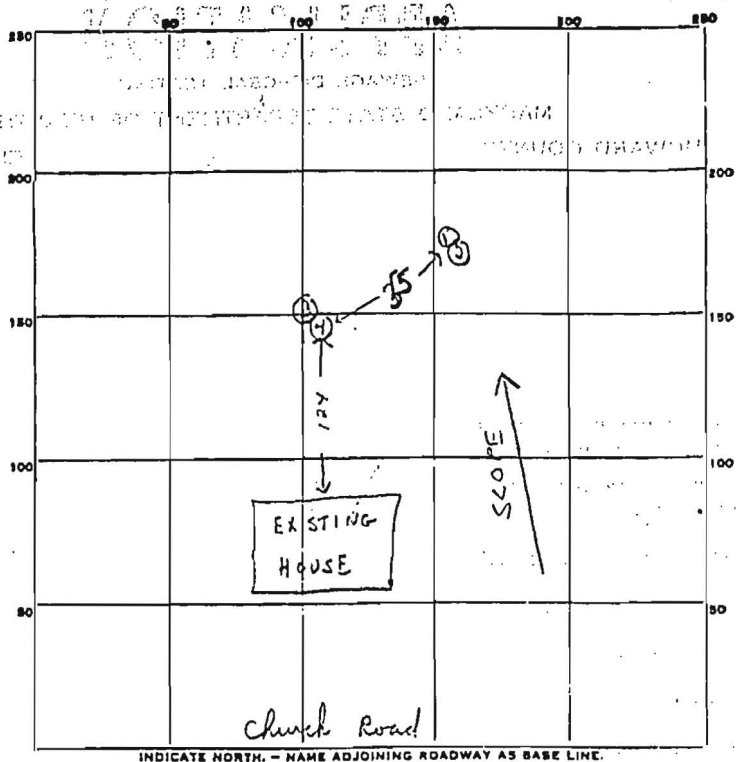

INDICATE NORTH. - NAME ADJOINING ROADWAY AS BASE LINE.

DATE	TEST NO.	DEPTH	PRE-WET		TEST - 1" DROP		TIME
			START	STOP	START	STOP	
4/27/71	1	4 1/2 ft.	1 30	1 37	1 39	1 52	13 min
	2	12 ft.	1 34	1 38	1 38	1 47	9 min
	3	4 ft.	1 53	2 15	20 min - 1/2 inch		
	4	12 ft.	1 59	2 02	2 02	2 06	4 min

SOIL AUGER FINDING _____
 TESTED BY R. Torre
 REMARKS _____