

MARYLAND DEPARTMENT OF THE ENVIRONMENT, WATER MANAGEMENT ADMINISTRATION  
2500 BROENING HIGHWAY, BALTIMORE, MARYLAND 21224, (410) 631-3784

\*\*\*\*\*  
WATER WELL ABANDONMENT-SEALING REPORT FORM  
\*\*\*\*\*

SUBMIT COPIES OF COMPLETED FORM TO:

- \* COUNTY ENVIRONMENT AGENCY (contact MDE, WMA if address needed)
- \* WELL OWNER
- \* MDE, WATER MANAGEMENT ADMINISTRATION, WELL PROGRAM

*Attn: Dana - original mailed 2/20/09*

DATE WELL ABANDONED: 2-20-09 (month/day/year)


- \* PERMIT NUMBER OF ABANDONED WELL (if any) \_\_\_\_\_
- \* PERMIT NUMBER OF REPLACEMENT WELL \_\_\_\_\_

\* PERSON ABANDONING WELL: Allen Compton

\* OWNER'S NAME: Thomas McKnight JR.

WELL DRILLERS LICENSE NUMBER: 009  
CIRCLE: MWD MSD MGD

\* WELL LOCATION:  
COUNTY: Howard  
NEAREST TOWN: Ellicott City  
TAX MAP 25 BLOCK 8 PARCEL 16  
SUBDIVISION: \_\_\_\_\_  
SECTION: \_\_\_\_\_ LOT: \_\_\_\_\_  
NEAREST ROAD: 3585 Church RD

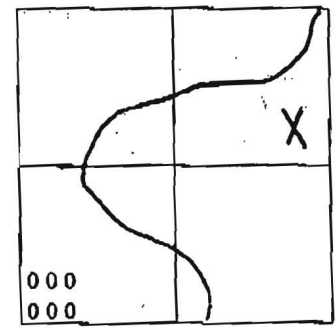

SHOW WELL LOCATION BY X WITHIN BOX

MARYLAND GRID COORDINATES  
E 850  
BOX NUMBER  
N 520

- \* TYPE OF WELL BEING ABANDONED:
- \_\_\_\_ DRILLED       JETTED  
 \_\_\_\_ BORED/AUGURED       HAND DUG  
 \_\_\_\_ OTHER (specify) \_\_\_\_\_

- \* USE CODE:
- DOMESTIC      \_\_\_\_ MUNICIPAL/PUBLIC  
 \_\_\_\_ IRRIGATION      \_\_\_\_ INDUSTRIAL  
 \_\_\_\_ TEST/OBSERVATION

- \* TYPE OF CASING: N/A
- \_\_\_\_ STEEL      \_\_\_\_ PLASTIC  
 \_\_\_\_ CONCRETE      \_\_\_\_ OTHER (specify) \_\_\_\_\_

\* SIZE OF CASING: N/A INCHES IN DIAMETER

\* DEPTH OF WELL: 10 FEET DEEP

\* WAS ANY CASING REMOVED? \_\_\_\_ YES  NO  
if yes, length removed, in feet: \_\_\_\_\_

\* WAS CASING RIPPED OR PERFORATED? \_\_\_\_ YES  NO

LOG OF SEALING MATERIAL

MATERIAL	FEET	
	FROM	TO
3 yards Concrete	0	10

Allen Compton  
SIGNATURE-MASTER WELL DRILLER OR SUPERVISING SANITARIAN

009 LICENSE #      MWD MSD MGD CIRCLE ONE      2/20/09 DATE