

3/13/73
as soon as possible
3/14/73
After 1 p.m.

C.O. OK
3/16/73

PERMIT

SEWAGE DISPOSAL SYSTEM

P 18068

A _____

MARYLAND STATE DEPARTMENT OF HEALTH

HOWARD COUNTY

ELLICOTT CITY

DISTRICT 2

DATE 3/12/73

INDEXED
File

Ernest Robinson IS PERMITTED TO INSTALL _____ ALTER

ADDRESS 8255 North Lark Brown Rd., Ellicott City, Md PHONE 465-7369

A SEWAGE DISPOSAL SYSTEM LOCATED AT _____

SUBDIVISION _____ ROAD 3574 Church Road LOT _____

PROPERTY OWNER George E. S. Bayless, Jr.

ADDRESS 3574 Church Road

SPECIFICATIONS

DRAIN FIELD _____ DEPTH _____ FEET. BOTTOM AREA _____ SQ. FT.

SEEPAGE PITS _____ ABSORBENT SIDE-WALL AREA _____ SQ. FT.

REPAIR SEPTIC TANK CAPACITY 1,500 GALLONS

FOR GARBAGE GRINDER, INCREASE DISPOSAL AREA 22% & TANK CAPACITY 50%.

OTHER REPAIR Dry well - 10 ft. in diam. by 11 ft. deep below inlet.

EXCAVATION TO BE INSPECTED.


PLANS APPROVED BY Palmer F. Wine DATE 3/12/73

FILL SEPTIC TANK AND DISTRIBUTION BOX WITH WATER BEFORE CALLING FOR AN INSPECTION. COVER NO WORK UNTIL INSPECTED AND APPROVED.

NEITHER THE HOWARD COUNTY COMMISSIONERS NOR THE HEALTH DEPARTMENT IS RESPONSIBLE FOR THE SUCCESSFUL OPERATION OF ANY SYSTEM.

BLDG. PERMIT SIGNED
AND RETURNED 7/28/94
Serial # 55376
Addition

P. 18068

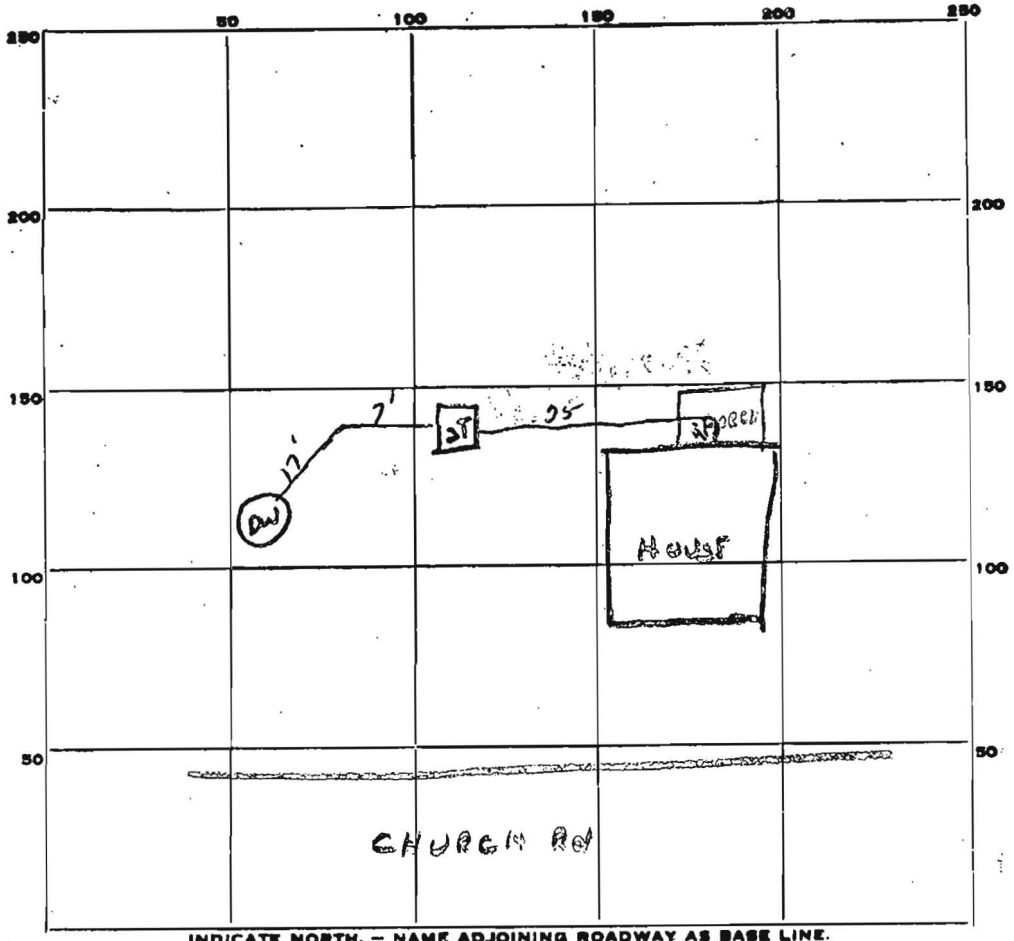

INDICATE NORTH. - NAME ADJOINING ROADWAY AS BASE LINE.

3/12/73
3/13/73
3/14/73

PERMIT CARD: Signed

SEPTIC TANK, LEVEL 150' gal. CLEANOUTS Talked with owner concerning cleanouts. Tank only few inches below ground. Wants concrete slab over tank.

DISTRIBUTION BOX, LEVEL -

TILE FIELD, DEPTH - FT. TRENCH WIDTH - FT.

GRAVEL DEPTH - IN. TOTAL LENGTH - FT.

NUMBER OF TRENCHES - TOTAL BOTTOM AREA -

SEEPAGE PITS, INSIDE DIAMETER 10 FT. DEPTH BELOW INLET 12 FT.

ABSORBENT AREA 360 SQ. FT.

14
-1172
3

REMARKS 3/14/73 - 14 runs of tile. NO PIPE INSTALLED

DATE SYSTEM APPROVED 3/16/73 INSPECTOR R. Tona