

LAYOUT 10/16/03 10⁰⁰ INSP 4 11/14/03 - 1:30
 INSP 2 10/12 3:30 F/U INSP 5 _____
 INSP 3 11/12/03 - 2 PM INSP 6 _____

ISSUE DATE: 10/8/03
 APPROVAL DATE: 11/1/03

PERMIT
INDEXED

P 519608
 A 513359-G

ON-SITE SEWAGE DISPOSAL SYSTEM
HOWARD COUNTY HEALTH DEPARTMENT
BUREAU OF ENVIRONMENTAL HEALTH
3525-H ELLICOTT MILLS DRIVE, ELLICOTT CITY, MD 21043

03-339661

Maticic Construction IS PERMITTED TO INSTALL ALTER
 ADDRESS: 5977 Sandy Ridge Rd PHONE NUMBER: 410-379-6463
 SUBDIVISION: Fox Chase Estate LOT NUMBER: 7
 ADDRESS: 13012 Cedarview Court PROPERTY OWNER: Williamsburg Group
 SEPTIC TANK CAPACITY (GALLONS): 1250 OUTLET BAFFLE FILTER REQUIRED
 PUMP CHAMBER CAPACITY (GALLONS): 1250 COMPARTMENTED TANK REQUIRED
 NUMBER OF BEDROOMS: 4
 SQUARE FEET PER BEDROOM: 180
 LINEAR FEET OF TRENCH REQUIRED: 240 HOUSE SERVED BY PUBLIC WATER

TRENCHES:	Trench to be 3.0 feet wide. Inlet 3.0 feet below original grade. Bottom maximum depth 5.0 feet below original grade. Effective area begins at 3.0 feet below original grade. 2.0 feet of stone below distribution pipe.
LOCATION:	Place distribution box 135' from the rear lot line and 10' from the right lot line. Run (3) trenches on contour to left side of lot as shown on plan. Trenches are best installed as shown (40', 100', 100').
NOTES:	


PLANS APPROVED: MER  DATE: 6/27/03

NOTES: PERMIT VOID AFTER 2 YEARS
 CONTRACTOR IS RESPONSIBLE FOR SCHEDULING A PRE-CONSTRUCTION INSPECTION FOR ALL INSTALLATIONS
 WATERTIGHT SEPTIC TANKS REQUIRED
 ALL PARTS OF SEPTIC SYSTEM SHALL BE 100 FEET FROM ANY WATER WELL UNLESS SPECIFICALLY AUTHORIZED
 MANHOLE RISERS REQUIRED ON ALL SEPTIC TANKS AND PUMP CHAMBERS UNLESS SPECIFICALLY AUTHORIZED
 CONTRACTOR RESPONSIBLE FOR COMPLIANCE WITH APPLICABLE REGULATIONS, GUIDELINES AND THE TERMS OF THIS PERMIT

NEITHER THE HOWARD COUNTY COUNCIL NOR THE HEALTH DEPARTMENT IS RESPONSIBLE FOR THE SUCCESSFUL OPERATION OF ANY SYSTEM PERMITTEE RESPONSIBLE FOR OBTAINING FINAL APPROVAL ON THIS PERMIT

BUILDING PERMIT SIGNED AND RETURNED
CALL 410-313-2640 FOR INSPECTION OF SEPTIC SYSTEM
DO NOT LEAVE ANY REQUEST FOR INSPECTION ON VOICEMAIL
25104 - BOV 147036 - 6A2680

4010 00 1-5

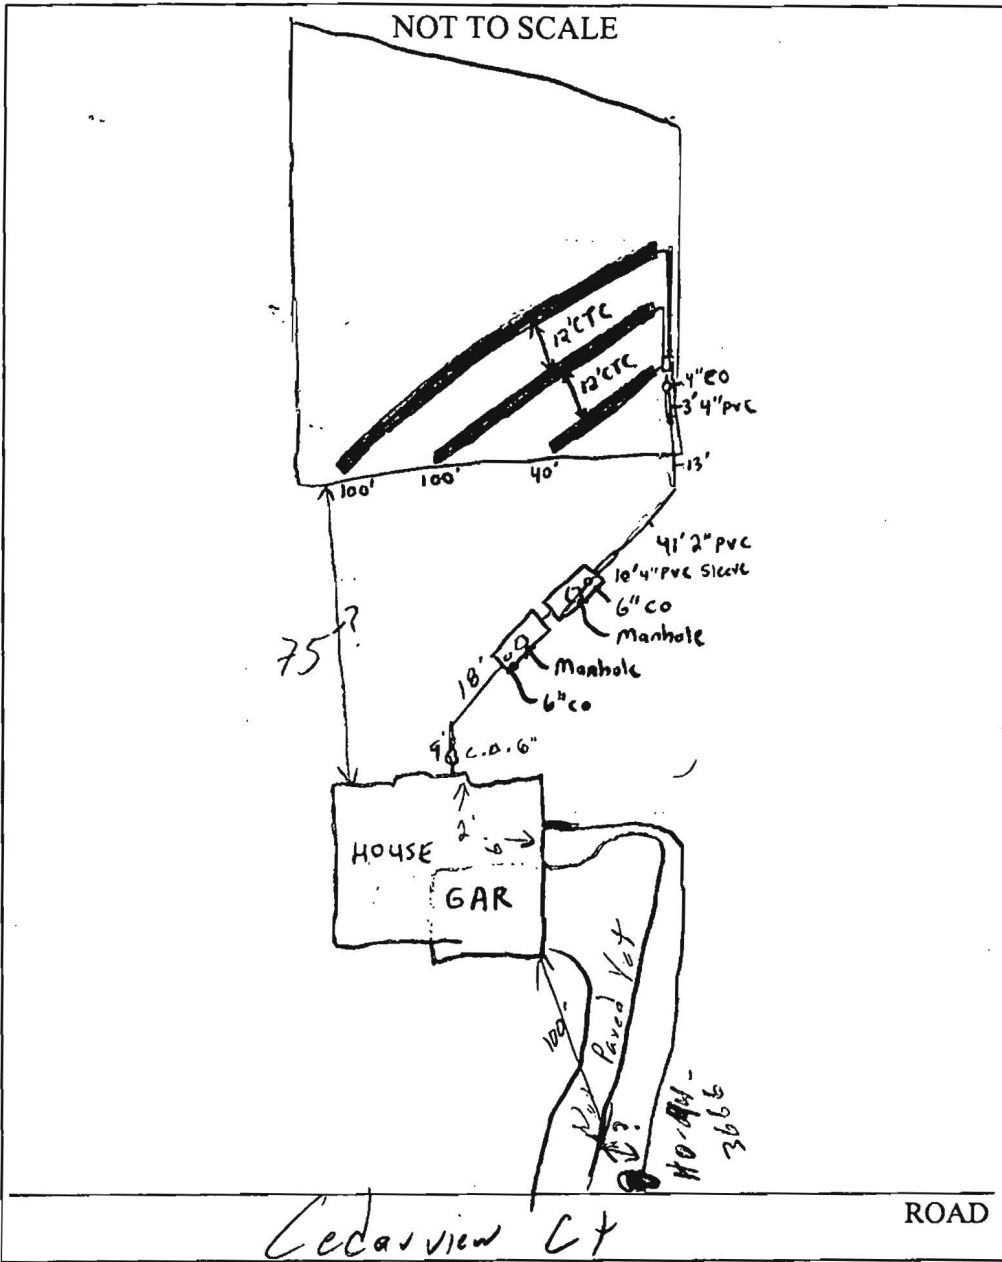

TRENCH/DRAINFIELD DATA		
WIDTH	INLET	BOTTOM
3'	3'	5'
NUMBER OF TRENCHES		3
TOTAL LENGTH		240'
ABSORPTION AREA		720 ft ²
DISTRIBUTION BOX LEVEL		✓
DISTRIBUTION BOX BAFFLE		✓
DISTRIBUTION BOX PORT		✓

SEPTIC TANK DATA	
SEPTIC TANK 1 LEVEL	✓
CAPACITY	1250 GAL
SEAM LOC	Top
TANK LID DEPTH	1.5-2'
BAFFLES	✓
BAFFLE FILTER	—
MANHOLE LOC	Center
6" PORT LOC	Front
WATERTIGHT TEST	—
SEPTIC TANK 2 LEVEL	✓
CAPACITY	1250 GAL
SEAM LOC	✓
TANK LID DEPTH	1.5-2'
BAFFLES	✓
BAFFLE FILTER	—
MANHOLE LOC	Center
6" PORT LOC	Back
WATERTIGHT TEST	—

PRE-CONSTRUCTION 10/16/03 - SRA staked, contours accurate, Install per B.P. (50)


INSTALLATION 10/22/03 - OK TO COVER ALL WORK, PUMP & ALARM TEST NEEDED - (50/KIR)

11/2/03 pump OK alarm test still needed (50/KIR)


11/14/03 - Alarm test OK (50)

BUILDING DEPARTMENT
CITY OF BOSTON

FINAL INSPECTOR John C. [Signature] DATE OF APPROVAL 11/14/03

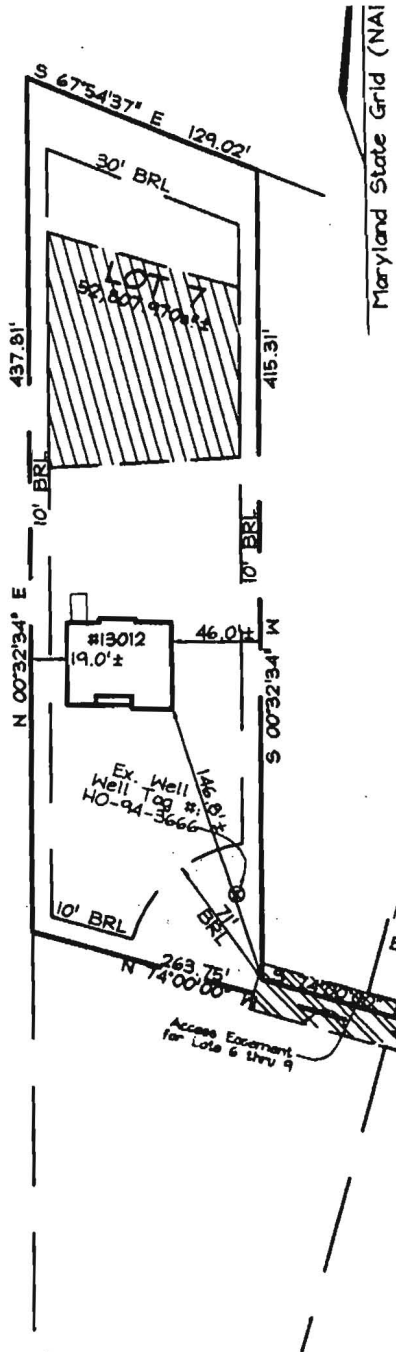


PLAN VIEW
SCALE: 1"=100'

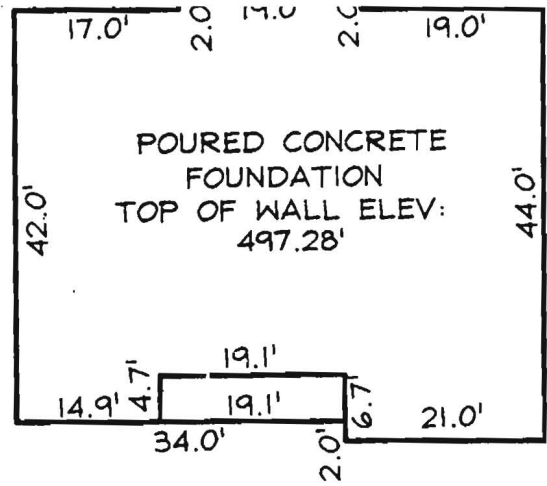

FOUNDATION DETAIL
SCALE: 1"=20'

7/31/03
Wallcheck
O.K.

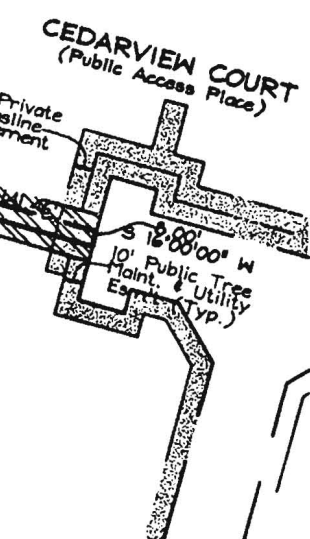

LEGEND

- | | |
|------------------|---------------------------|
| F/P = FIREPLACE | O/H = OVERHANG |
| B/W = BAY WINDOW | H/P = HEAT PUMP/AIR COND. |
| D/W = DRIVEWAY | G/M = GAS METER |
| CONC = CONCRETE | E/M = ELECTRIC METER |
- DIMENSIONS FROM FOUNDATION WALL TO PROPERTY LINE ARE ±0.1'

ADDRESS No.: 13012 CEDARVIEW COURT
TOP OF WALL ELEV. = 497.28' FIRST FLOOR ELEV. = N/A
THE LOCATION DRAWING IS OF BENEFIT TO THE CONSUMER ONLY
INSOFAR AS IT IS REQUIRED BY A LENDER OR A TITLE INSURANCE
COMPANY OR ITS AGENT IN CONNECTION WITH CONTEMPLATED
TRANSFER, FINANCING OR REFINANCING;


FSH Associates
Engineers Planners Surveyors
8318 Forrest Street Ellicott City, MD 21043
Tel: 410-750-2251 Fax: 410-750-7350
E-mail: FSHAssociates@cs.com

THE LOCATION DRAWING IS NOT TO BE RELIED UPON FOR THE ESTABLISHMENT OR LOCATION OF FENCES, GARAGES, BUILDINGS, OR OTHER EXISTING OR FUTURE IMPROVEMENTS;
AND THE LOCATION DRAWING DOES NOT PROVIDE FOR THE ACCURATE IDENTIFICATION OF PROPERTY BOUNDARY LINES, BUT SUCH IDENTIFICATION MAY NOT BE REQUIRED FOR THE TRANSFER OF TITLE OR SECURING FINANCING OR REFINANCING.

LOCATION
DRAWING



WALL CHECK

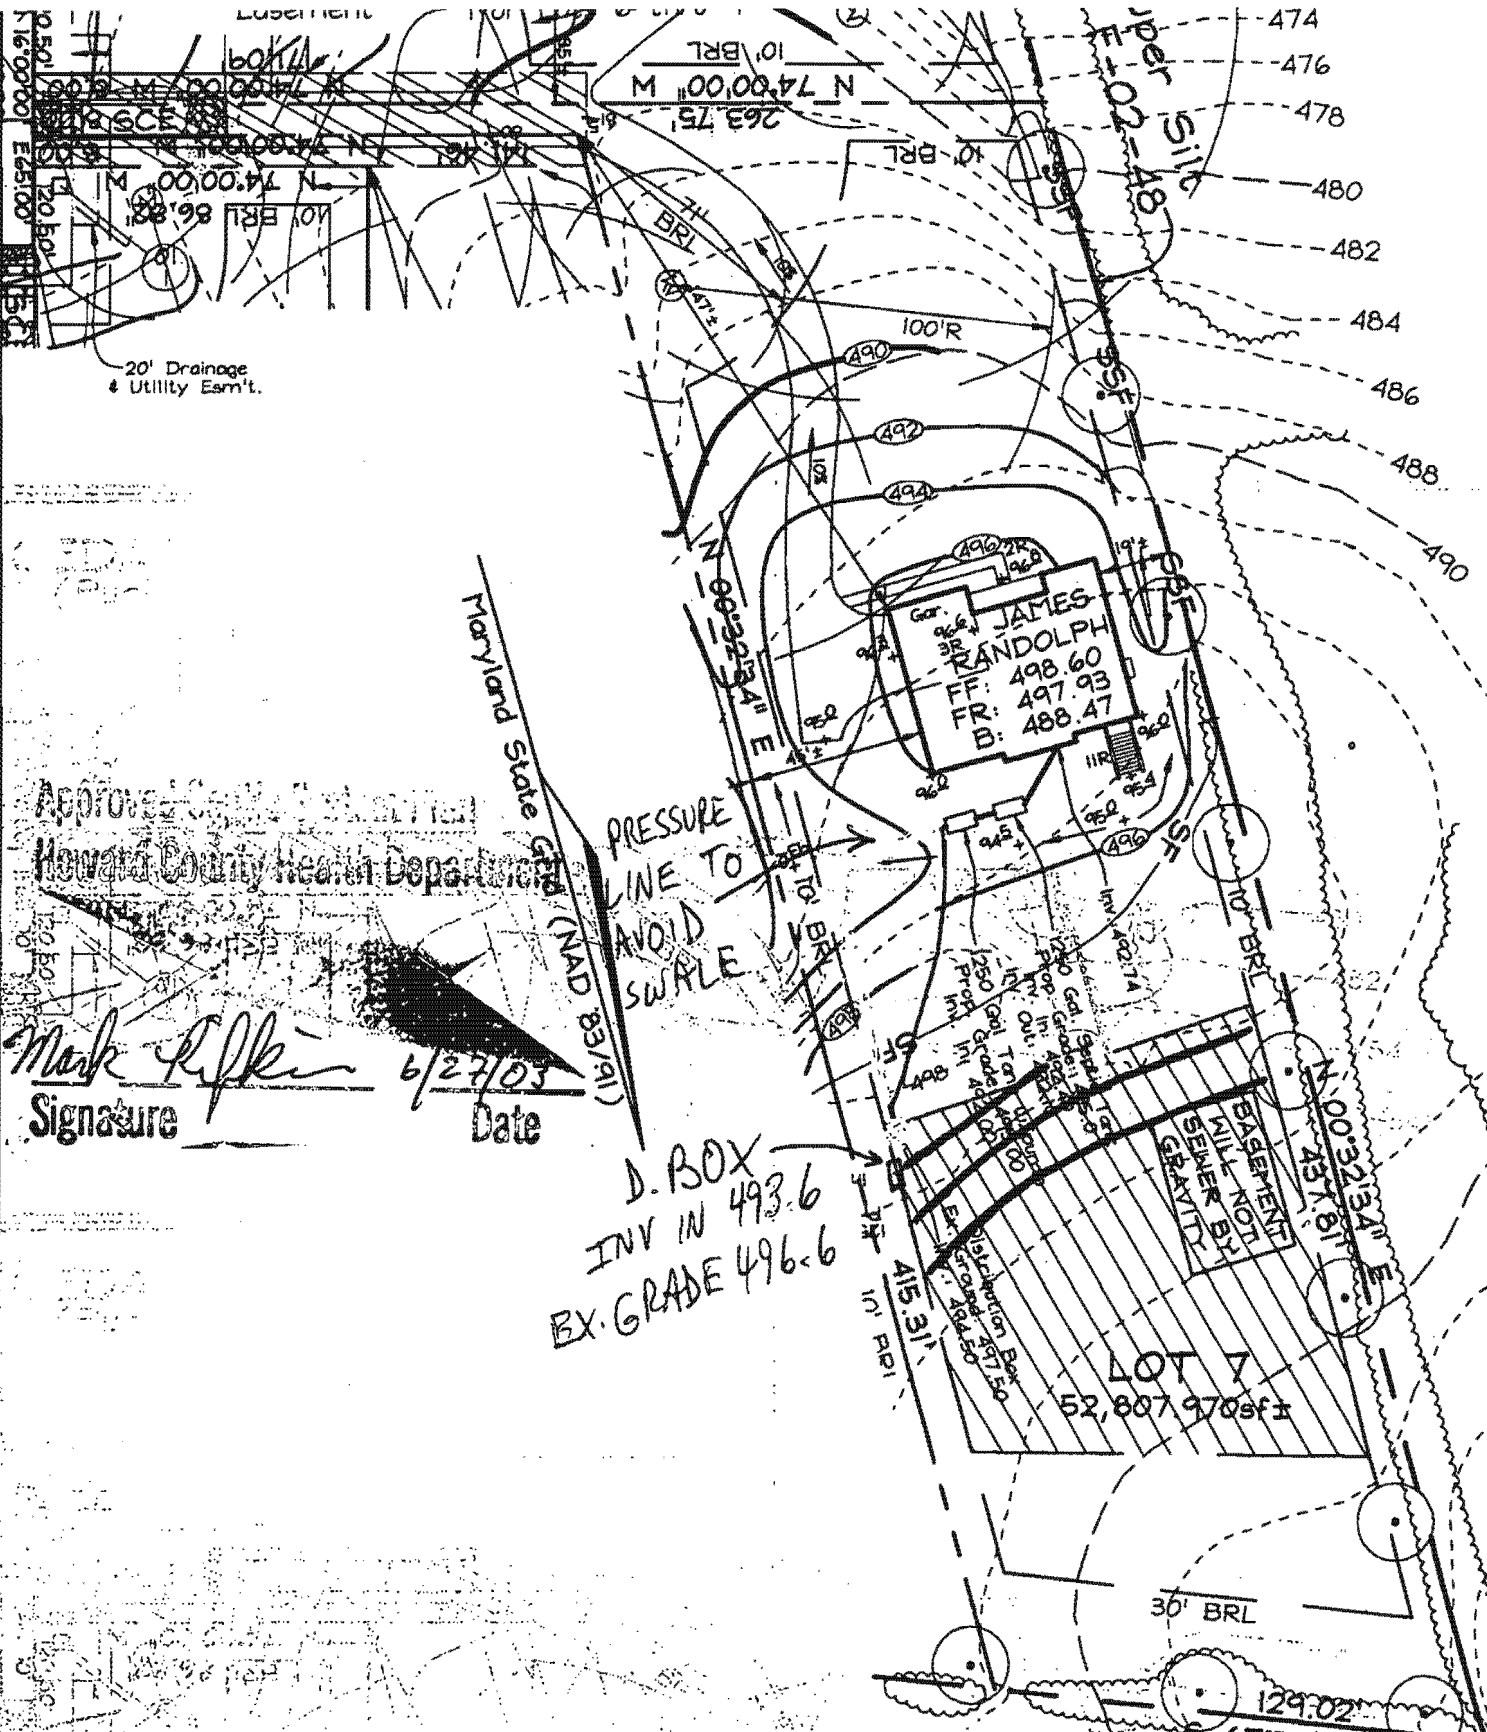

Approved by
 Howard County Health Department

Mark Riffin 6/27/03
 Signature Date

D. BOX
 INV IN 493.6
 EX. GRADE 496.6

FSH Associates

Engineers Planners Surveyors
 8318 Forrest Street Ellicott City, MD 21043
 Tel: 410-750-2251 Fax: 410-750-7350
 E-mail: FSHAssociates@cs.com

Note: See Approved Grading
 Plan GP-03-64 for Entire Site.


OWNER/DEVELOPER

Williamsburg Group L.L.C.
 P.O. Box 1018
 Columbia, Maryland 21044

DESIGN BY: Slim
 DRAWN BY: Slim

LOT RESITE
 LOT 7

CEDARVIEW COURT
(Public Access Place)

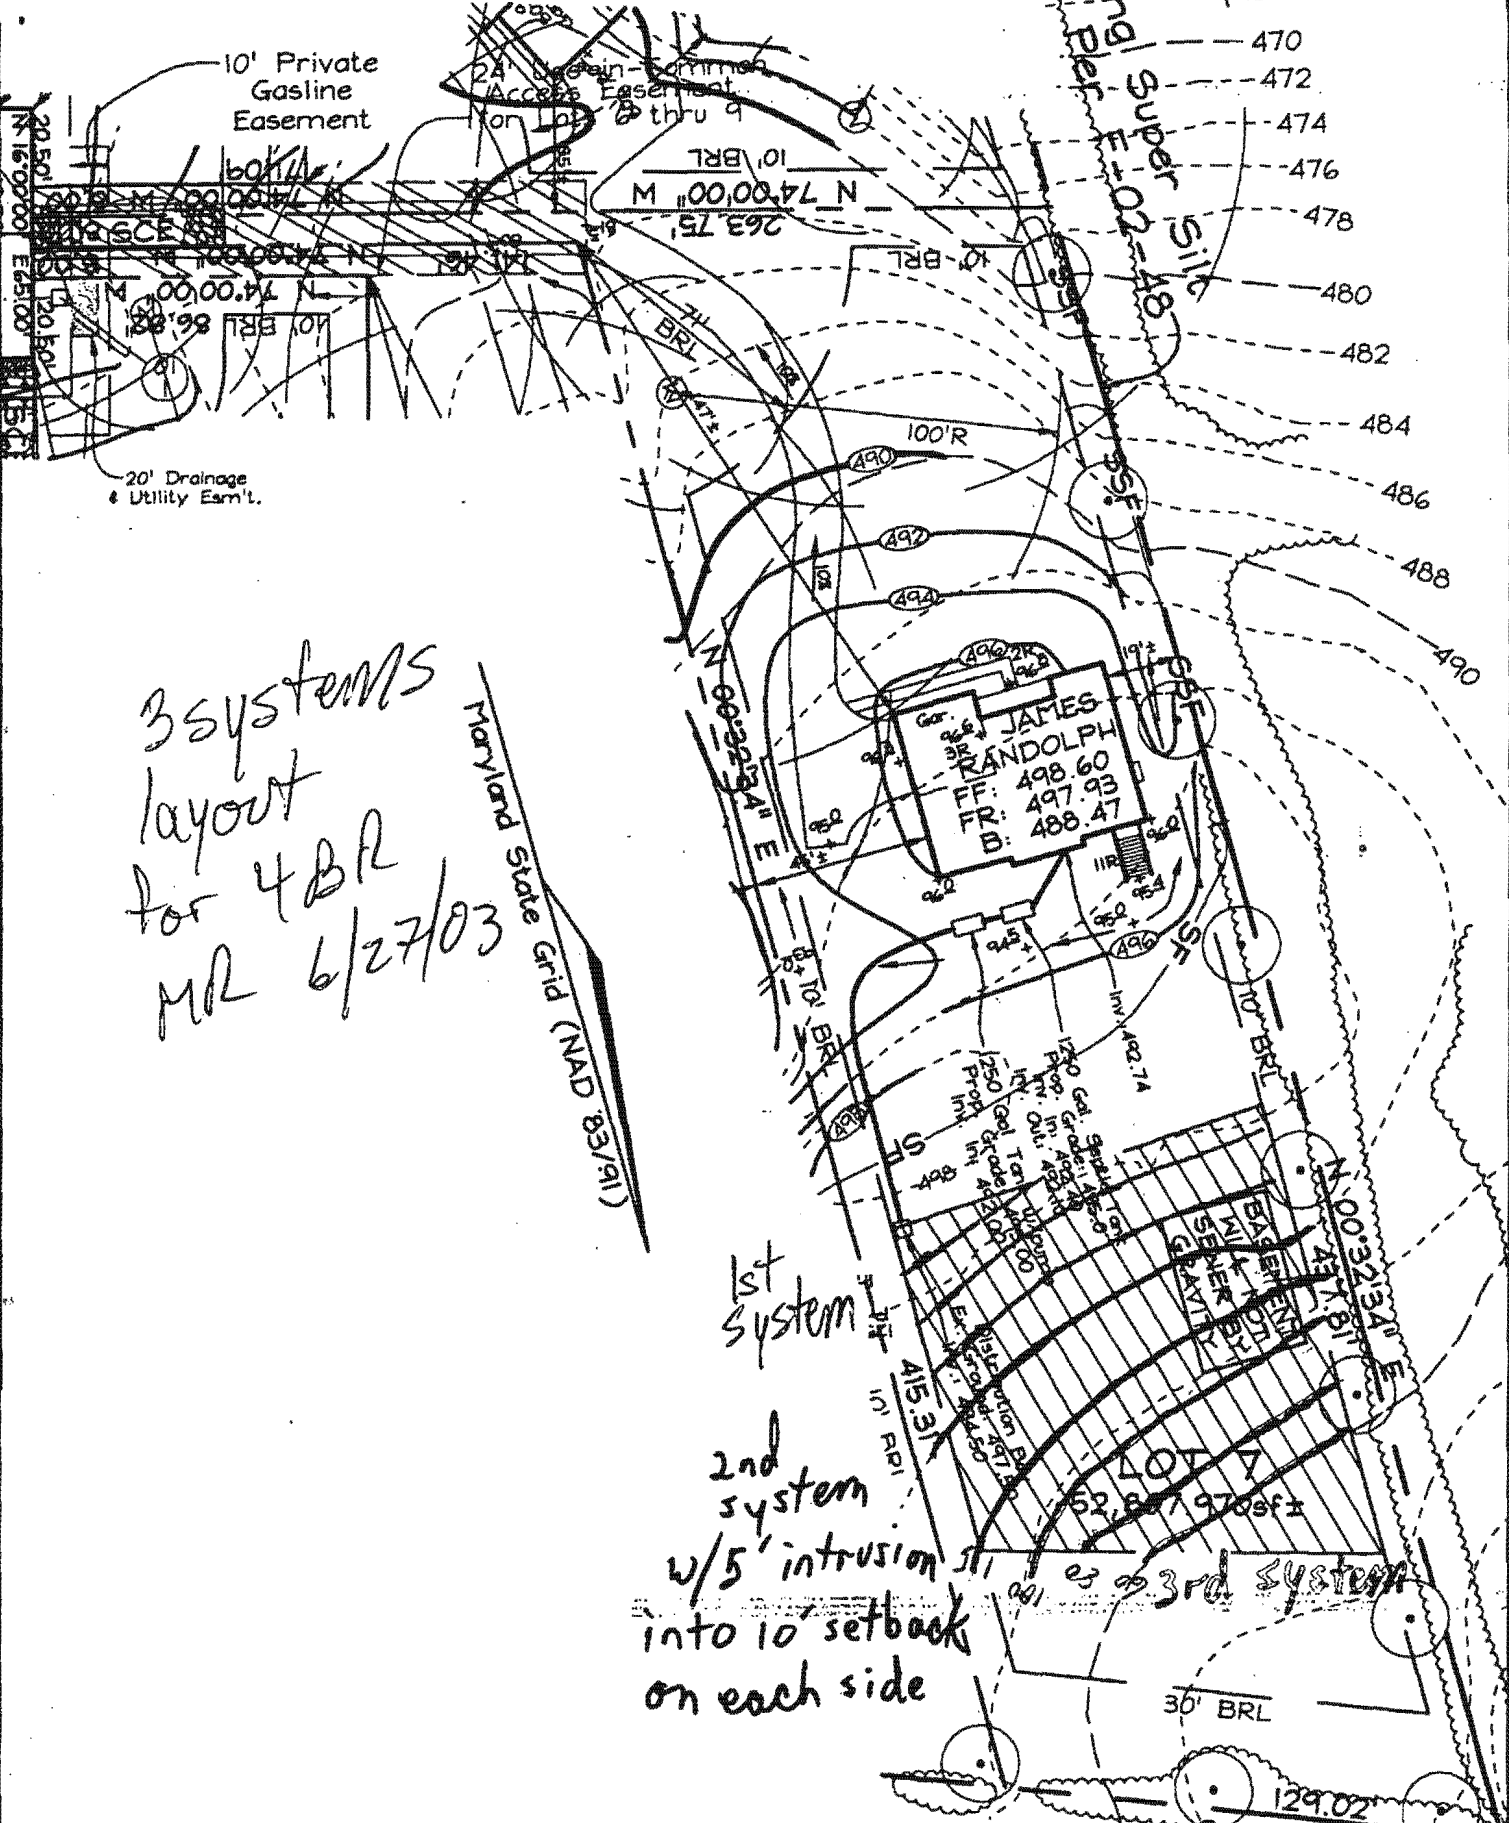

3 systems layout for 4 BR MR 6/27/03

Maryland State Grid (NAD 83/91)

1st system
2nd system w/ 5' intrusion st into 10' setback on each side
3rd system