

*Permit
10/29/67*

*116.3
-138
10/27/67
Ready*

*app. 88-77-67
ADP*

PERMIT

P 13176
A 09144

SEWAGE DISPOSAL SYSTEM

MARYLAND STATE DEPARTMENT OF HEALTH
HOWARD COUNTY

INDEXED

ELLICOTT CITY
DISTRICT 3

RECEIVED
HOWARD COUNTY
HEALTH DEPT.

DATE 10-19-67

Elwood Scaggs

Oct 20 8 54 AM '67

IS PERMITTED TO INSTALL ALTER

ADDRESS RFD Box 267D Laurel, Md. 20810
PHONE 725-0324

A SEWAGE DISPOSAL SYSTEM LOCATED AT _____

SUBDIVISION Burnt Wood ROAD Celbridge Dr. LOT 16, Blk. C, Sec 3

PROPERTY OWNER Joseph Collins

ADDRESS _____

SPECIFICATIONS 3-Bedrooms

DRAIN FIELD _____ DEPTH _____ FEET, BOTTOM AREA _____ SQ. FT.

SEEPAGE PITS _____ ABSORBENT SIDE-WALL AREA _____ SQ. FT.

SEPTIC TANK CAPACITY 750 GALLONS

FOR GARBAGE GRINDER, INCREASE DISPOSAL AREA 22% & TANK CAPACITY 50%.

OTHER Leaching Bed - 146 sq. ft. bottom area per bedroom, installed at a depth not exceeding 5 1/2 ft. below grade including gravel.
Place Leaching Bed - between 25 and 50 ft. from front lot line and between 40 and 100 ft. from right sidelines as seen when facing lot from Street C. (Celbridge Dr.)

PLANS APPROVED BY D. W. Monaghan DATE 1-28-60

FILL SEPTIC TANK AND DISTRIBUTION BOX WITH WATER BEFORE CALLING FOR AN INSPECTION. COVER NO WORK UNTIL INSPECTED AND APPROVED.

NEITHER THE HOWARD COUNTY COMMISSIONERS NOR THE HEALTH DEPARTMENT IS RESPONSIBLE FOR THE SUCCESSFUL OPERATION OF ANY SYSTEM.


NOTIFY THE HEALTH DEPARTMENT 48 HOURS BEFORE EXCAVATIONS ARE TO BE BACK FILLED.

09144



96
88
189

34
22
48
48
228

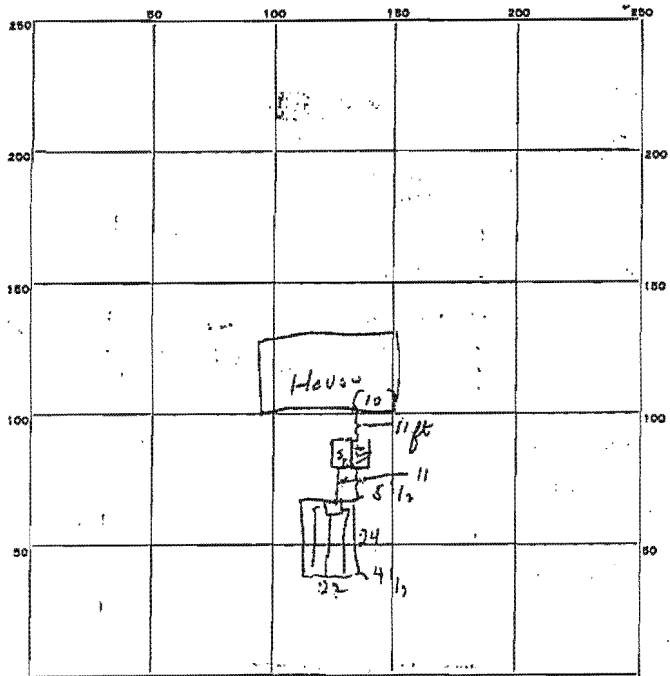

INDICATE NORTH. - NAME ADJOINING ROADWAY AS BASE LINE.

PERMIT CARD ok

SEPTIC TANK, LEVEL _____ CLEANOUTS 21

DISTRIBUTION BOX, LEVEL _____

TILE FIELD, DEPTH 4 1/2 to 5 1/2 FT. TRENCH WIDTH 22 FT.

GRAVEL DEPTH _____ IN. TOTAL LENGTH 24 FT.

NUMBER OF TRENCHES _____ TOTAL BOTTOM AREA 528

SEEPAGE PITS, INSIDE DIAMETER _____ FT. DEPTH BELOW INLET _____ FT.

ABSORBENT AREA _____ SQ. FT.

REMARKS _____

DATE SYSTEM APPROVED 10/27/67 INSPECTOR [Signature]