

11/1/66
Ready
11/2/66
Budgeted
noted down

app-11-2-66
P 12288
A 09024

PERMIT

SEWAGE DISPOSAL SYSTEM

MARYLAND STATE DEPARTMENT OF HEALTH

HOWARD COUNTY

ELLICOTT CITY

INDEXED

DISTRICT 3

DATE 10/21/66

Howard Pickett IS PERMITTED TO INSTALL ALTER

ADDRESS Watersville Rd., Mt. Airy, Md. PHONE 829-0543

A SEWAGE DISPOSAL SYSTEM LOCATED AT _____

SUBDIVISION Burnt Wood ROAD Celbridge Ct. & Celbridge Drive LOT 9, Blk. D, Sec. 3, Pt. 1

PROPERTY OWNER Burnt Woods Dev. Co.

ADDRESS _____

SPECIFICATIONS - 3 bedrooms

DRAIN FIELD _____ DEPTH _____ FEET, BOTTOM AREA _____ SQ. FT.

SEEPAGE PITS _____ ABSORBENT SIDE-WALL AREA _____ SQ. FT.

SEPTIC TANK CAPACITY 750 GALLONS

FOR GARBAGE GRINDER, INCREASE DISPOSAL AREA 22% & TANK CAPACITY 50%.

OTHER Dry well - 100 sq. ft. sidewall area below inlet pipe per bedroom - inlet pipe must be 4 ft. below original grade.

Place dry well about 100 ft. from radius pt. of street C and Court "D" and about 40 ft. from side parallel with Court "D".

MAXIMUM DEPTH PERMITTED 14' below original grade.

PLANS APPROVED BY D. W. Monaghan DATE 9/24/64

FILL SEPTIC TANK AND DISTRIBUTION BOX WITH WATER BEFORE CALLING FOR AN INSPECTION. COVER NO WORK UNTIL INSPECTED AND APPROVED.


NEITHER THE HOWARD COUNTY COMMISSIONERS NOR THE HEALTH DEPARTMENT IS RESPONSIBLE FOR THE SUCCESSFUL OPERATION OF ANY SYSTEM.

NOTIFY THE HEALTH DEPARTMENT 48 HOURS BEFORE EXCAVATIONS ARE TO BE BACK FILLED.

A 09024

24
12
43

Calbridge Drive

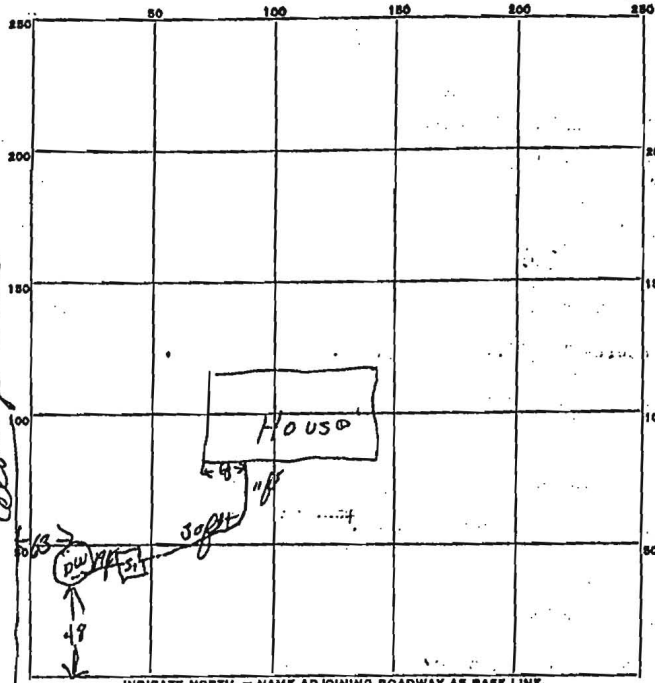

INDICATE NORTH. - NAME ADJOINING ROADWAY AS BASE LINE.

Calbridge Court

PERMIT CARD OK

SEPTIC TANK, LEVEL OK CLEANOUTS OK

DISTRIBUTION BOX, LEVEL

TILE FIELD, DEPTH FT. TRENCH WIDTH FT.

GRAVEL DEPTH IN. TOTAL LENGTH FT.

NUMBER OF TRENCHES TOTAL BOTTOM AREA

SEEPAGE PITS, INSIDE DIAMETER FT. DEPTH BELOW INLET FT.

ABSORBENT AREA SQ. FT.

REMARKS Permitting pay well is 43ft x 4ft x depth below inlet = 344 sq ft

System is wrong location - needs retreat down

11-2-66 - ground situated might be dry well or:

DATE SYSTEM APPROVED 11-2-66 INSPECTOR D.W. Money Co