

14831 Cemetery Road
Cockeville, MD 21723
May 27, 1998.

Avis L. Corbin, Chief
Licenses & Permits Division
Dept of Inspections, Licenses & Permits.

Dear Sir, We hereby submit an amended plan
for the plot plan no B00111900 at the
above named address.

The new amendment was recommended
by the Health Department.

Thanks for your cooperation.

cc: ~~Pls Review~~ Thanks.
~~Health Dept Subodunde Olorunferin~~
Ruth E. Olorunferin


6-3-98 PROPOSED AMENDMENT

ACCEPTED AS SHOWN ~~Ed Jones~~ H.C.H.D. 410-442-1973

A

Amended plot plan of 5/23/98
Showing location of proposed
additions.

PLOT PLAN, 14831 CEMETERY ROAD, COOKSVILLE, MD 21723.

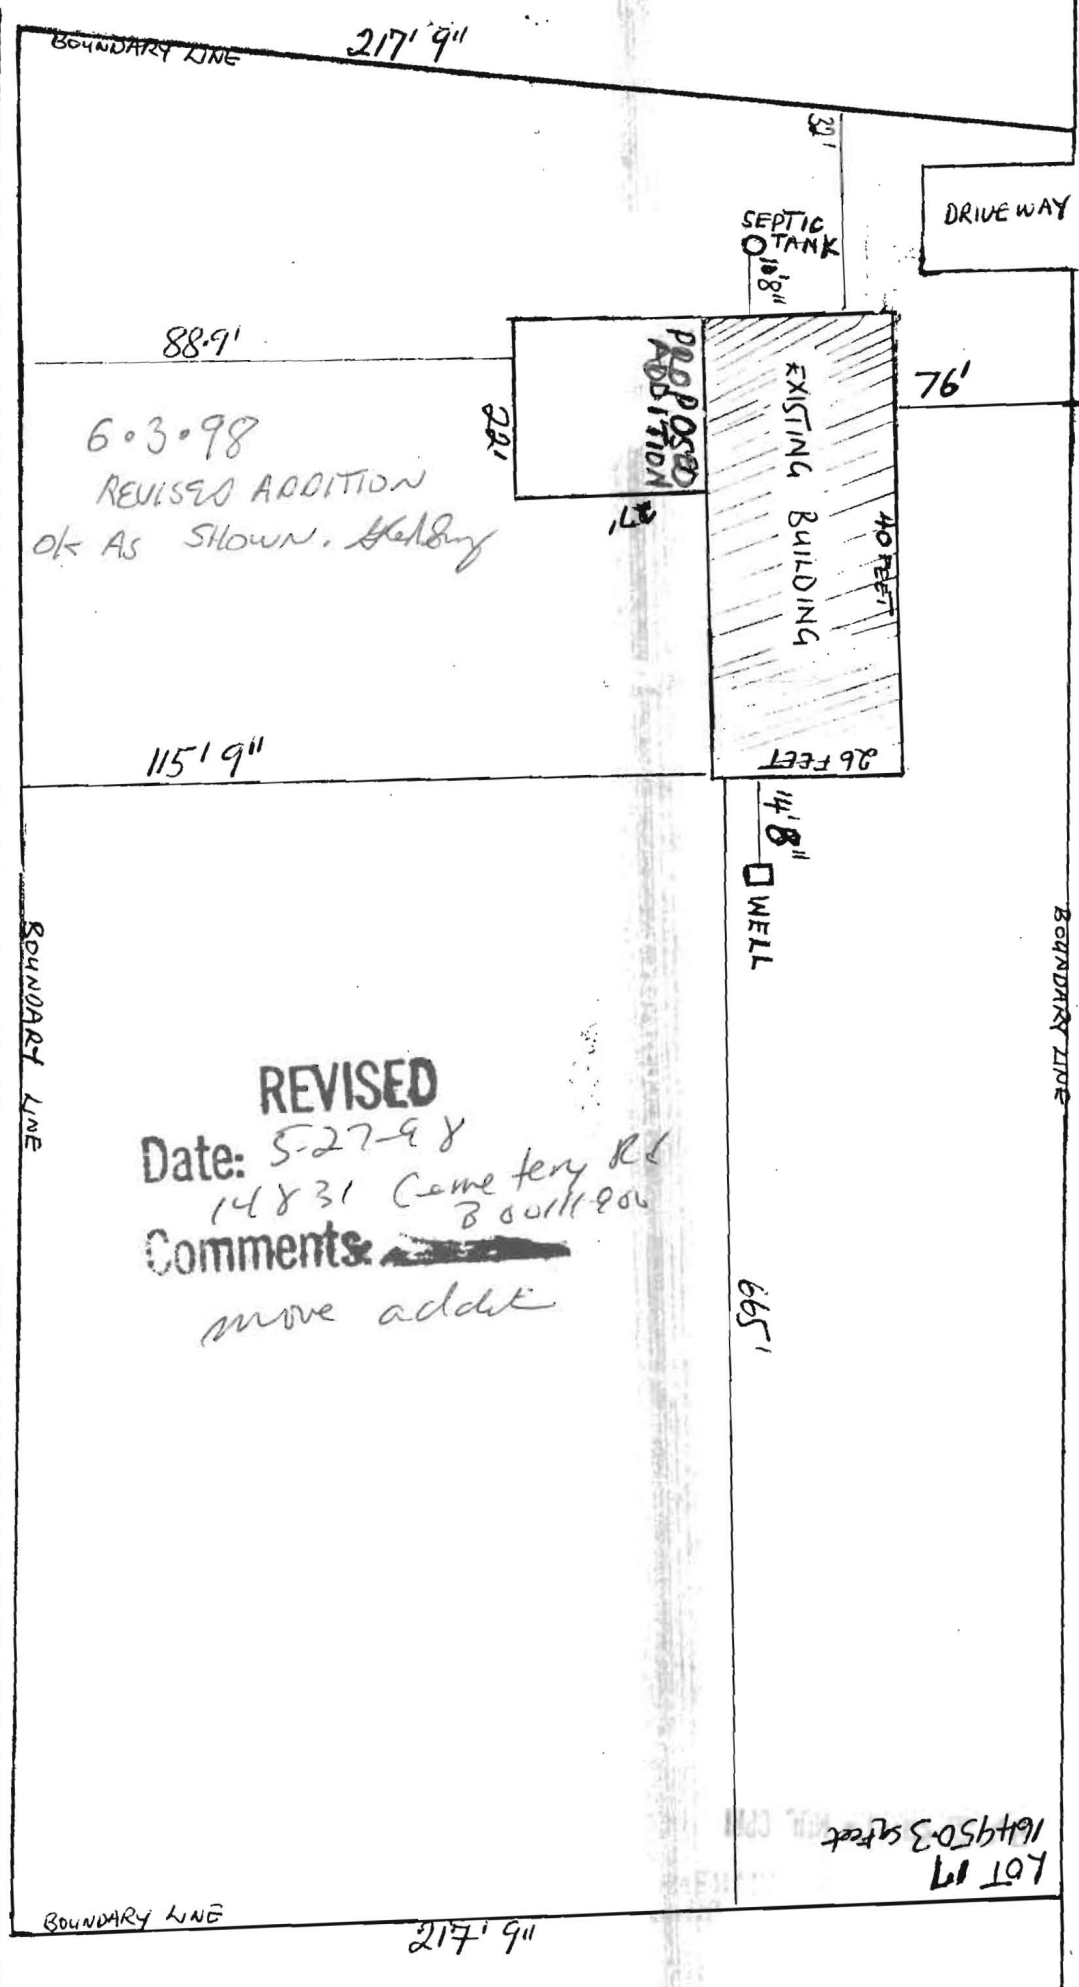

CEMETERY ROAD

MILLERS MILL ROAD