


Lot 9  
A 42737

SOIL PROFILE

0  
BROWN & GRAY clay  
4  
BROWN & GRAY SAND SILT MOTTLED LOAM  
11  
WATER  
11 1/2

MORGAN WOOD BUNGLE

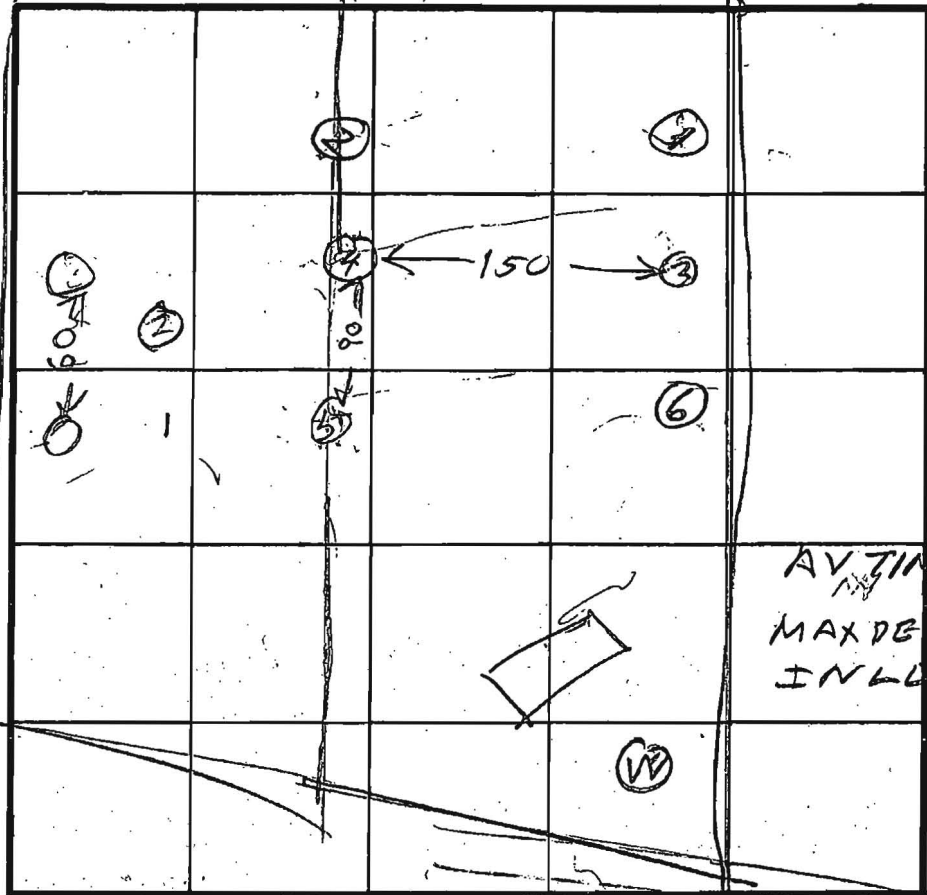

ON LINE  
5

0 BROWN CLAY  
3 YELLOW BROWN SAND SILT LOAM  
12

AV TIME 17 MIN  
MAX DEPTH INLET 3 FT

INDICATE NORTH - NAME ADJOINING ROADWAY AS BASE LINE.

B/W TO COUN

ON LINE  
2

0 BROWN CLAY  
3 BROWN GRAY SAND SILT MOTTLED LOAM  
9 1/2 WATER

(3)

0 CLAY TER SOIL  
3 BROWN SAND SILT LOAM LUMPY

ON LINE  
(4)

0 BROWN CLAY  
4 BROWN SILT SAND LUMPY LOAM  
12

DATE	TEST NO	DEPTH	PRE WET		TEST - 1" DROP		TIME
			START	STOP	START	STOP	
12/13/88	1S	4.5	246	252	LITTLE WATER		
	1V	11.5	WATER	17 F	7	UNSAT	
	2V	11	WATER	9 1/2	F 7	UNSAT	
	3S	4	358	408	408	417	9
12/14/88	4S	4.5	1031	1040	1040	1052	18
	4V	8.5	1031	1035	1035	1050	23
	4N	12	OK				
	5V	12	OK				
	6V	12	OK				

ON LINE LOT 9810

ON LINE LOT 9810  
ON LINE LOT 9810

REMARKS: Recommend Visual / hole in wet season  
Hole #1 - 12" flat digger survey of plot  
Other holes digger Red Marked area on plot  
TESTED BY: R. HODGIES  
REAL ESTATE BROKER: O. KETTERMAN  
ALSO PRESENT: SONNY CASTLE