

11/22/75

# PERMIT

*file ok HV 11-20-75*  
*complete* P-22526

SEWAGE DISPOSAL SYSTEM

MARYLAND STATE DEPARTMENT OF HEALTH

HOWARD COUNTY

ELLCOTT CITY

## INDEXED

DISTRICT 1

DATE 10/18/75

Jack Frock IS PERMITTED TO INSTALL ALTER 2  
ADDRESS TWO OAK ROAD, BRYCON, MD. PHONE 286-2520

A SEWAGE DISPOSAL SYSTEM LOCATED AT \_\_\_\_\_

SUBDIVISION WOODMOUNT ROAD 7311 CHATEAU TERR DRIVE LOT 8

PROPERTY OWNER None

ADDRESS \_\_\_\_\_

### SPECIFICATIONS

DRAIN FIELD \_\_\_\_\_ DEPTH \_\_\_\_\_ FEET. BOTTOM AREA \_\_\_\_\_ SQ. FT.

SEWAGE PITS \_\_\_\_\_ ABSORBENT SIDE WALL AREA \_\_\_\_\_ SQ. FT.

SEPTIC TANK CAPACITY \_\_\_\_\_ GALLONS

FOR GARAGE BRICKS, INCREASE DISPOSAL AREA SEE & TANK CAPACITY SEE \_\_\_\_\_


OTHER SEWER - Call for inspection when opened up on replacement and install

PLANS APPROVED BY FALST P. HIGG DATE 10/18/75

FILL SEPTIC TANK AND DISTRIBUTION BOX WITH WATER BEFORE CALLING FOR AN INSPECTION. SEWER NO WORK UNTIL INSPECTED AND APPROVED.

NEITHER THE HOWARD COUNTY COMMISSIONERS NOR THE HEALTH DEPARTMENT IS RESPONSIBLE FOR THE SUCCESSFUL OPERATION OF ANY SYSTEM.

*Handwritten signature/initials*

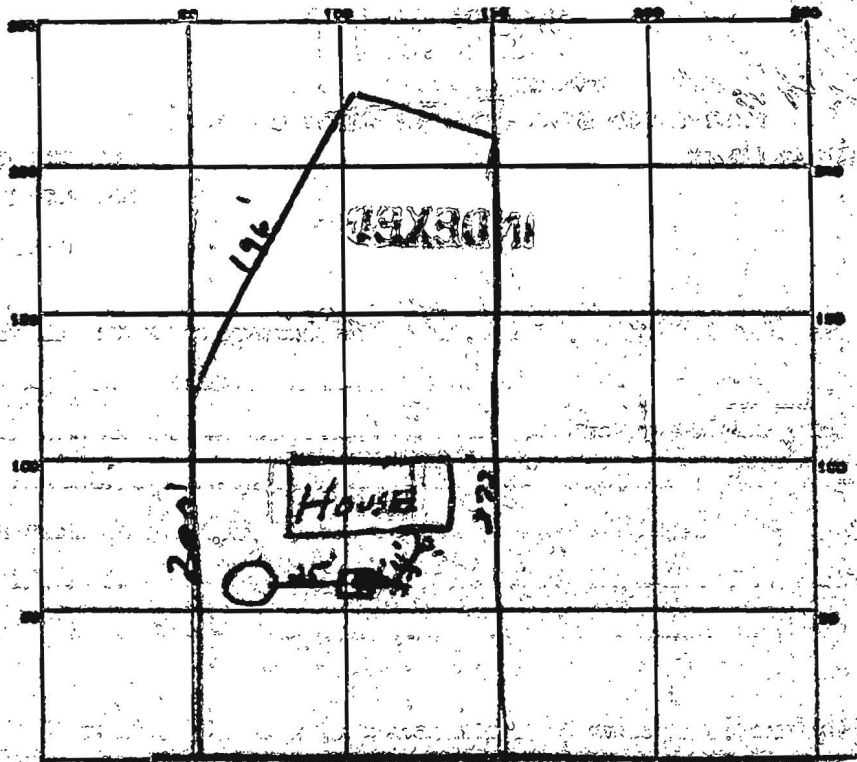

INDICATE NORTH - NAME ADJOINING ROADS OR AS BOUNDARY LINE

PERMIT CARD None seen

SEPTIC TANK LEVEL 75 gal waste CLEANOUTS \_\_\_\_\_

DISTRIBUTION BOX LEVEL \_\_\_\_\_

TILE FIELD, DEPTH \_\_\_\_\_ FT. TRENCH WIDTH \_\_\_\_\_ FT.

GRAVEL DEPTH \_\_\_\_\_ IN. TOTAL LENGTH \_\_\_\_\_ FT.

NUMBER OF TRENCHES \_\_\_\_\_ TOTAL BOTTOM AREA \_\_\_\_\_

SEWAGE PITS, INSIDE DIAMETER 9 1/2 FT. DEPTH BELOW INLET 12 1/2 FT.

ABSORBENT AREA \_\_\_\_\_ SQ. FT.

REMARKS Plot about 100 FT. sidewalk area. Latent  
about 30 FT below original grade. About 1/2  
perimeter around dig well has only 1 to 4 inches  
stone. No steel pipe. JH

DATE SYSTEM APPROVED \_\_\_\_\_ INSPECTOR \_\_\_\_\_